


LEGAL DESCRIPTION:
LOT 1 OF CERTIFIED SURVEY MAP NO. 382 BEING PART OF THE NORTHWEST 1/4 OF SECTION 28, TOWNSHIP 2 NORTH, RANGE 16 EAST, IN THE TOWN OF DELAVAN, WALWORTH COUNTY, WISCONSIN. SAID CERTIFIED SURVEY MAP BEING DULY RECORDED AT THE OFFICE OF THE REGISTER OF DEEDS OF WALWORTH COUNTY, WISCONSIN ON JULY 18, 1974 IN VOLUME 2, PAGE 176, AND AS DOCUMENT NO. 680792.



THIS MAP OR PLAT AND THE SURVEY ON WHICH IT IS BASED WAS PREPARED IN ACCORDANCE WITH CHAPTER A-E-7 "MINIMUM STANDARDS FOR PROPERTY SURVEYS" OF THE WISCONSIN ADMINISTRATIVE CODE AND IS MADE FOR THE EXCLUSIVE USE OF THE PRESENT OWNER(S) OF THE PROPERTY AND ALSO FOR THOSE WHO PURCHASE, MORTGAGE, OR GUARANTEE TITLES THERETO WITHIN ONE(1) YEAR FROM THE DATE HEREOF.

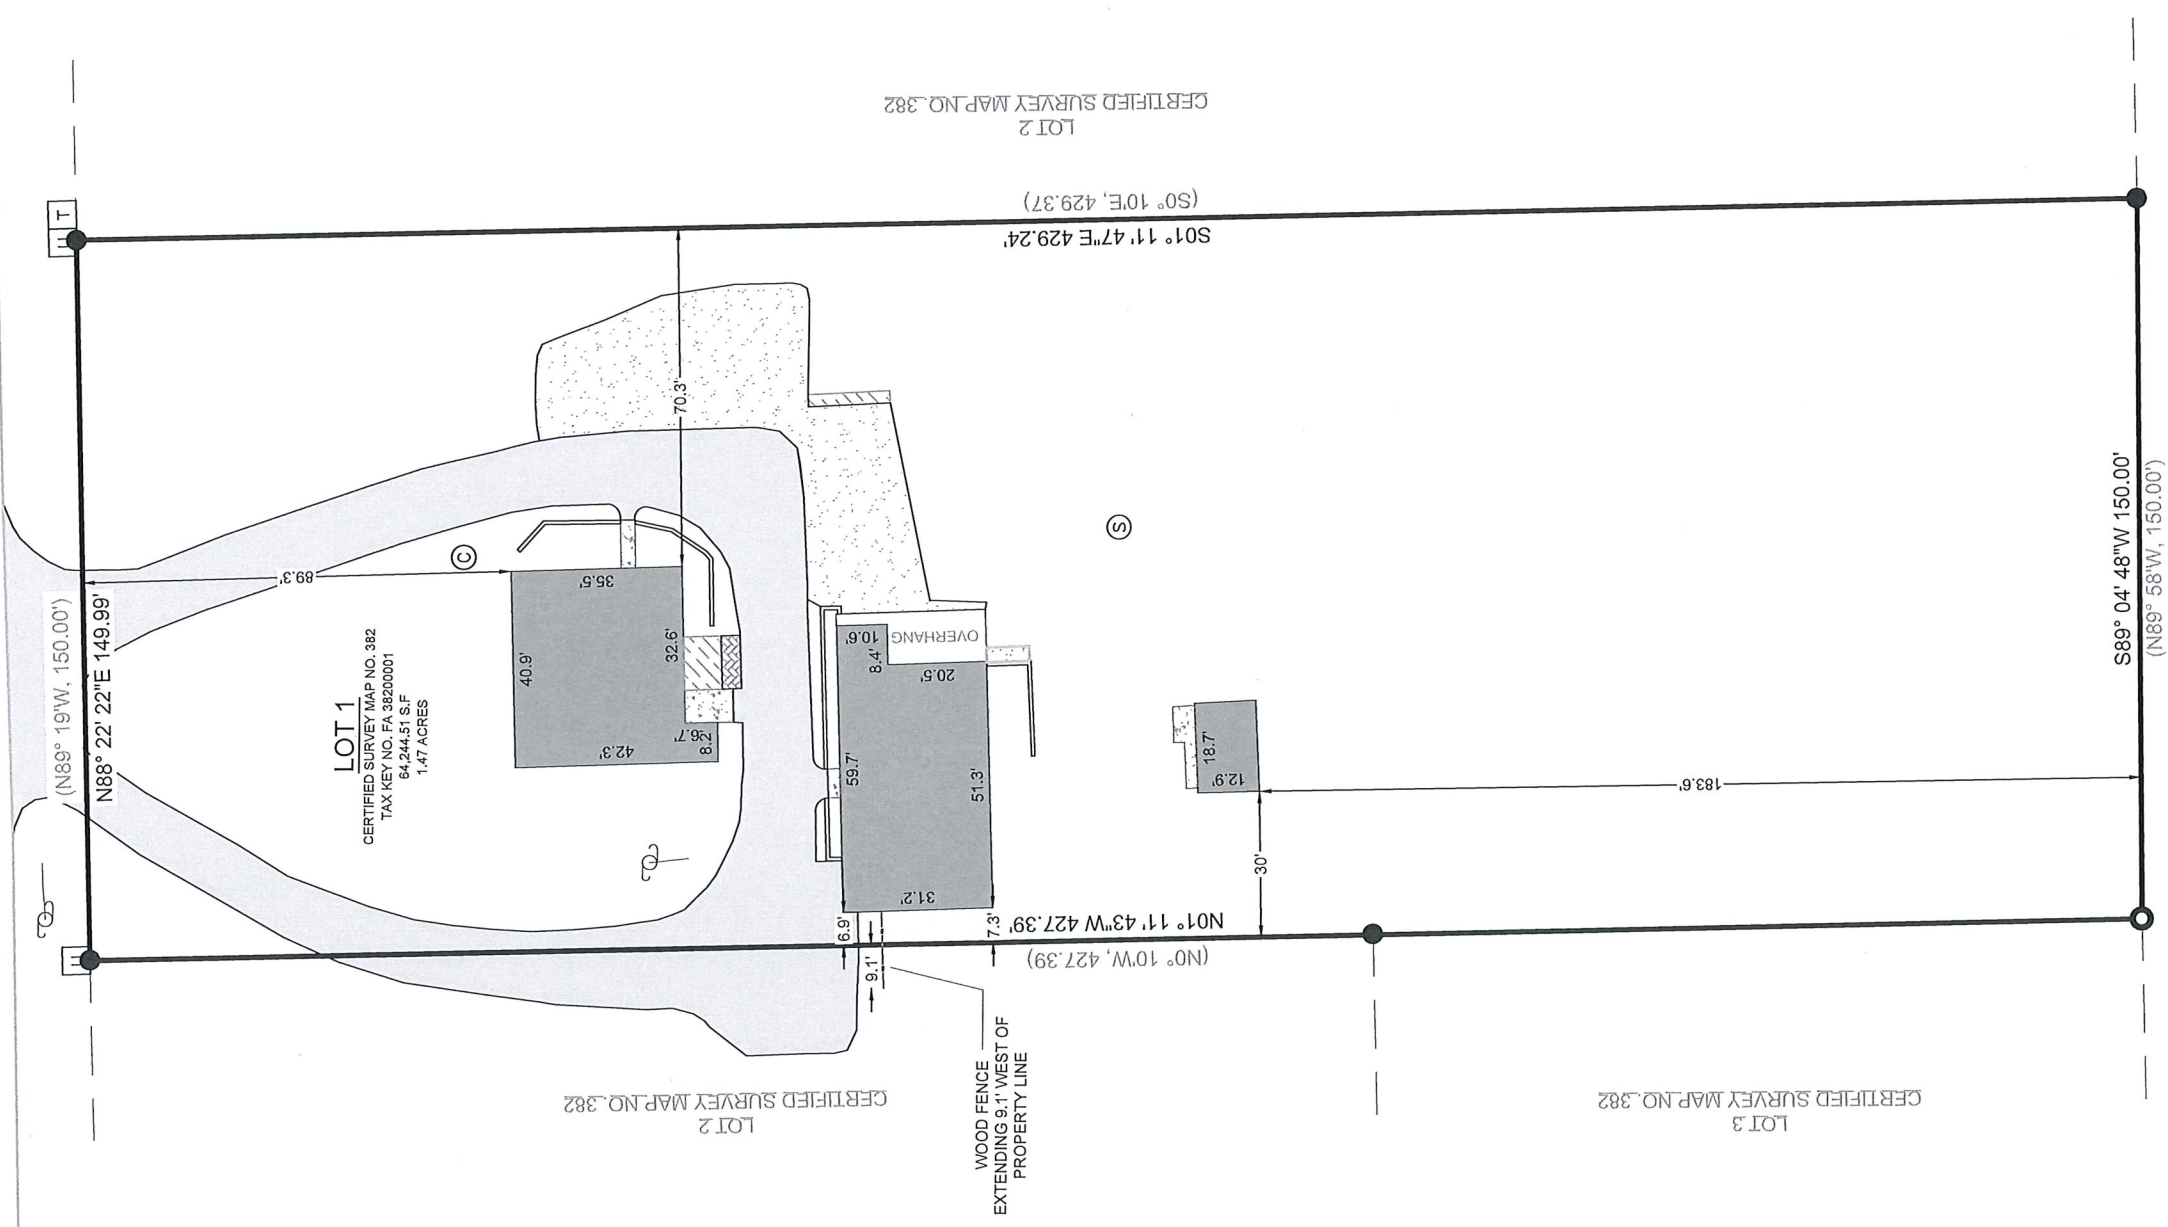

CARDINAL
PLAN | SURVEY | ENGINEER
526 S WELLS STREET,
LAKE GENEVA, WI 53147
262-757-8776
PLANSURVEYENGINEER.COM

DATE: 04 / 30 / 2025
SHEET 1 OF 1

G:\Shared drives\2021-2025 Projects\2025\25196 - 1907 Linn Rd\DWG\BASE\25196P.dwg

PLOTTED: 4/30/2025 12:55:09 PM