


PLAT OF SURVEY – POOL AS-BUILT LOT 2 OF GLEN EYRIE SUBDIVISION

LOCATED IN PART OF THE NW 1/4 OF THE SW 1/4 OF SECTION 28, TOWN 2 NORTH, RANGE 16 EAST,
TOWN OF DELAVAN, WALWORTH COUNTY, WISCONSIN

LEGEND
○ = IRON PIPE FOUND 1 3/8" O.D.
● = IRON REBAR FOUND 3/4" O.D.

ASSIGNED EAST LINE OF LOT 2
S 00°00'00" E

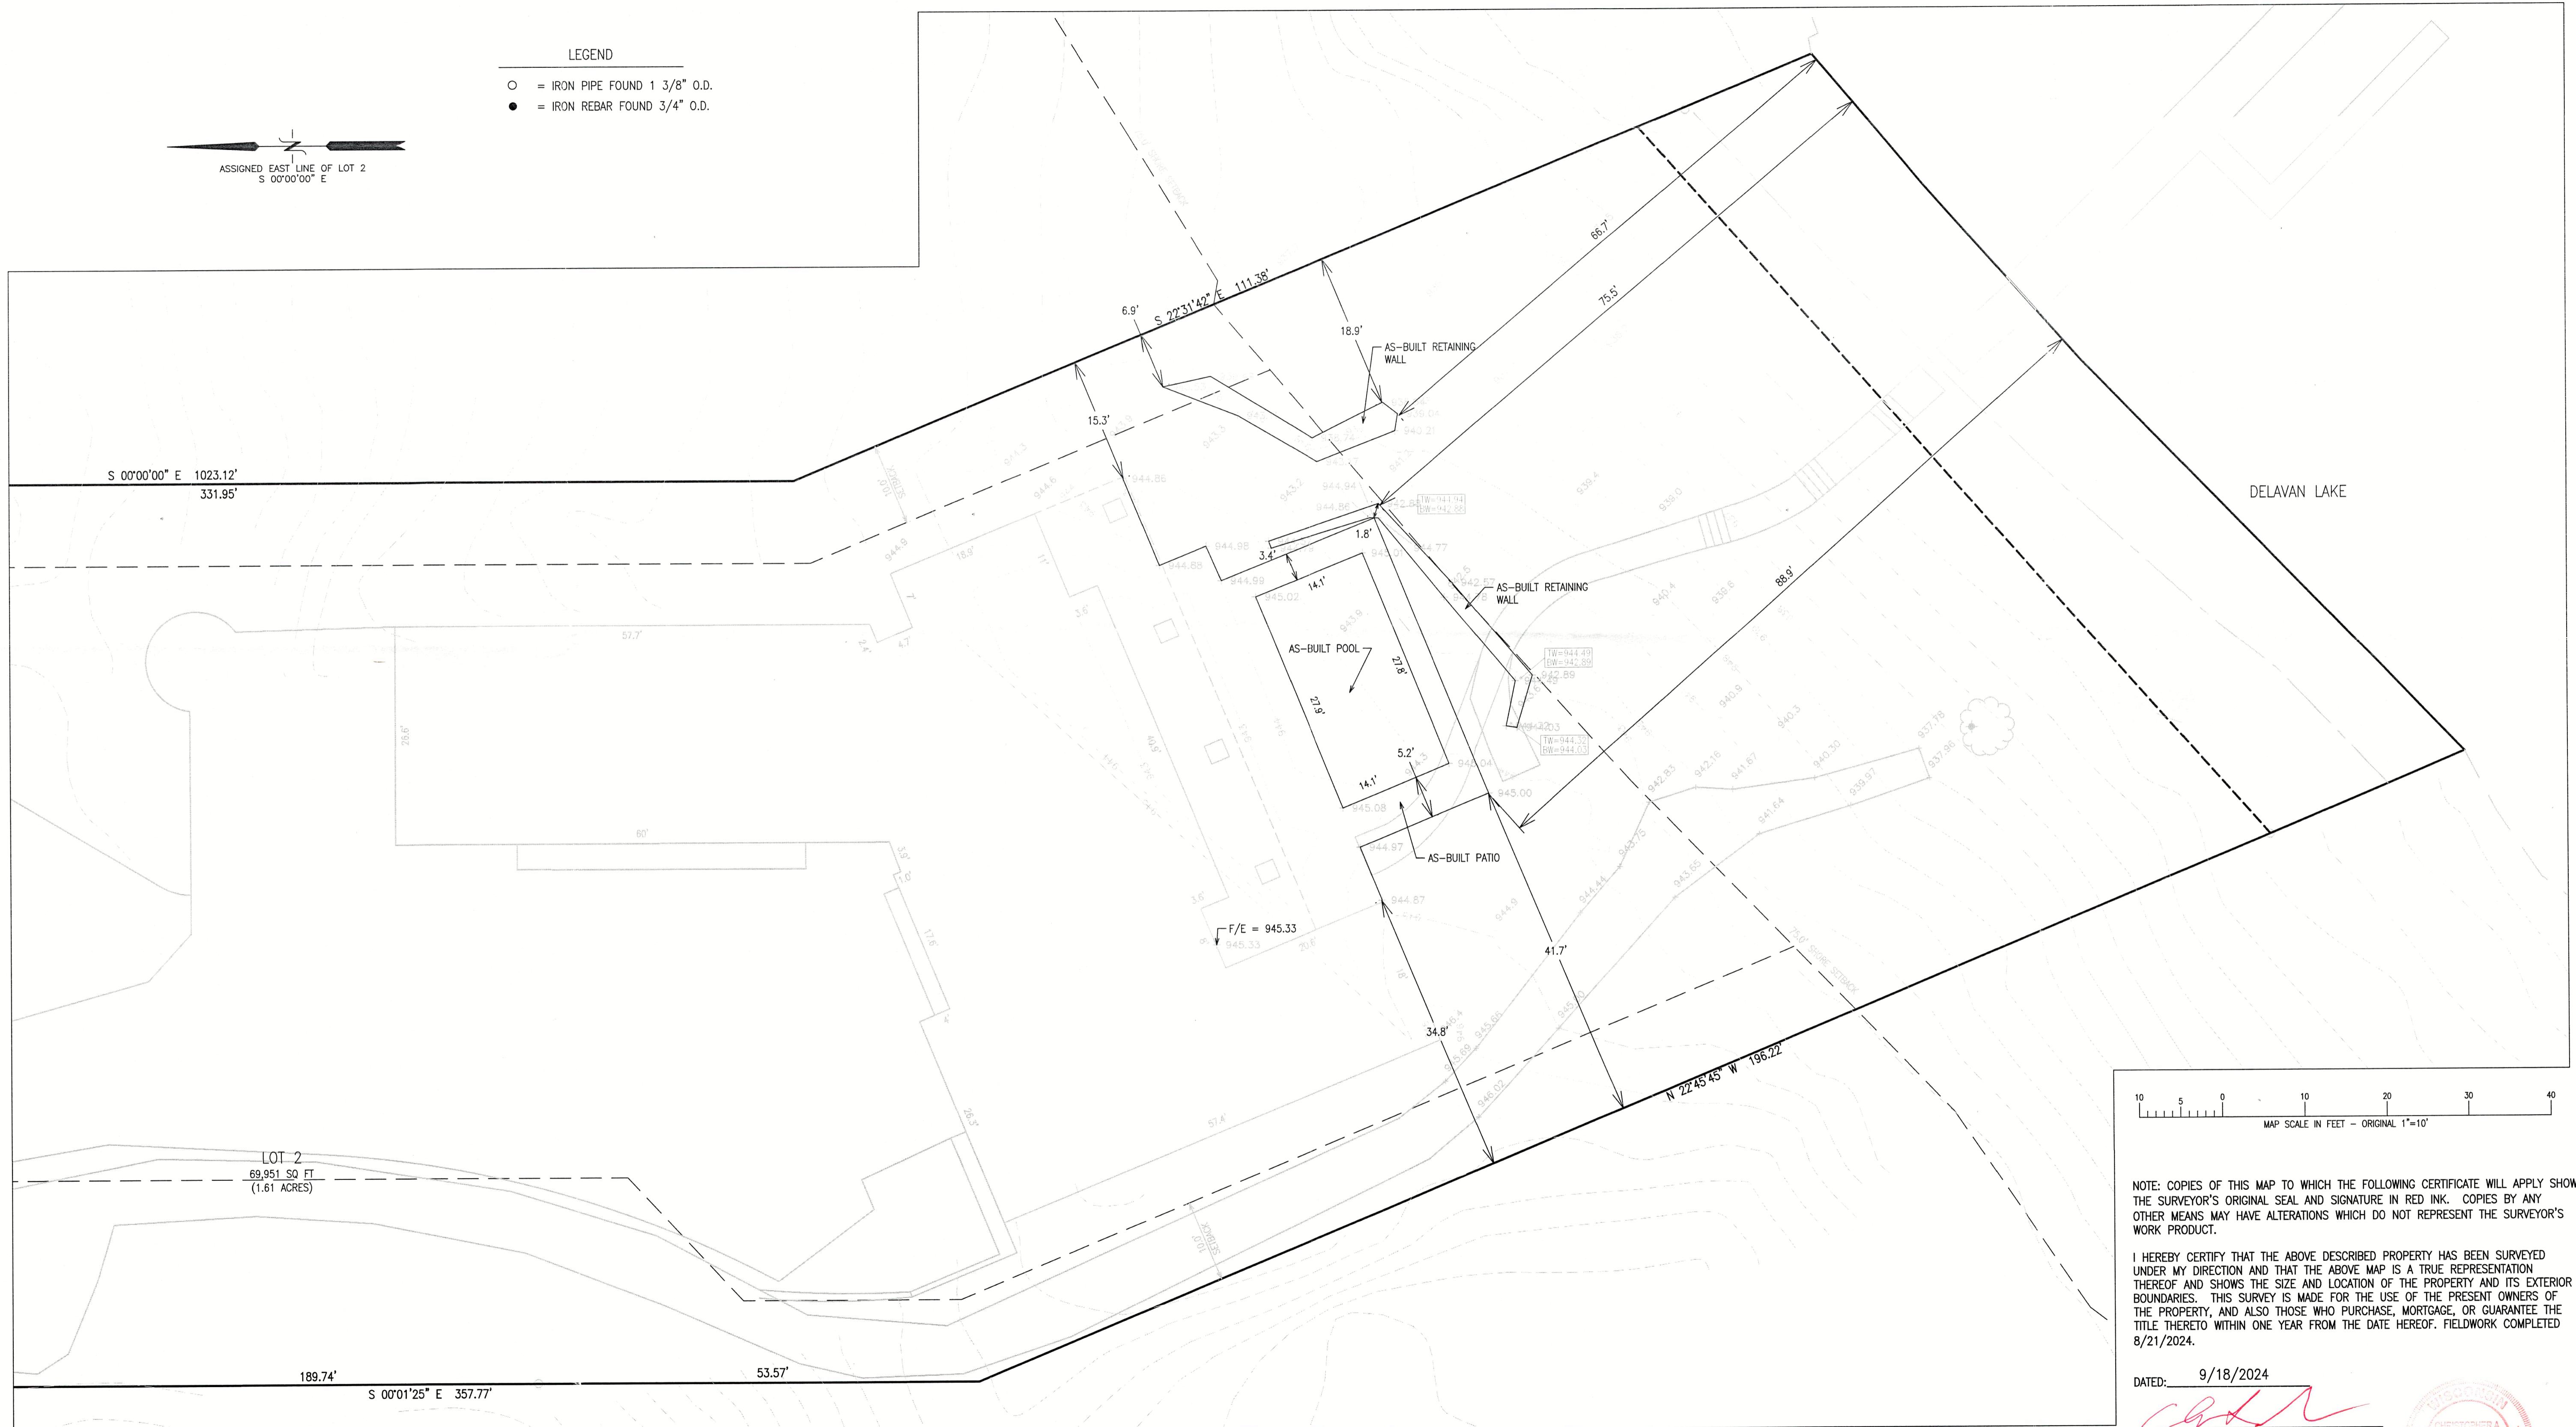

CHRISTOPHER A. HODGES P.L.S. 2760
9/18/2024



HUBERTZ RESIDENCE
2568 NORTH SHORE DRIVE
DELAVAL, WI 53115

FARRIS, HANSEN & ASSOCIATES, INC.

ENGINEERING – ARCHITECTURE – SURVEYING
7 RIDGEWAY COURT P.O. BOX 437
ELKHORN, WISCONSIN 53121
OFFICE: (262) 723-2098

HUBERTZ RESIDENCE
2568 NORTH SHORE DRIVE
DELAVAL, WI 53115

REVISIONS
11/04/2024 – DHC
ADDED SHOP & DRIVE
CORRECTED CONTOURS
11/06/2024 – DHC
ADDED NEW IMPERVIOUS
07/07/2025 – KK
As-built pool and patio

PROJECT NO.
9645
DATE
1/17/2017
SHEET NO.
1 OF 1