

**PLAT OF SURVEY**

 OF LOTS 1 AND 2, BLOCK C, DELAVAL LAKE ASSEMBLY GROUNDS,  
 BEING PART OF THE NW 1/4 OF THE SE 1/4 OF SECTION 21,  
 TOWNSHIP 2 NORTH, RANGE 16 EAST, OF THE 4TH P.M.,  
 TOWN OF DELAVAL, WALWORTH COUNTY, WISCONSIN.

**SURVEYOR'S NOTE**

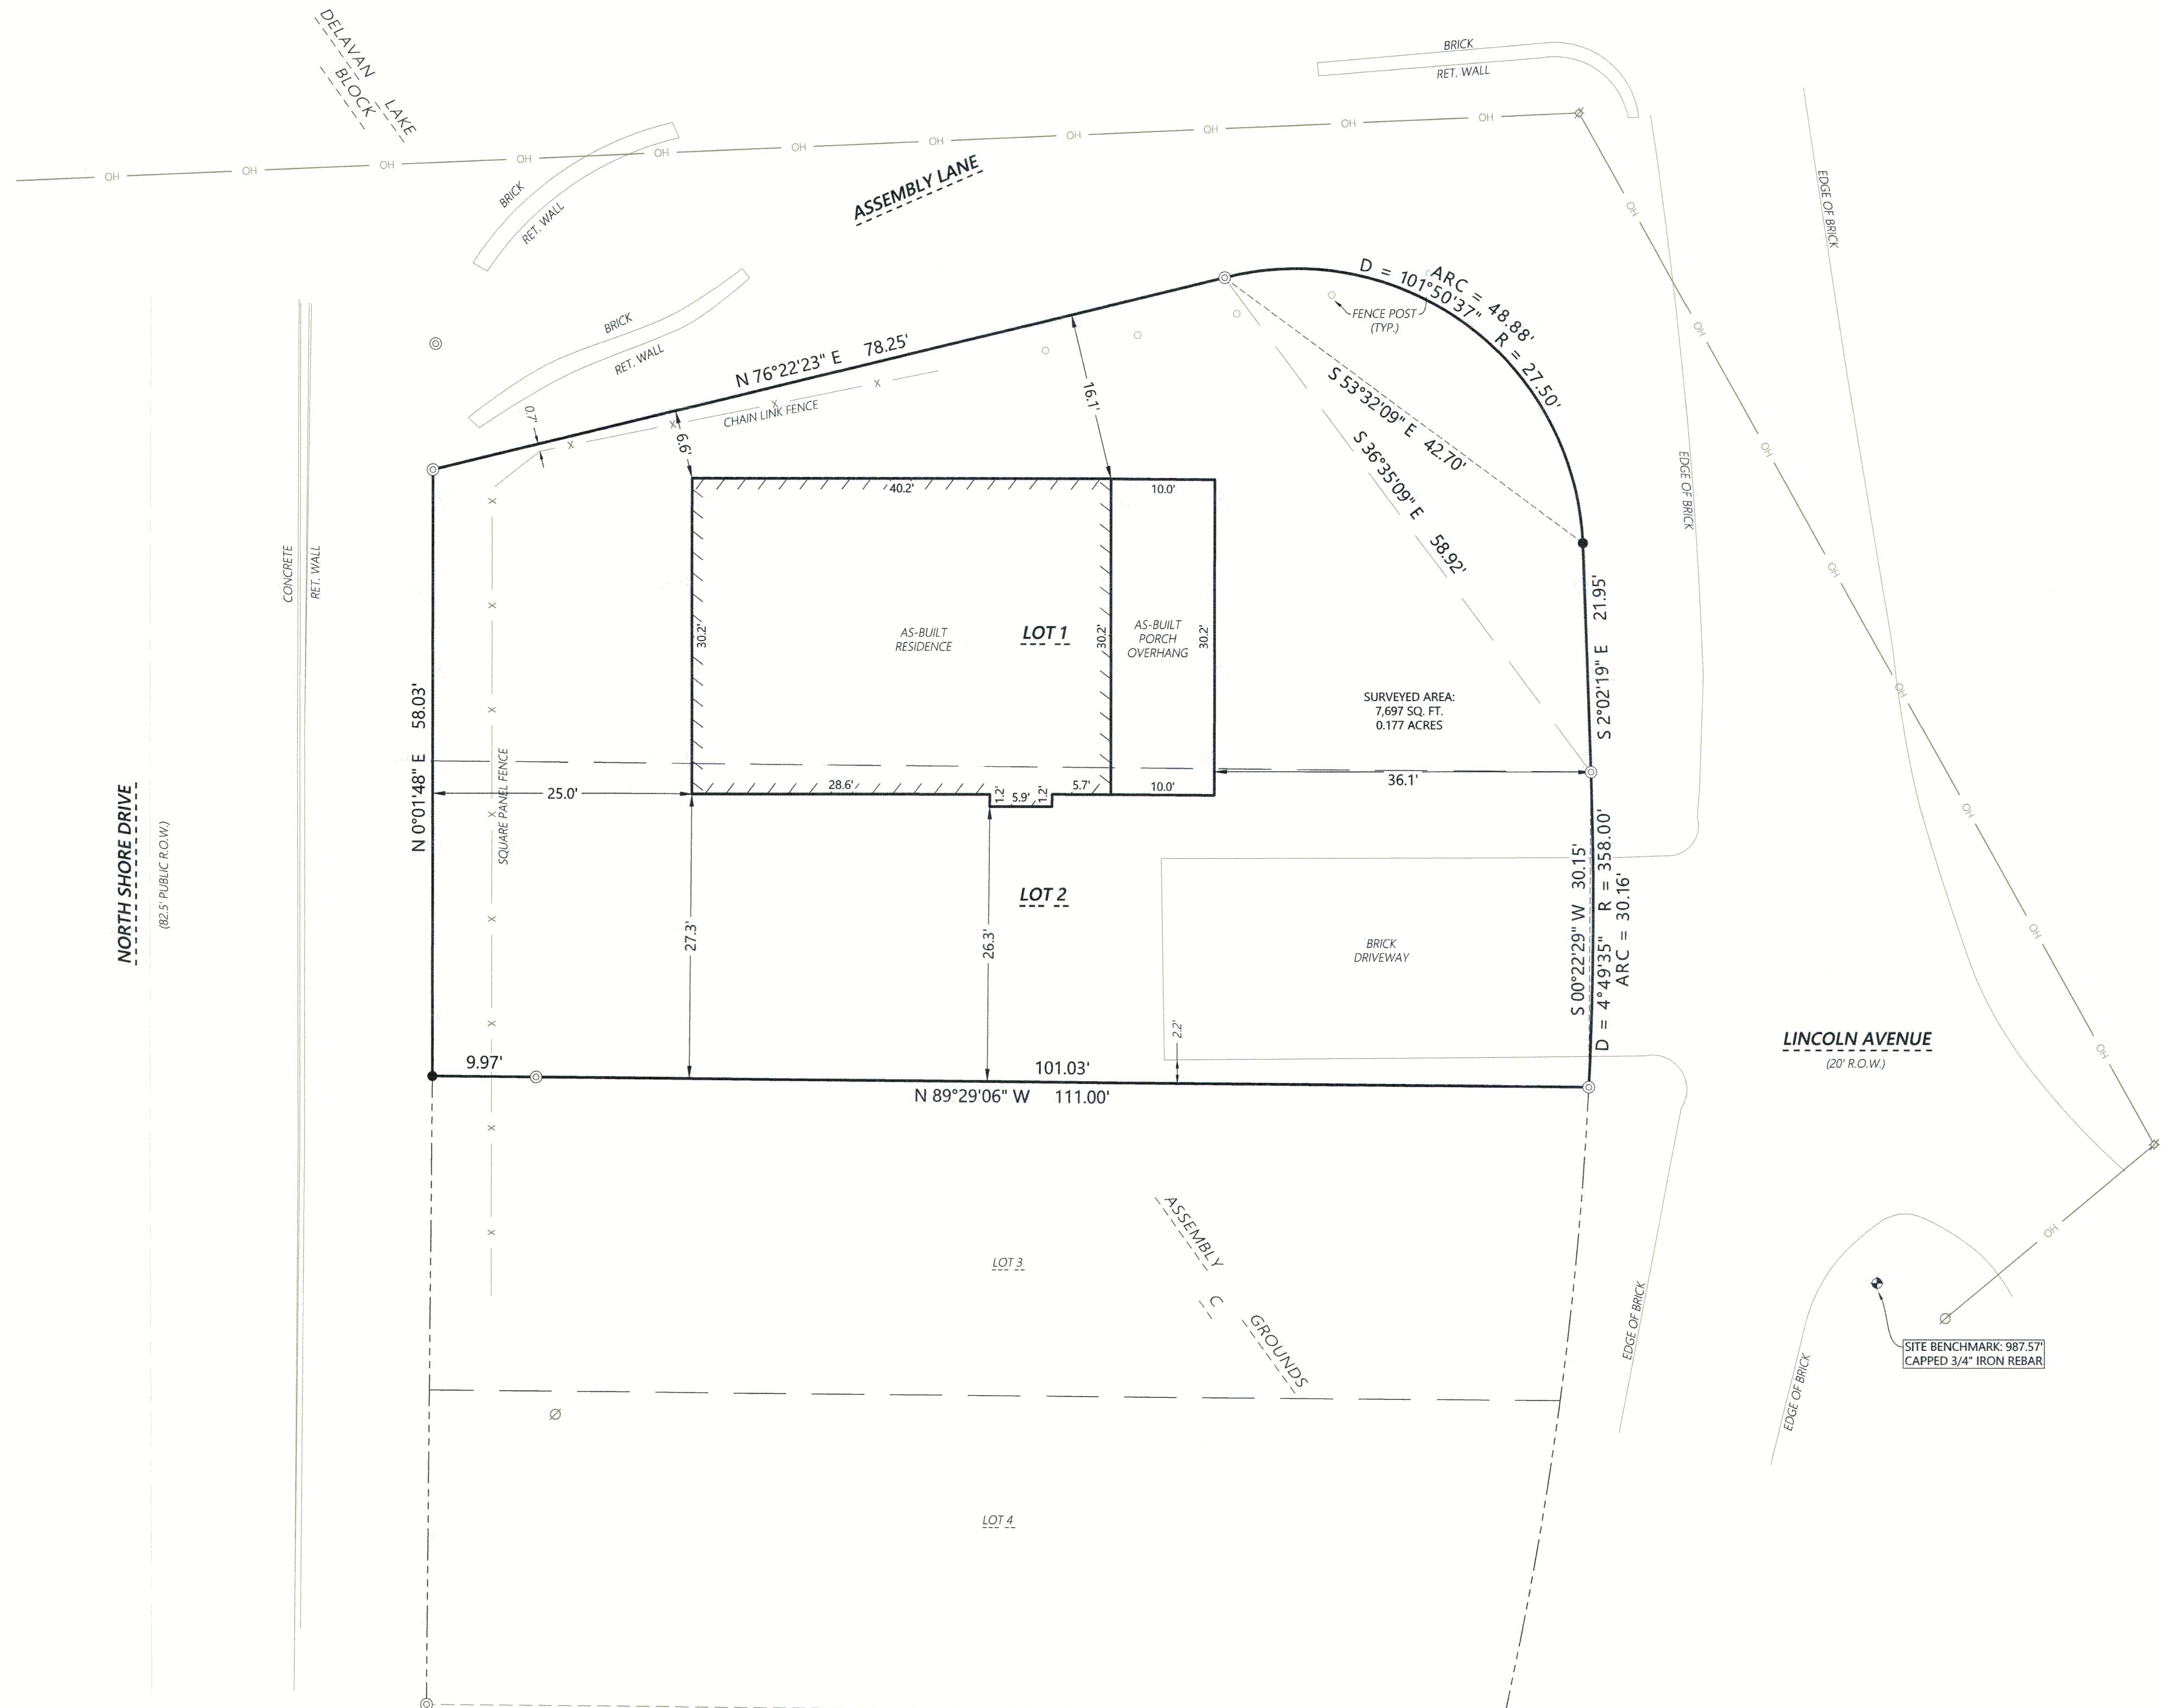
 THERE IS NO CURVE DATA ON THE ORIGINAL PLAT  
 OF DELAVAL LAKE ASSEMBLY GROUNDS. THE  
 NORTHEASTERLY LINE OF LOT 1, BLOCK "C" WAS  
 ESTABLISHED BY SCALING OFF THE ORIGINAL PLAT  
 AND IS PREVIOUSLY SURVEYED BY DAVID ABELL  
 DATED JUNE 8, 2006 AND ROBERT J. WETZEL, DATED  
 JUNE 17, 2019 AS SHOWN.

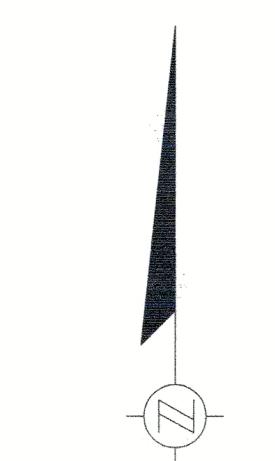
**MONUMENT KEY**

- Iron Rebar Set  
3/4" x 24"(1.5 Lbs./Rt.)
- ◎ 1" Iron Pipe Found  
(XXX,XX)
- ◆ Record Information
- ◆ Benchmark

**LEGEND**

- Existing Boundary Line
- - - Existing Right-of-Way
- Existing Fence


**DIGGERS HOTLINE**  
 Dial 811 or (800) 242-8511  
 www.DiggersHotline.com

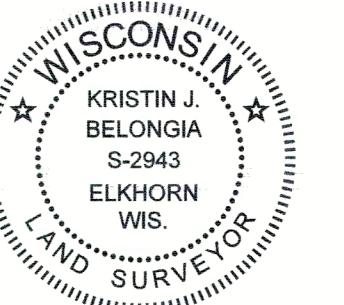
 DIGGERS HOTLINE TICKET NUMBER  
 2024260550  
 START DATE: 6-27-2024 @ 5:30 P.M.

 DISTANCE UNITS BASED ON THE UNITED STATES SURVEY FOOT  
 BEARINGS BASED ON THE WISCONSIN COORDINATE REFERENCE  
 SYSTEM, WALWORTH ZONE. THE SOUTH LINE OF LOT 2 BEARING  
 N 89°29'06" W 111.00'.

**EASEMENT NOTE**

 SURVEYED PROPERTY SUBJECT TO ANY AND ALL  
 EASEMENTS AND AGREEMENTS RECORDED AND  
 UNRECORDED.

 FOR THE EXCLUSIVE USE OF:  
 Scott & Darlene Kolinski  
 21221 Lakeview Court  
 Frankfort, IL 60423  
 VERTICAL DATUM BASED ON NAVD-88 (2012)  
 GEOD 18 WISCONSIN  
 DRAWN BY: BMR  
 SHEET 1 OF 1  
 ORDER NO: 35129  
 FIELD NUMBER: 35129  
 DRAWN BY: BMR  
 SHEET 1 OF 1  
 PUBLISHED ELEVATION: 965.36'  
 2024060550

Kristin J. Belongia


 Kristin J. Belongia, P.L.S.  
 Wisconsin Professional Land Surveyor S-2943

 If the surveyor's signature is not red in color,  
 the plan is a copy that should be assumed to  
 contain unauthorized alterations.  
 The certification contained on this document  
 shall not apply to any copies.

 I hereby certify that I have supervised the survey of the property described above and to the best  
 of my knowledge and belief, the plat drawn hereon complies with Chapter A-E 7 of the State of  
 Wisconsin Administrative Code, Minimum Standards for Property Surveys and correctly  
 represents said survey and its location.  
 Given under my hand and seal this 2nd day of July, 2024 at Beloit, Wisconsin.  
 Last day of field work June 28th, 2024

 Revised this 5th day of December, 2024 to show site layout, grading, and erosion control  
 Revised to show As-Built Residence April 8th, 2025  
 Revised to show As-Built Porch Overhang July 1st, 2025