



LOCATION: 1822 North Shore Drive,
 Delavan, Wisconsin
 PREPARED FOR: Matusik Builders
 PROPERTY DESCRIPTION:
 LOT 1 OF CERTIFIED SURVEY MAP NO. 304, RECORDED WITH THE REGISTER OF
 DEEDS IN AND FOR WALWORTH COUNTY, ON NOVEMBER 2, 1973, IN VOLUME 2,
 PAGE 71, AS DOCUMENT NO. 671871, BEING A PART OF LOTS 1, 2 AND 3 IN
 MABIE WOOD, A SUBDIVISION OF THE SOUTHEAST 1/4 OF SECTION 21,
 TOWNSHIP 2 NORTH, RANGE 16 EAST, SAID LAND BEING IN THE TOWN OF
 DELAVAN, COUNTY OF WALWORTH, AND STATE OF WISCONSIN.
 TAX ID: FA 300400001

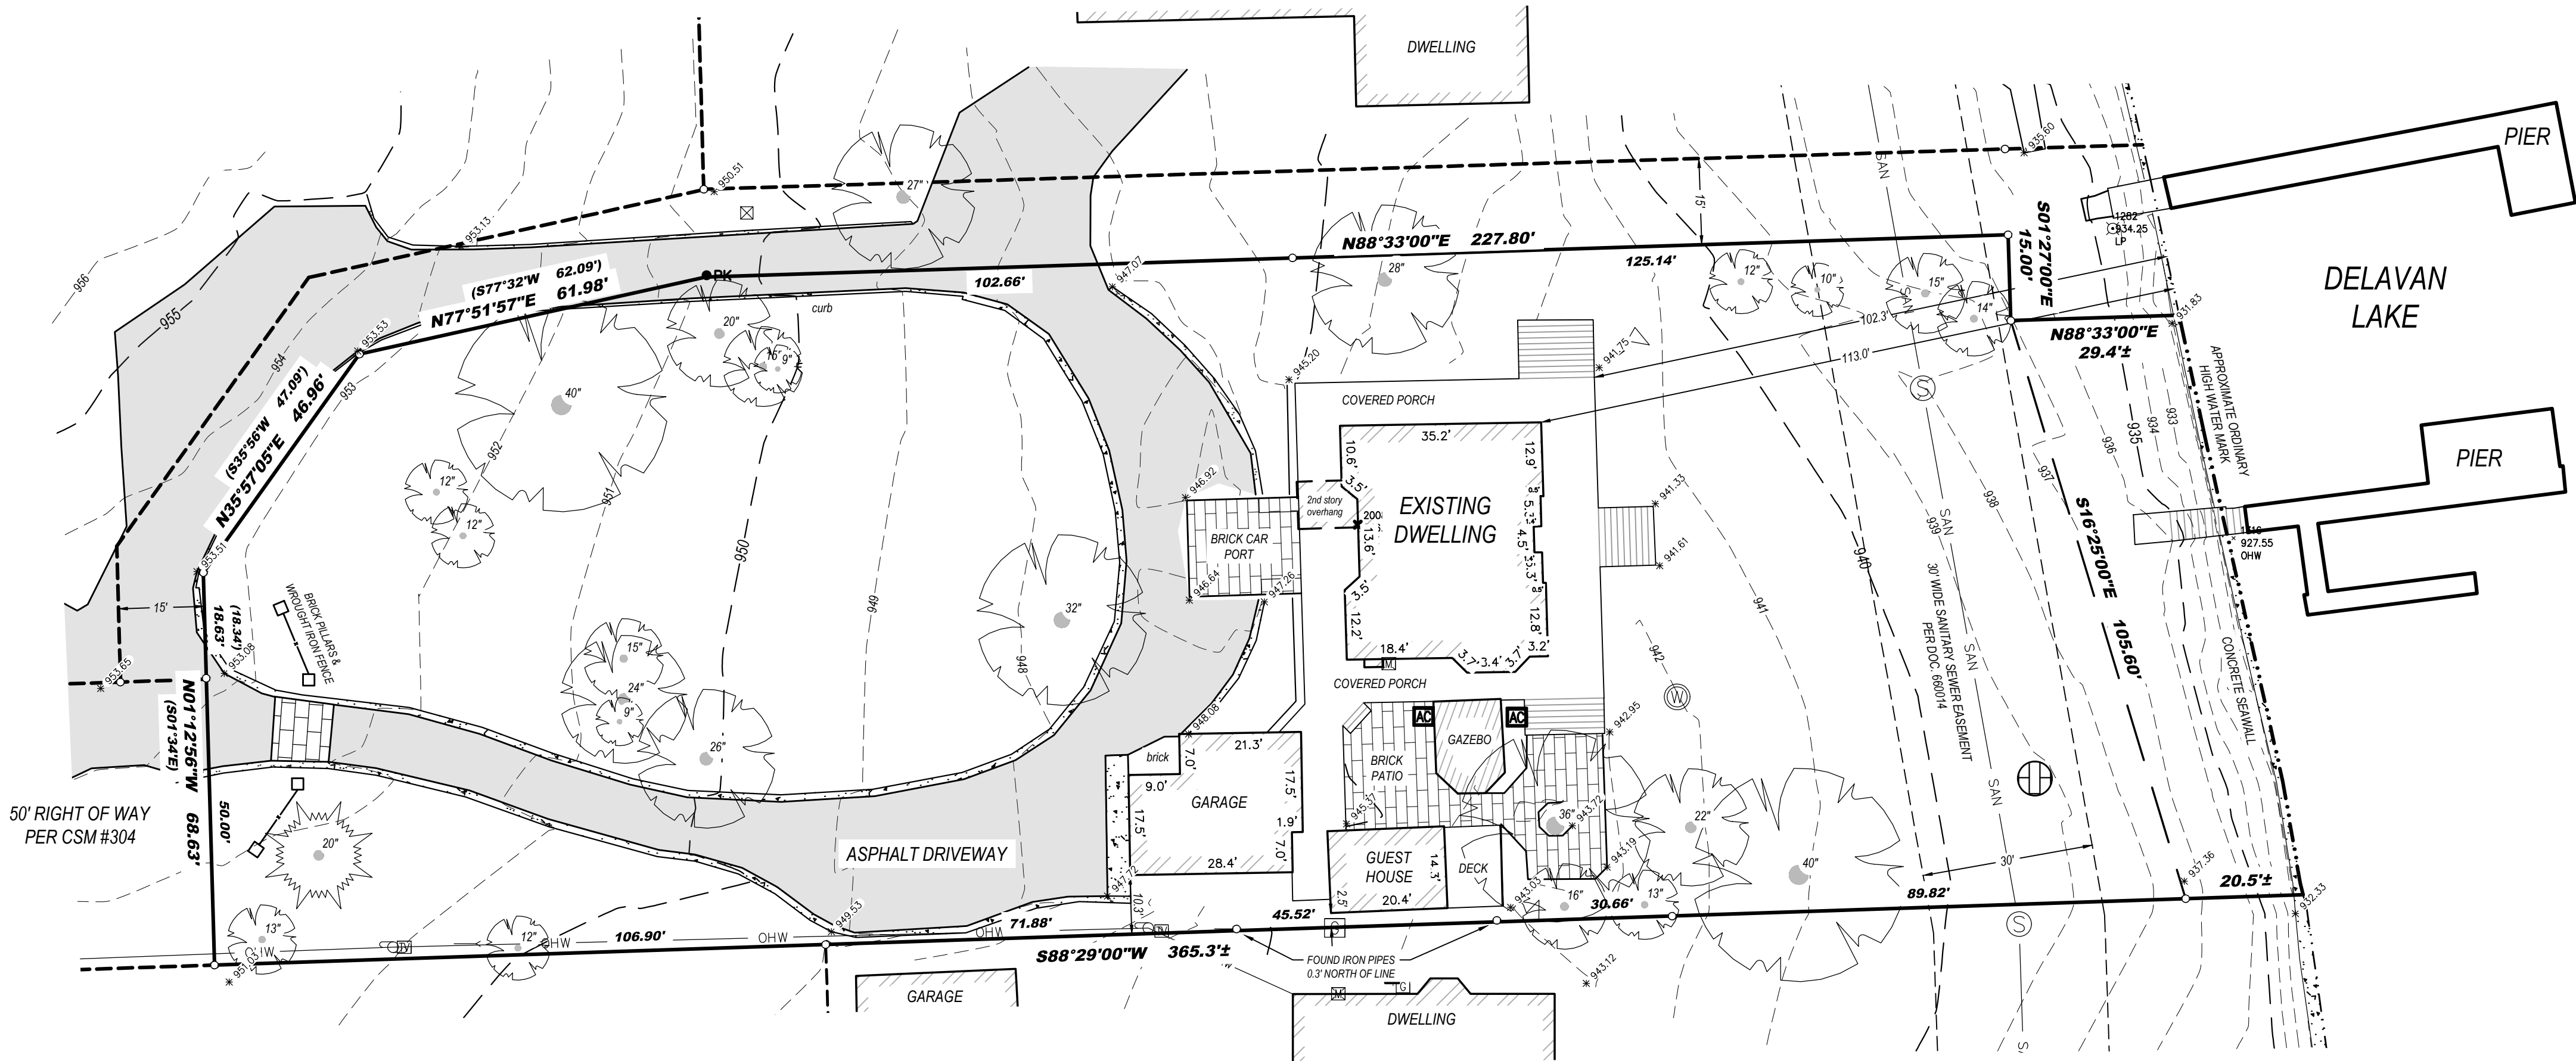

- Legend:**
- Found Iron Pipe
 - PK Found PK Nail
 - Utility Pole
 - Guy Anchor
 - ⊗ Light Pole
 - ⊞ Electric Meter
 - AC Air Conditioner
 - TV TV Pedestal
 - ⊠ Utility Pedestal
 - ⊙ Sanitary Manhole
 - ⊕ Well
 - ⊞ Gas Meter
 - ⚓ Flag Pole
 - ☪ Coniferous Tree
 - ☪ Deciduous Tree

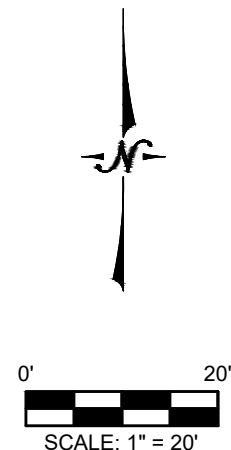

BEARINGS HEREON RELATE TO THE SOUTH LINE OF
 CSM 304; ASSUMED BEARING NORTH 88°29'00\"/>

APPROXIMATE ORDINARY HIGH WATER MARK - FOR
 REFERENCE ONLY PER STATE STATUTE 236.025

*ANY LAND BELOW THE ORDINARY HIGH WATER MARK OF A LAKE OR A NAVIGABLE
 STREAM IS SUBJECT TO THE PUBLIC TRUST IN NAVIGABLE WATERS THAT IS
 ESTABLISHED UNDER ARTICLE IX, SECTION 1, OF THE STATE CONSTITUTION.*

LYNCH & ASSOCIATES
 ENGINEERING CONSULTANTS, LLC
 5000 S. TOWNE DRIVE, SUITE 160
 NEW BERLIN, WI 53151
 440 MILWAUKEE AVENUE
 BURLINGTON, WI 53105
 (262) 402-5040



I certify that I have surveyed the above-described property and in my professional opinion this map is a correct representation thereof and is made in accordance with the records of the register of deeds as nearly as practical and that this survey complies with Wisconsin Administrative code AE-7 except for those items waived, if any, and is bound by Wisconsin State Statute 893.37 that defines statute of limitations in regard to surveys. This survey was prepared for the exclusive use of the client and present owners of the property.

No title policy has been provided to the surveyor regarding the property identified on this map. Therefore this plat of survey does not guarantee the existence, size and location of any easements, encumbrances, restrictions or other facts that could otherwise be disclosed in an ALTA/NSPS survey.

Ritchie P. Wenzel
 Ritchie P. Wenzel, Professional Land Surveyor, S-4027