


PLAT OF SURVEY

OF LOTS 33, 34 AND 35, BLOCK 2, INLET OAKS
SUBDIVISION No. 4, BEING PART OF THE SE 1/4 OF
SECTION 15, T. 2 N., R. 16 E., OF THE 4TH P.M., TOWN
OF DELAVAN, WALWORTH COUNTY, WISCONSIN.

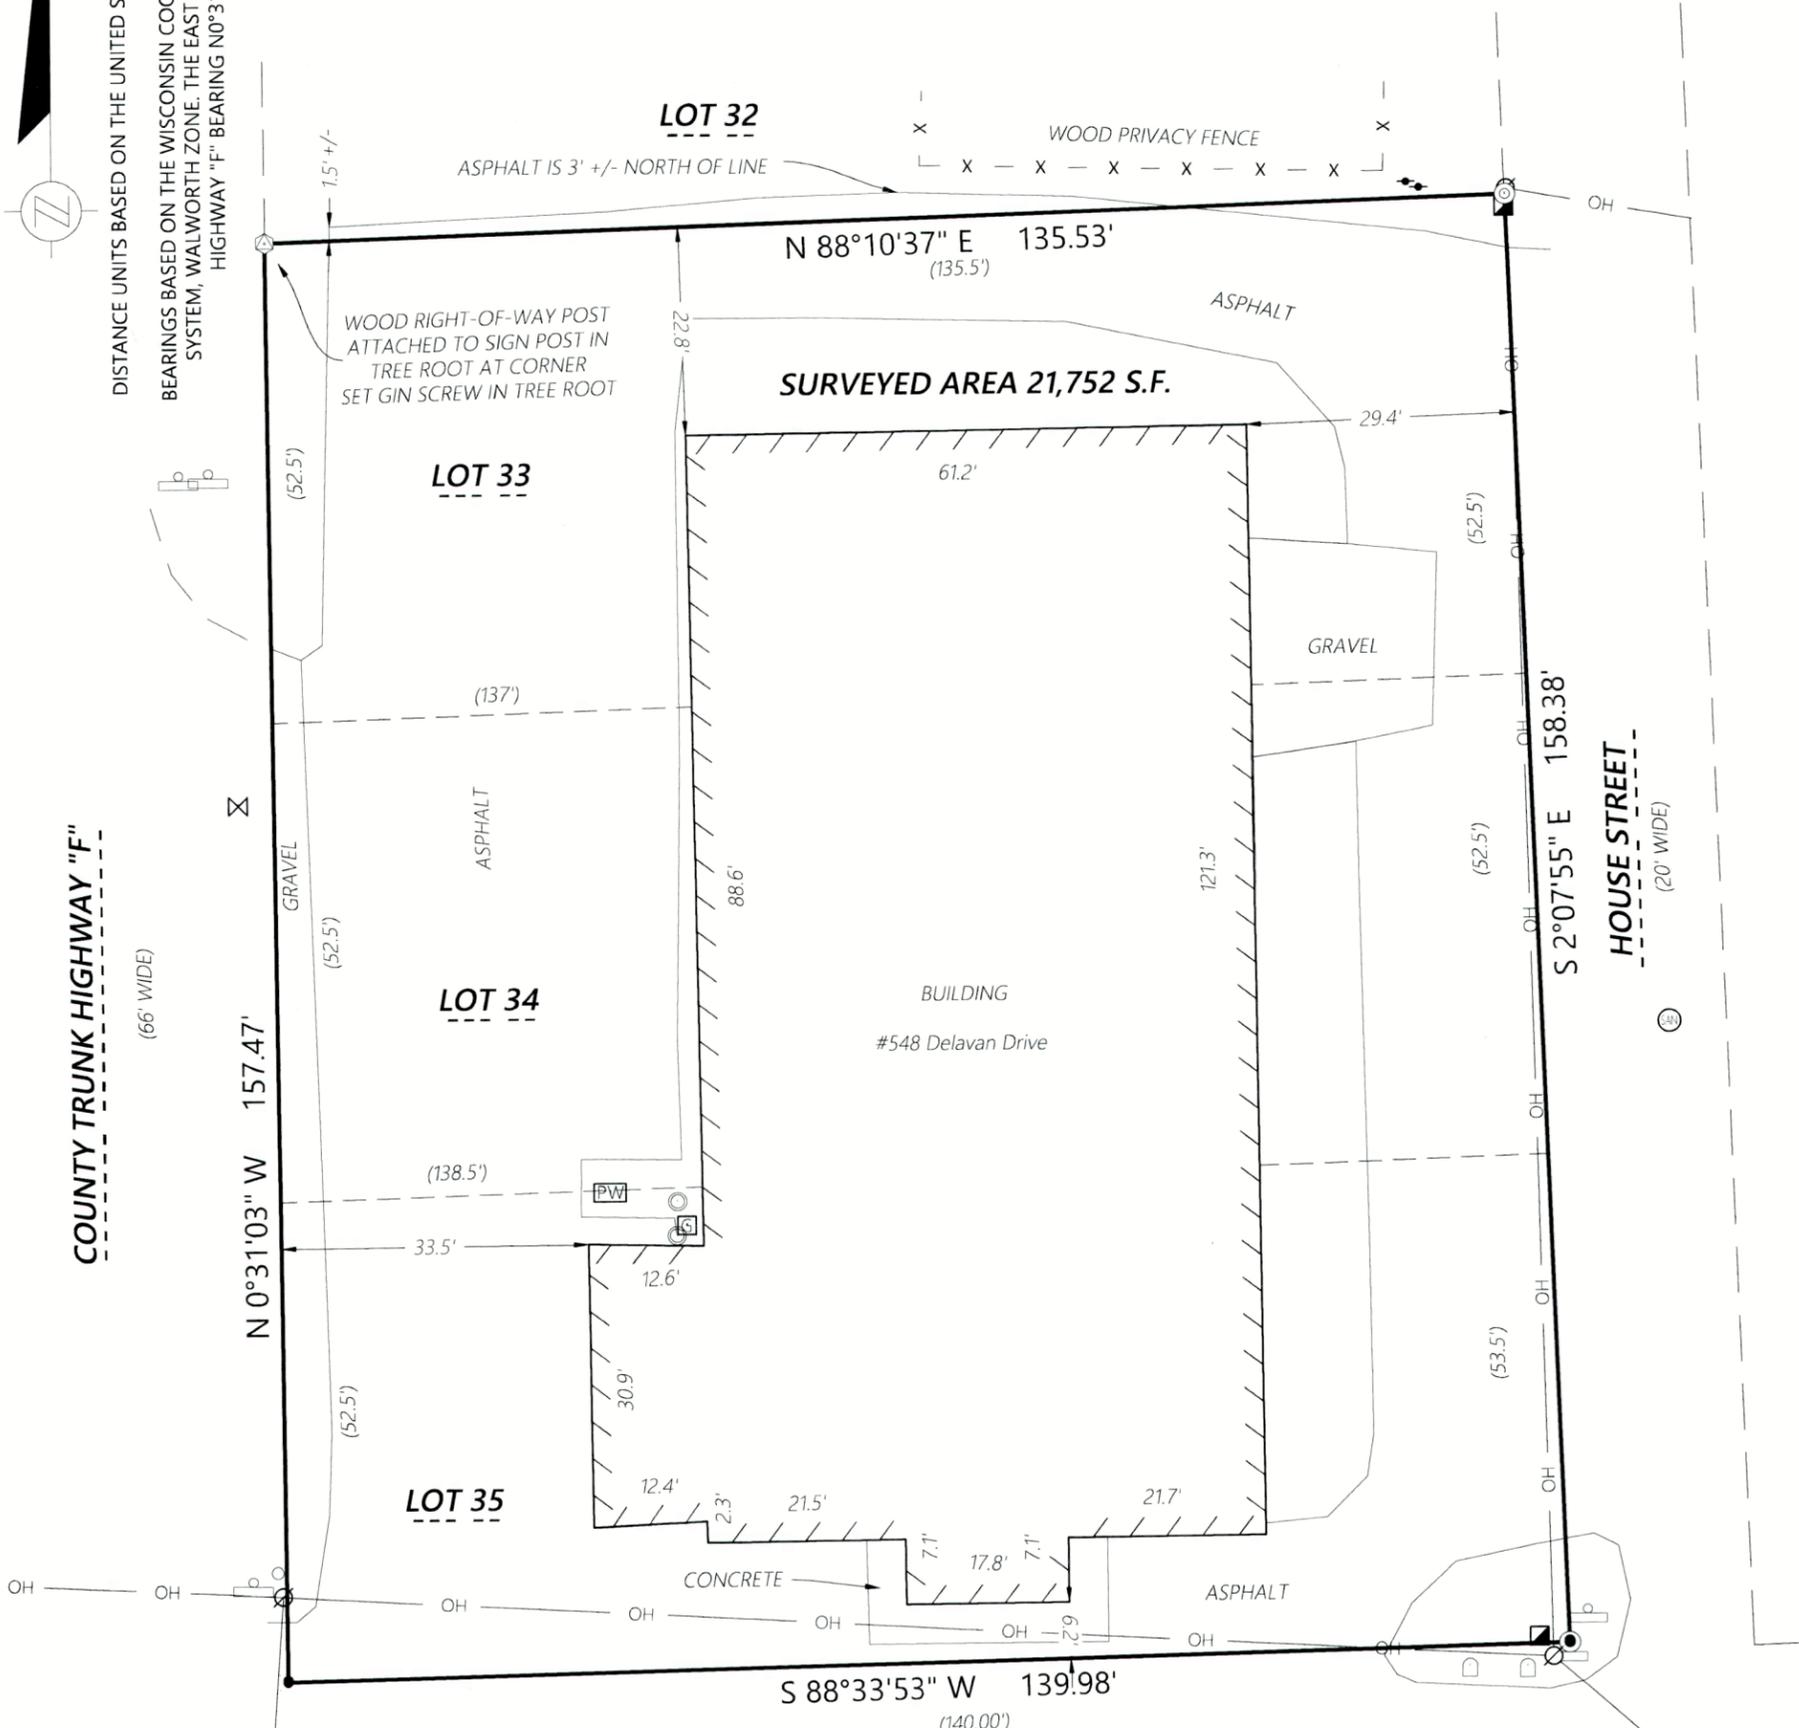

SURVEY NOTES

1. SURVEYED PROPERTY SUBJECT TO ANY AND ALL EASEMENTS AND AGREEMENTS RECORDED AND UNRECORDED.

LEGEND

- ⊗ Existing Gas Valve
- ⊙ Existing Sanitary Manhole
- ⊠ Existing Gas Meter
- ⊞ Existing Well
- ⊙ Existing Guy Wire
- ⊗ Existing Utility Pole
- OH — Existing Overhead Power
- ⊠ Existing Electric Meter
- ⊞ Existing Electric Pedestal
- ⊞ Existing Transformer
- X — Existing Fence
- ⊙ 3/4" Iron Rebar Found
- ⊙ Iron Pipe Found
- Mag Nail Set
- (XXX.XX) Record Information



Kristin J Belongia

Kristin J. Belongia, P.L.S.
Wisconsin Professional Land Surveyor S-2943

State of Wisconsin } ss
County of Walworth }

I hereby certify that I have supervised the survey of the property described above and to the best my knowledge and belief, the plat drawn hereon complies with Chapter A-E 7 of the State of Wisconsin Administrative Code, Minimum Standards for Property Surveys and correctly represents the size and location of the property, exterior boundaries, the location of all visible structures, and dimensions of all principle buildings thereon, fences, easements of record, and roadways, if any. This survey is made for the use of the present owners of the property, and also those who purchase, mortgage, or guarantee the title thereto within one year from the date hereof.

Given under my hand and seal at Elkhorn, Wisconsin this 9TH, DAY OF OCTOBER, 2025.
Last day of field work OCTOBER 7TH, 2025.

If the surveyor's signature is not red in color, the plan is a copy that should be assumed to contain unauthorized alterations. The certification contained on this document shall not apply to any copies.

DELAVAN DRIVE

40' WIDE

Scale: 1" = 20'



ORDER NO: 35734

FIELD CREW: JLK
DRAWN BY: JLK
SHEET 1 OF 1

FOR THE EXCLUSIVE USE OF:

Mac Corey
102 MONTAUGE DR.
FONTANA, WI. 53125

PLAT OF SURVEY

Batterman

engineers surveyors planners
BELOIT | ELKHORN | JANESVILLE
2857 S. Bartells Dr., Beloit, WI 53511
608.365.4464 | www.rhbatterman.com

