

January 27, 2026

# AS-BUILT SURVEY

Survey No. 17.0029.BL3-44

BLOCK 3 - LOT 44  
503 BARNUM LANE


LOCATION: 503 Barnum Lane  
Town of Delavan, Wisconsin

PREPARED FOR: Shodeen Homes

LEGAL DESCRIPTION:  
Lot 44, Block 3, of the Shores of Delavan, a conservation subdivision in Section 15, Township 2 North, Range 16 East, Town of Delavan, Walworth County, Wisconsin.


CURRENT OWNER: Covington Court Apartments LLC

TAX ID: FSDL 00083

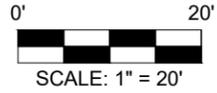

SCALE: 1" = 20'

BEARINGS ARE BASED ON THE WEST LINE OF LOT 44 - BLOCK 3 OF THE SHORES OF DELAVAN LAKE, WHICH IS ASSUMED TO BEAR N 02°41'33" W.

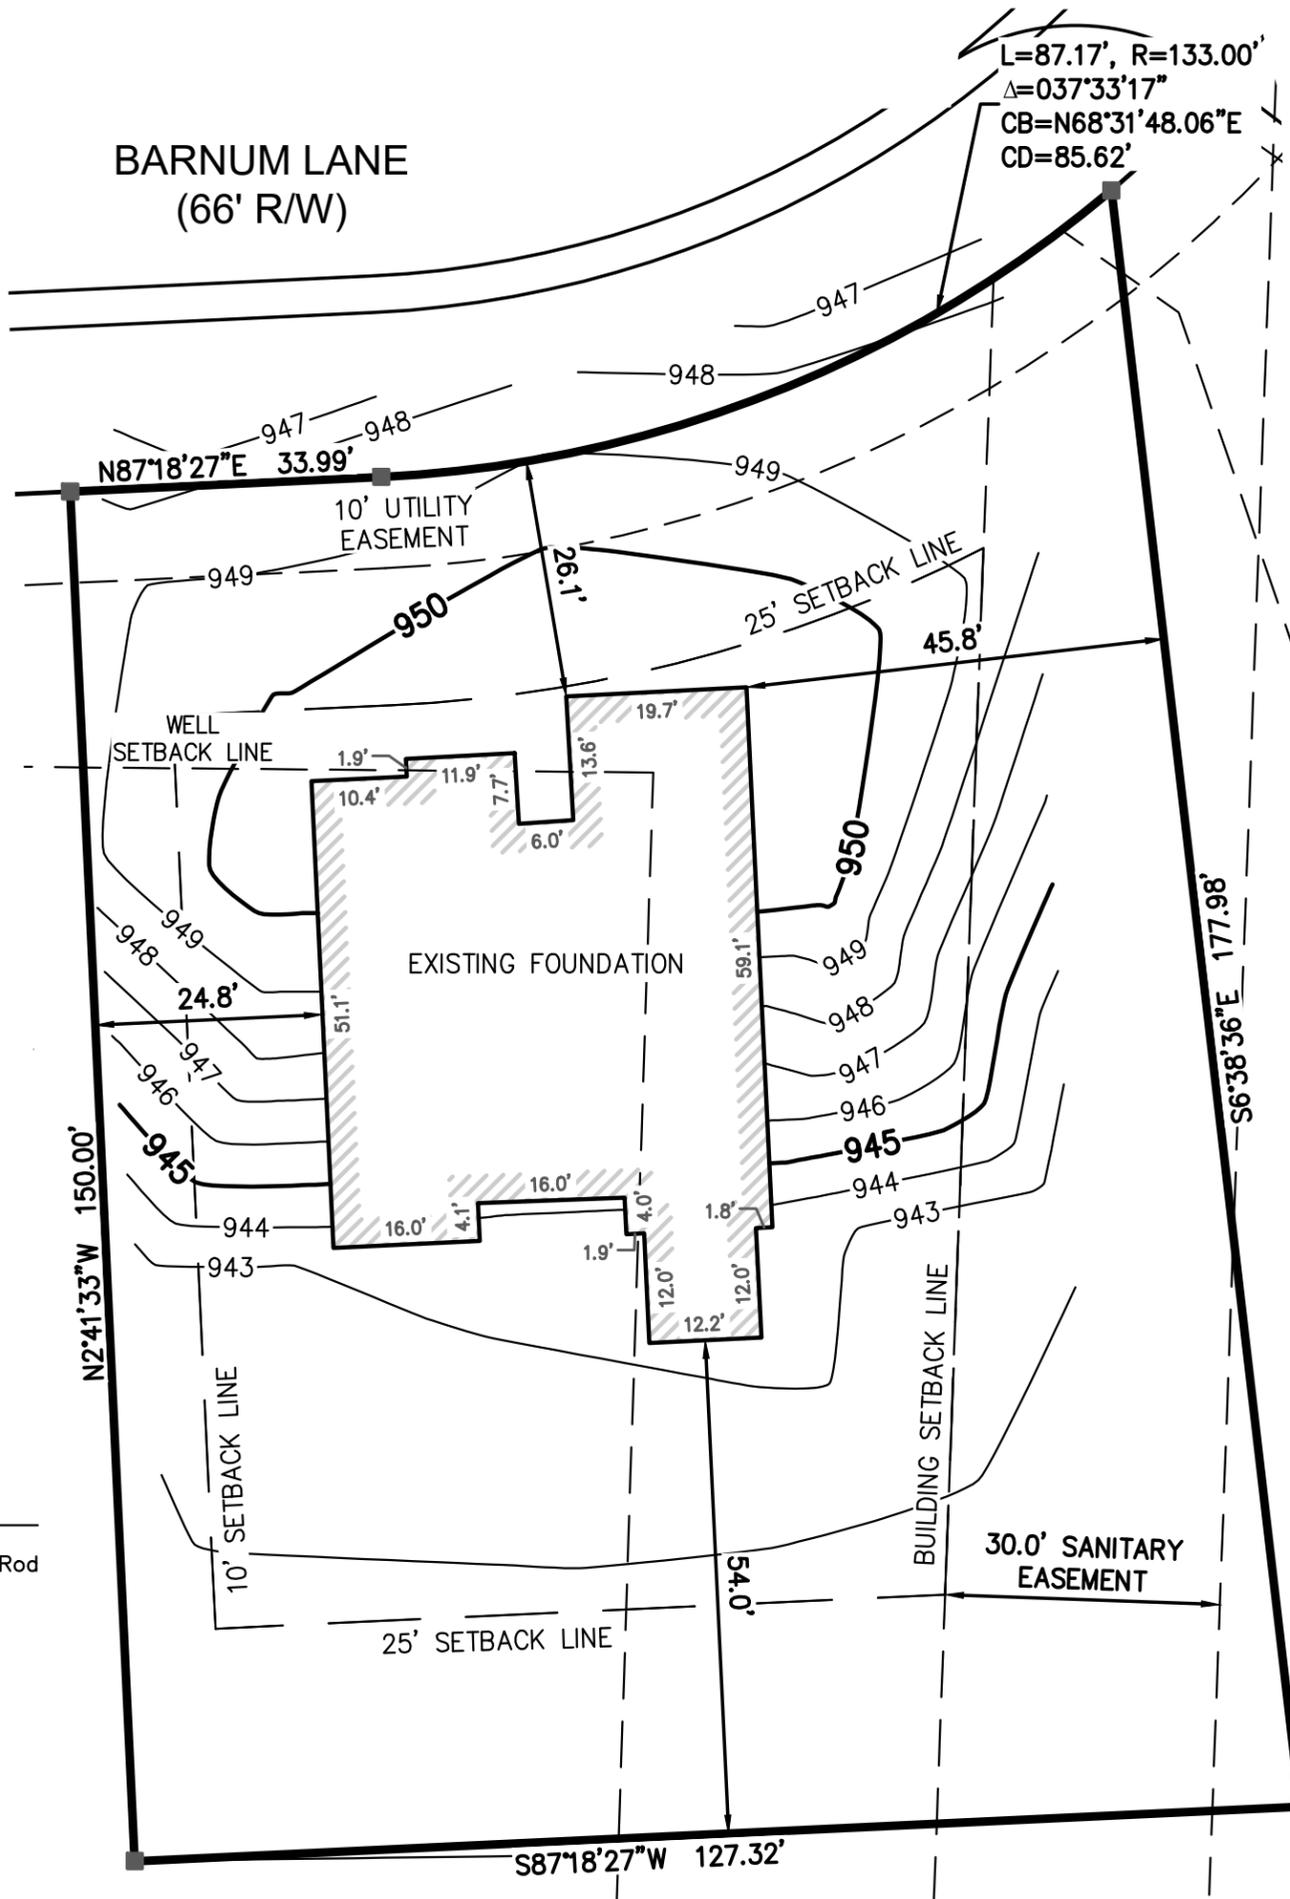

I certify that I have surveyed the above-described property and in my professional opinion this map is a correct representation thereof and is made in accordance with the records of the register of deeds as nearly as practical and that this survey complies with Wisconsin Administrative code AE-7 except for those items waived, if any, and is bound by Wisconsin State Statute 893.37 that defines statute of limitations in regard to surveys. This survey was prepared for the exclusive use of the client and present owners of the property.

No title policy has been provided to the surveyor regarding the property identified on this map. Therefore this plat of survey does not guarantee the existence, size and location of any easements, encumbrances, restrictions or other facts that could otherwise be disclosed in an ALTA/NSPS survey.

  
Ritchie P. Wenzel, Professional Land Surveyor, S-4027

COMPLETION DATE OF  
FIELD WORK: 1/21/26



**LYNCH & ASSOCIATES**  
ENGINEERING CONSULTANTS, LLC  
5482 S. WESTRIDGE DRIVE  
NEW BERLIN, WI 53151  
440 MILWAUKEE AVENUE  
BURLINGTON, WI 53105  
(262) 402-5040



P:\Shared\17-0029-01\Projects\Delavan Lake\The Shores of Delavan Lake\As-Built\17.0029.BL3-44 ASB.dwg