


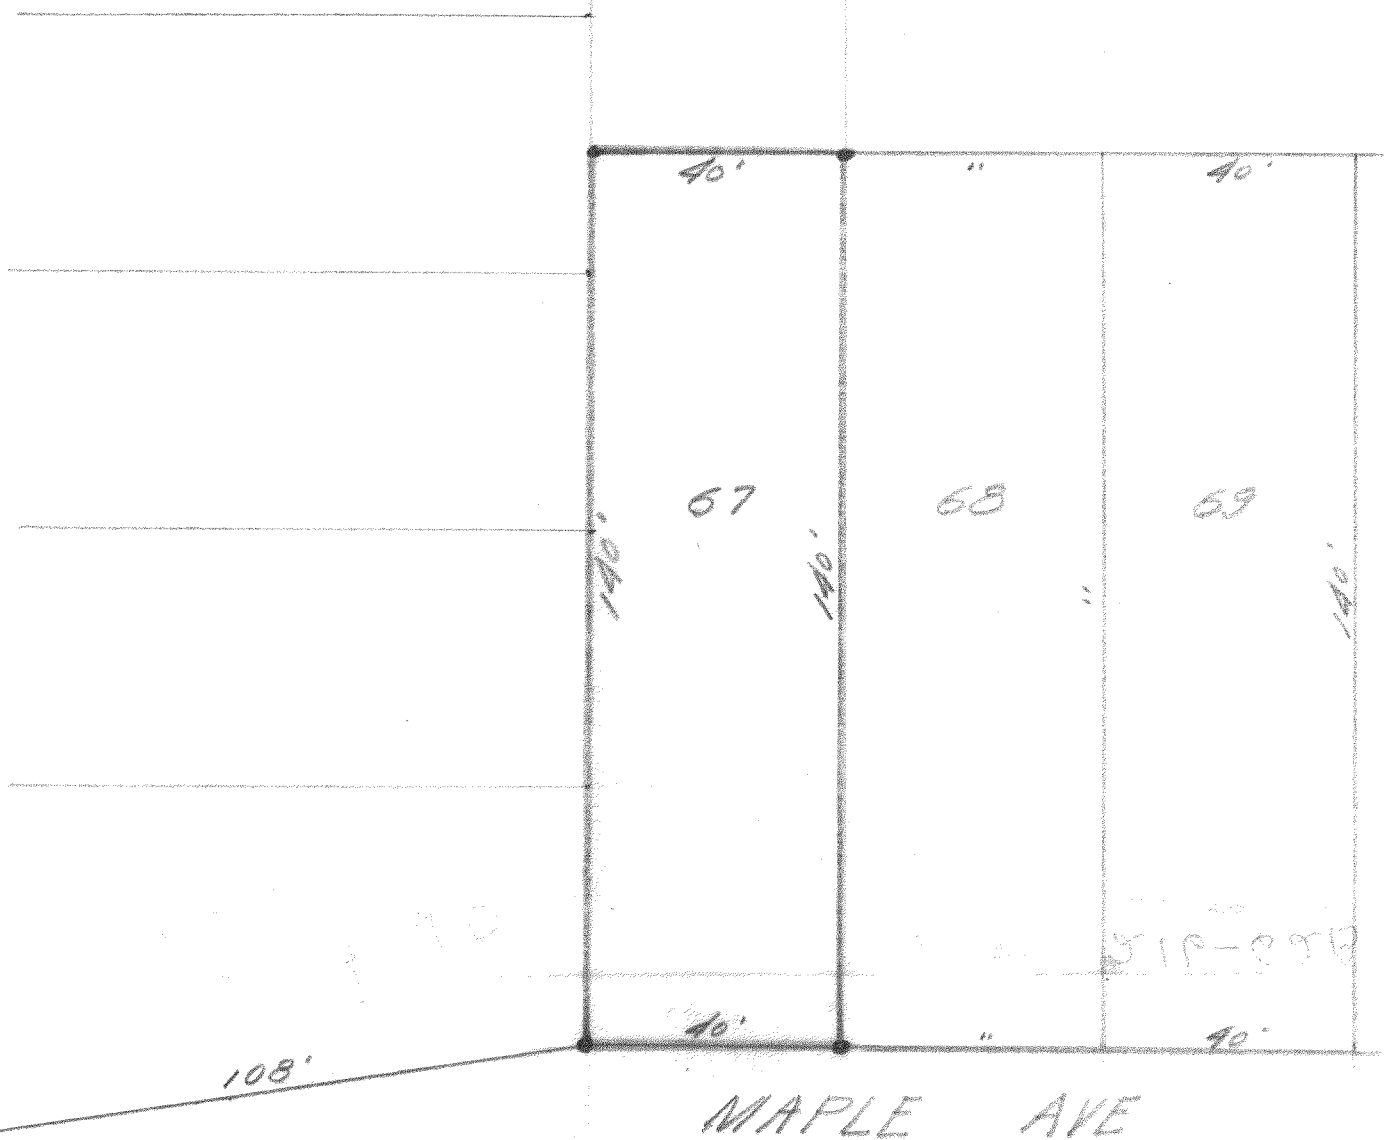

DESCRIPTION:

Lot 67 Kunnbaar's Addition to Ravenswood a subdivision of the N.W. $\frac{1}{4}$ of the S.E. $\frac{1}{4}$ of Section 31, T. 2 N., R. 16 E. of the 4th P.M.

CERTIFICATE:

I, hereby certify that I have on this the 14th day of May, 1946., surveyed the above described property according to the official records on file in the office of the Recorder of Deeds in and for Walworth County Wisconsin, and find that the measurements and bearings of the boundary lines of said property as taken at the site on this day, substantially agree with those in the above description, and that no encroachments exist.

SIGNED AND SEALED THIS 14TH DAY OF MAY 1946.

Lot 67 sd, add.

Joseph M. Biagi
Joseph M. Biagi.
Professional Engineer
Elkhorn Wisconsin.