



DUNHAM SURVEYING, S.C.
SURVEYING & SUBDIVIDING
DELAVER, WISCONSIN 53115

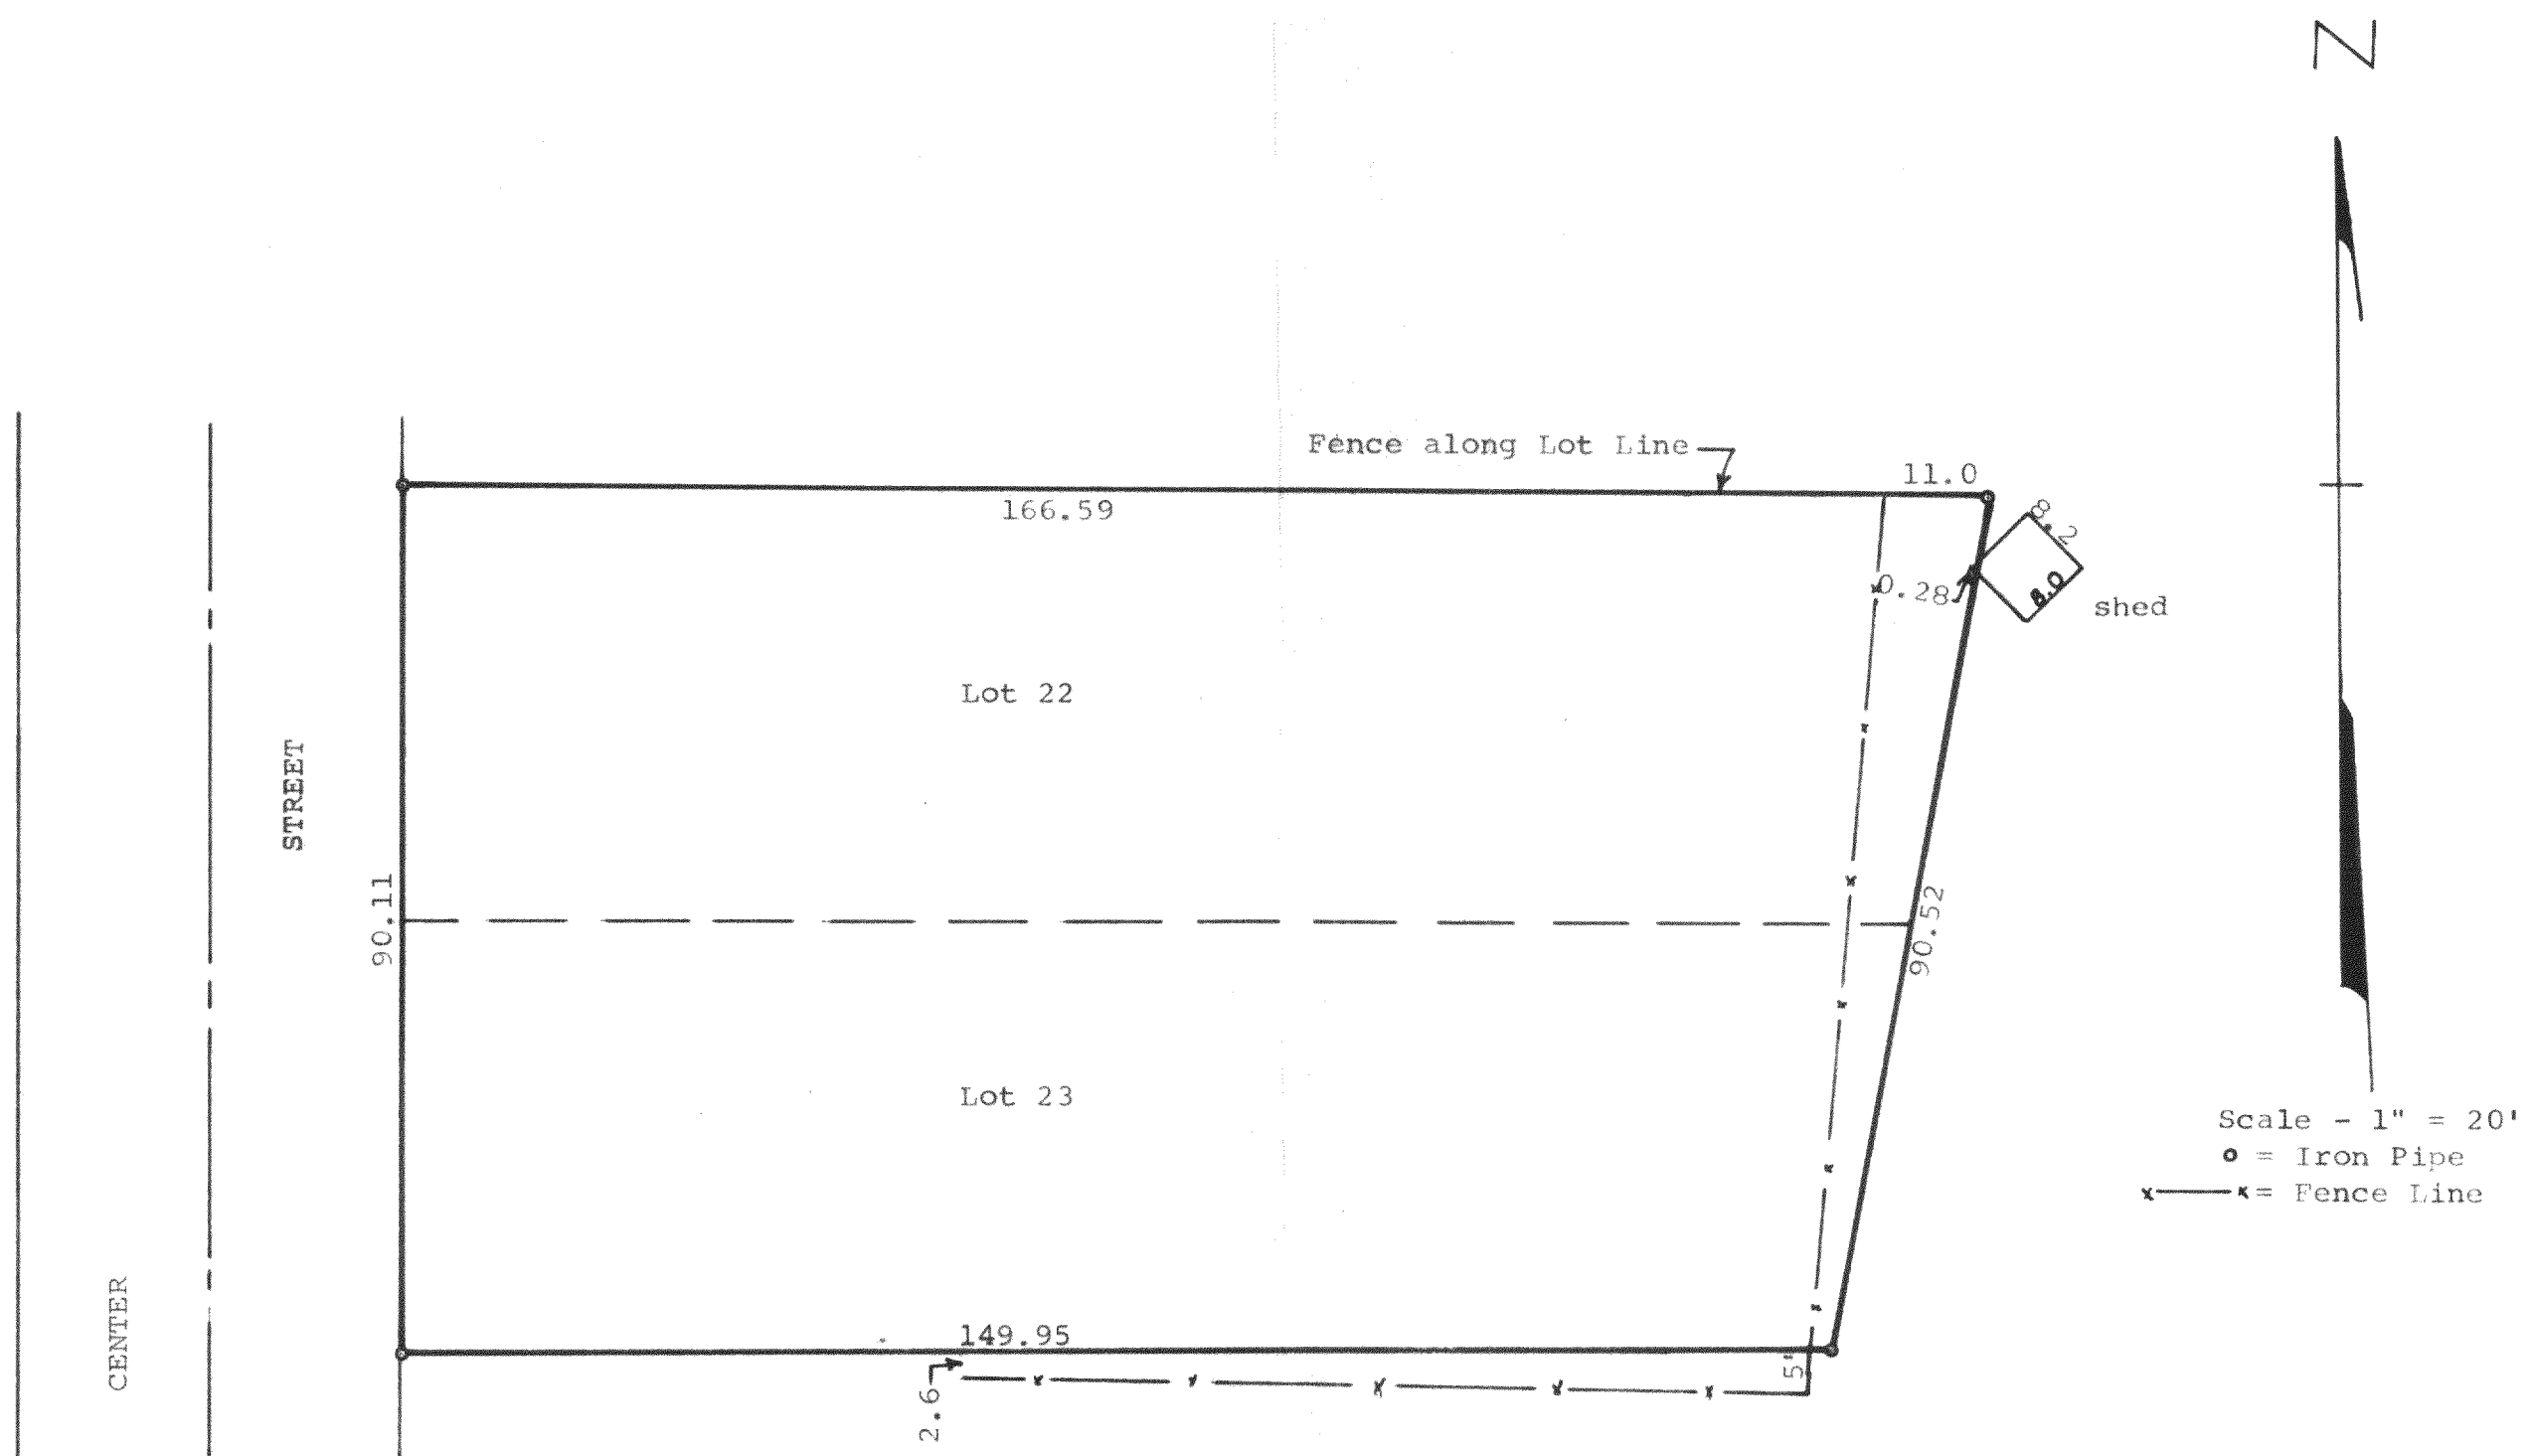

Plot of survey of:
Lots 22 and 23 in Block 6, Inlet Oaks Subdivision No. 4,
located in Section 15, T2N, R16E, Walworth County, Wisconsin.
October 11, 1977

George T. Dunham
George T. Dunham, Surveyor

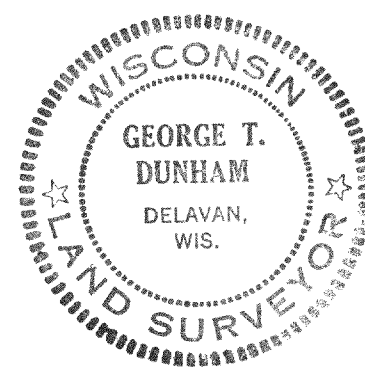

FIN 4-48

216-630