


DUNHAM SURVEYING, S.C.
SURVEYING & SUBDIVIDING
DELAVAN, WISCONSIN 53115

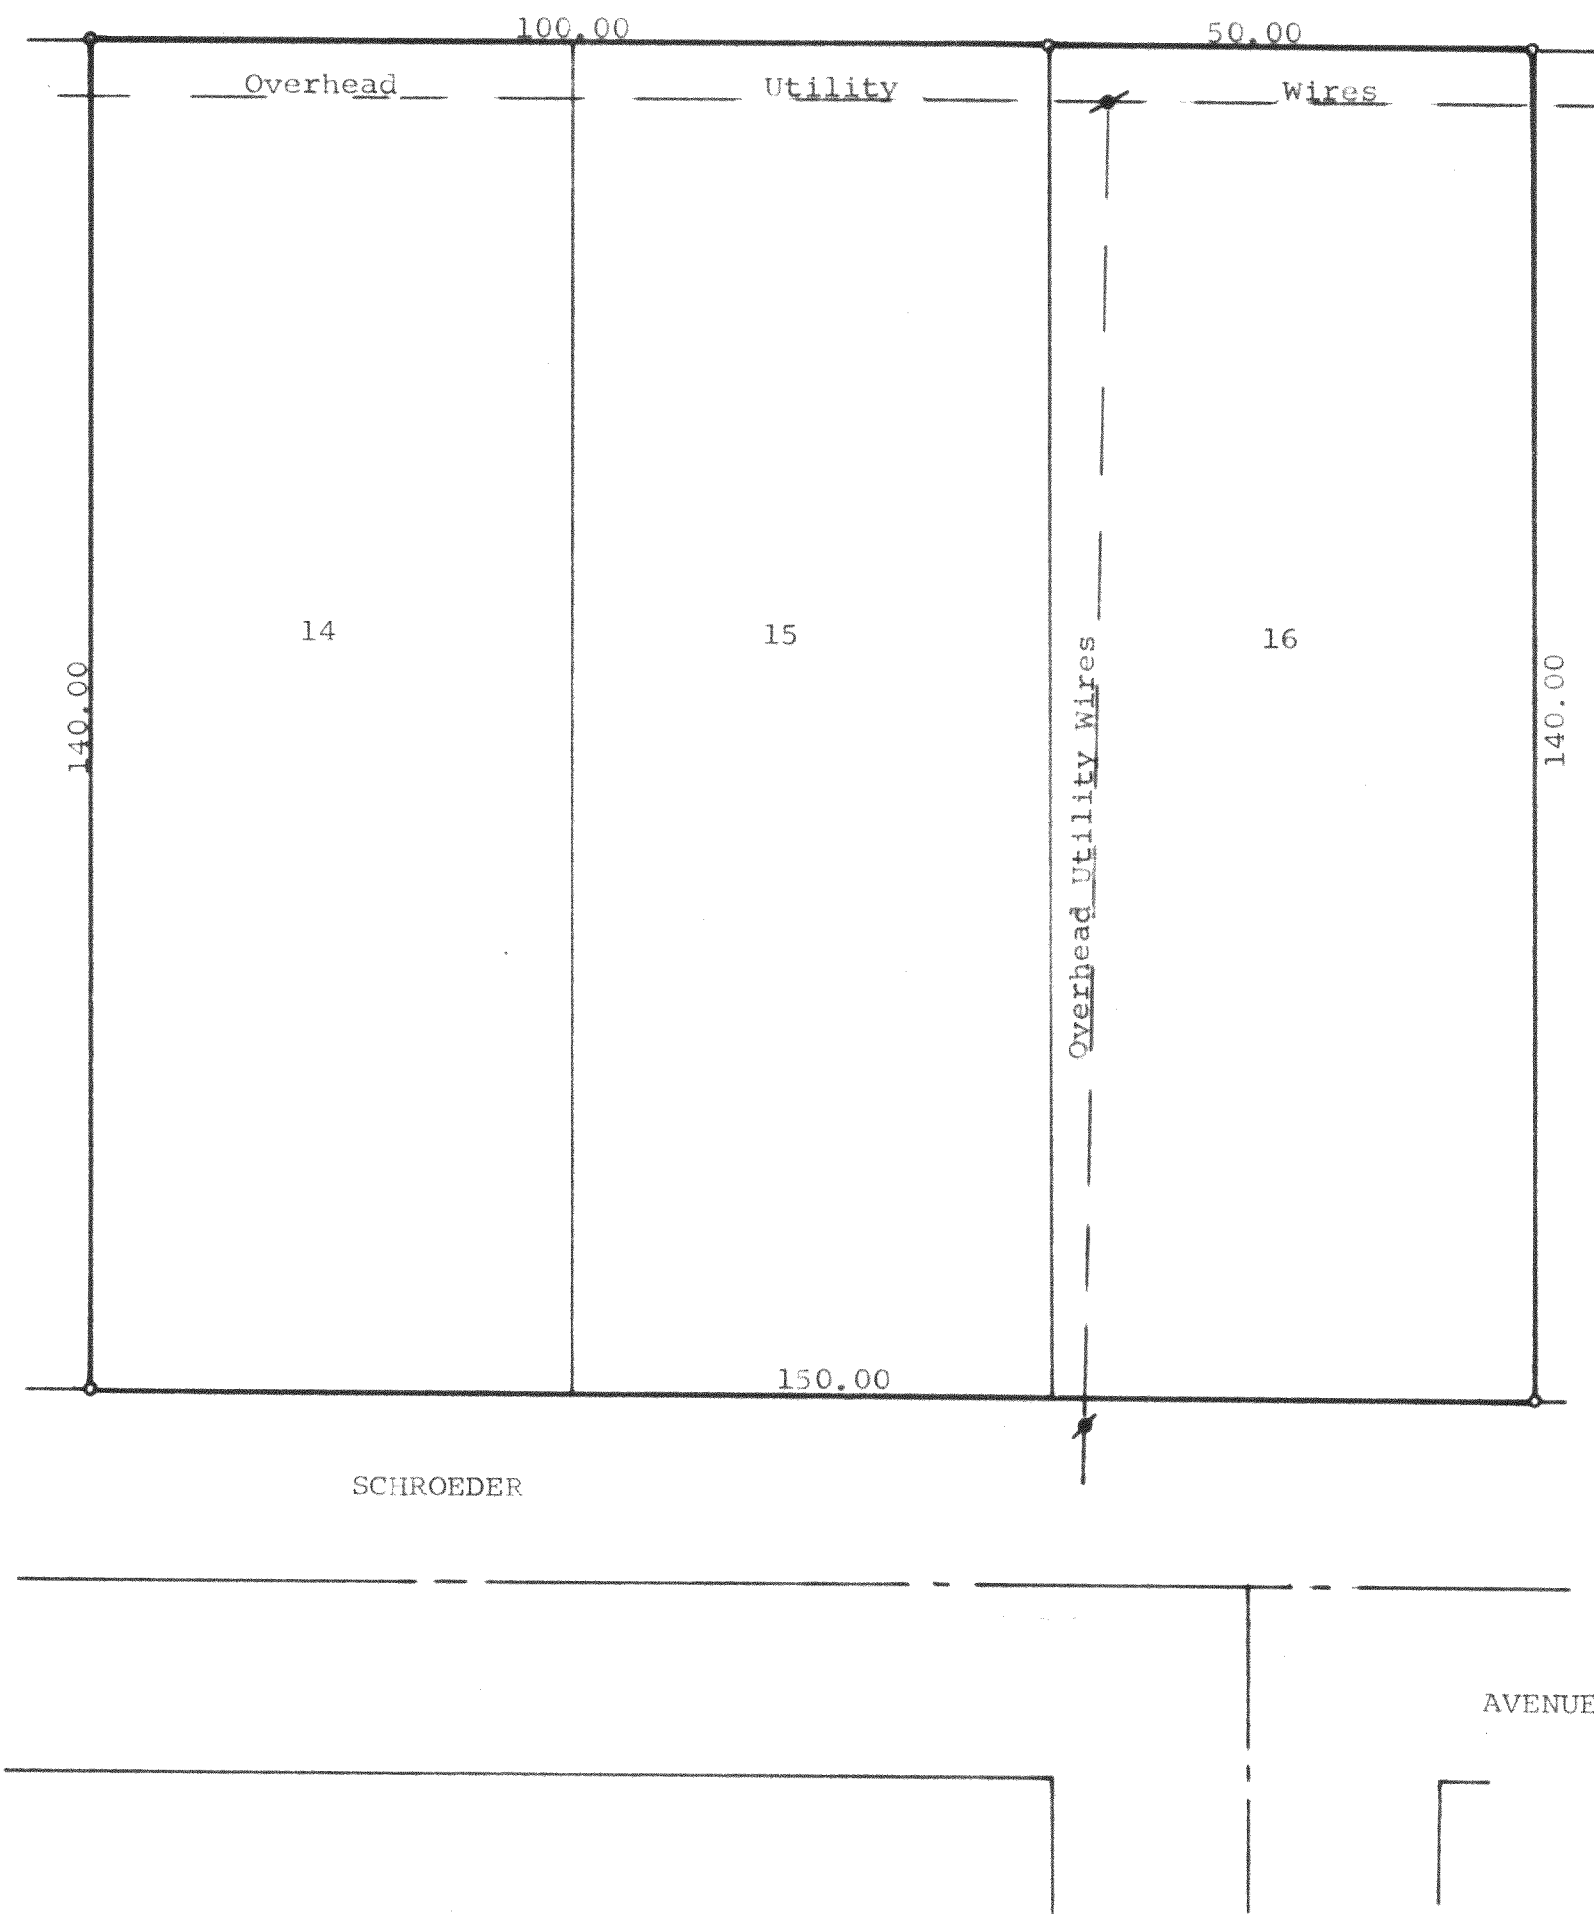


STATE OF WISCONSIN)
COUNTY OF WALWORTH) SS

I, George T. Dunham, Surveyor, certify that I have surveyed
the property described as follows:

Lots 14, 15, & 16 in Block 9 of Inlet Oaks Subdivision No. 4,
located in Section 15, T2N, R16E, Walworth County, Wisconsin,
and the above map is a true representation thereof and shows the size
and location of the property, its exterior boundaries, the location and
dimensions of all structures thereon, fences, apparent easements and
roadways and visible encroachments, if any.
January 17, 1978

George T. Dunham
George T. Dunham, Surveyor

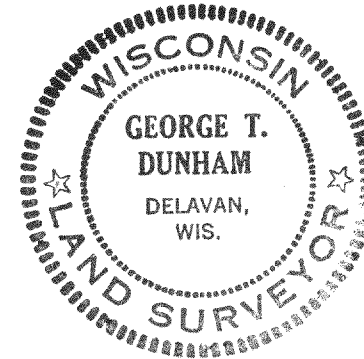

FIN4-770/1

216-631