


CERTIFICATE:

I, JOSEPH M. BIAGI, SURVEYOR, DO
HEREBY CERTIFY THAT I HAVE SURVEYED THE
PROPERTY HEREON DESCRIBED.

SIGNED: SEPT. 25, 1974

JOSEPH M. BIAGI
ELKHORN, WI.

RLS 12

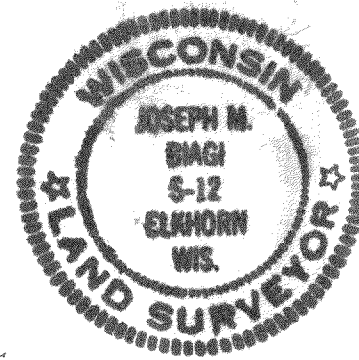

DESCRIPTION:
LOTS 29 & 30, BLOCK 17, OF DELAVAN
LAKE VIEW CREST SUBDIVISION, LOC-
ATED IN SEC. 31, T.2N, R.16E,
WALWORTH CO. WISCONSIN.

PARK
DRIVE
50' WIDE

HIGHLAND
DRIVE
50' WIDE

SYLVAN DRIVE 50' WIDE

HOUSE

30

29

17

LEGEND

- - NAIL FOUND
- - IRON PIPE FOUND
- ⊙ - IRON PIPE SET

SCALE: 1"=30'

REVISIONS			SURVEY FOR:		
NO.	DATE	BY	MRS. JOHN SWIDEREK		
1			LOTS 29 & 30 BLOCK 17		
2			DELAVAN LAKE VIEW CREST SUBD.		
3			DRAWN BY JPR	SCALE 1"=30'	MATERIAL
4			CHK'D HG	DATE 9-24-74	DRAWING NO.
5			TRACED	APP'D	102-74

FDLV-142