


DUNHAM SURVEYING, S.C.
SURVEYING & SUBDIVIDING
DELAVAN, WISCONSIN 53115

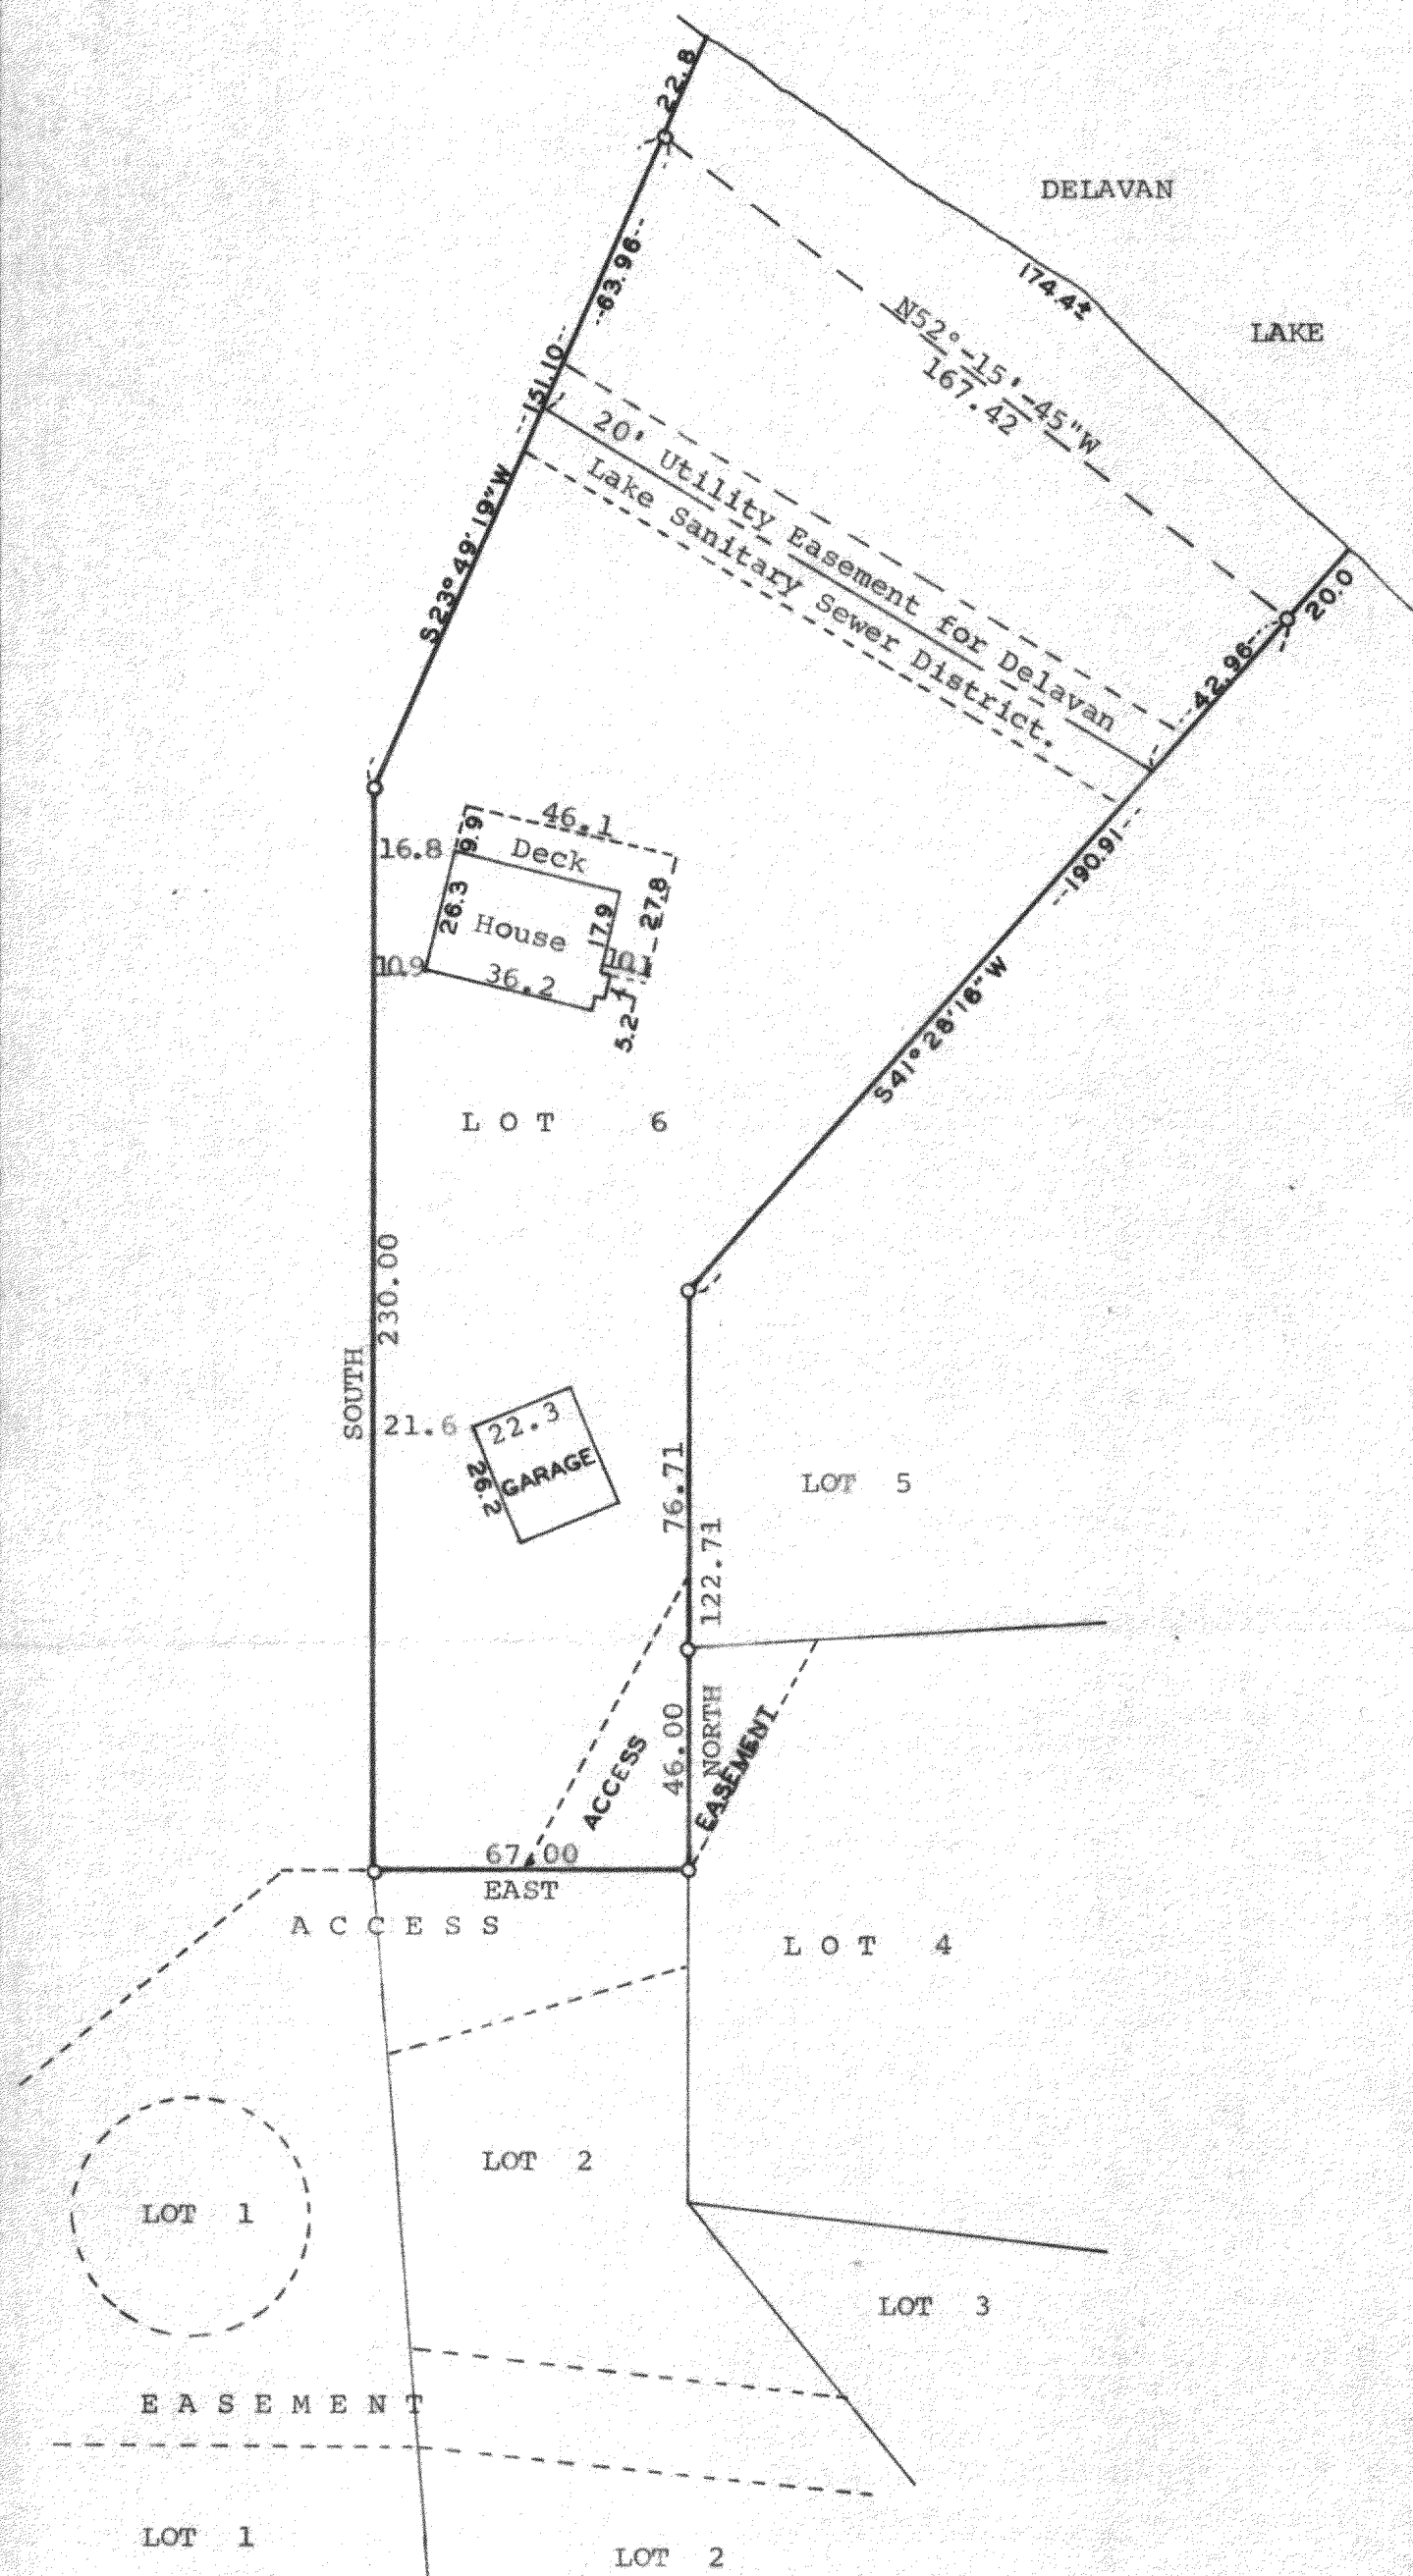

Scale - 1" = 40'
O = Iron Pipe

Note: Existing gravel drives are not shown due to snow cover.

STATE OF WISCONSIN)
COUNTY OF WALWORTH) SS
I, James M. Dunham, Surveyor, certify that I have surveyed the property described as follows,
Lot 6 of The Island of Lake Delavan, a subdivision located in fractional Section 32, T 2 N, R 16 E, Walworth County, Wisconsin,
and the above map is a true representation thereof and shows the size and location of the property, its exterior boundaries, the location and dimensions of all structures thereon, fences, apparent easements and roadways and visible encroachments, if any.
January 25, 1978

James M. Dunham
James M. Dunham, Surveyor

