

PLAT OF SURVEY

OF LOT 2 - BLOCK 1 OF OAKHILL SUBDIVISION, IN THE
TOWNSHIP OF DELAVAN, WALWORTH COUNTY, WISCONSIN.

N


BEARINGS FROM
RECORD

LEGEND

- IRON PIPE FOUND
- IRON BAR SET 3/4" x 24"

66' WIDE

COUNTY "O"

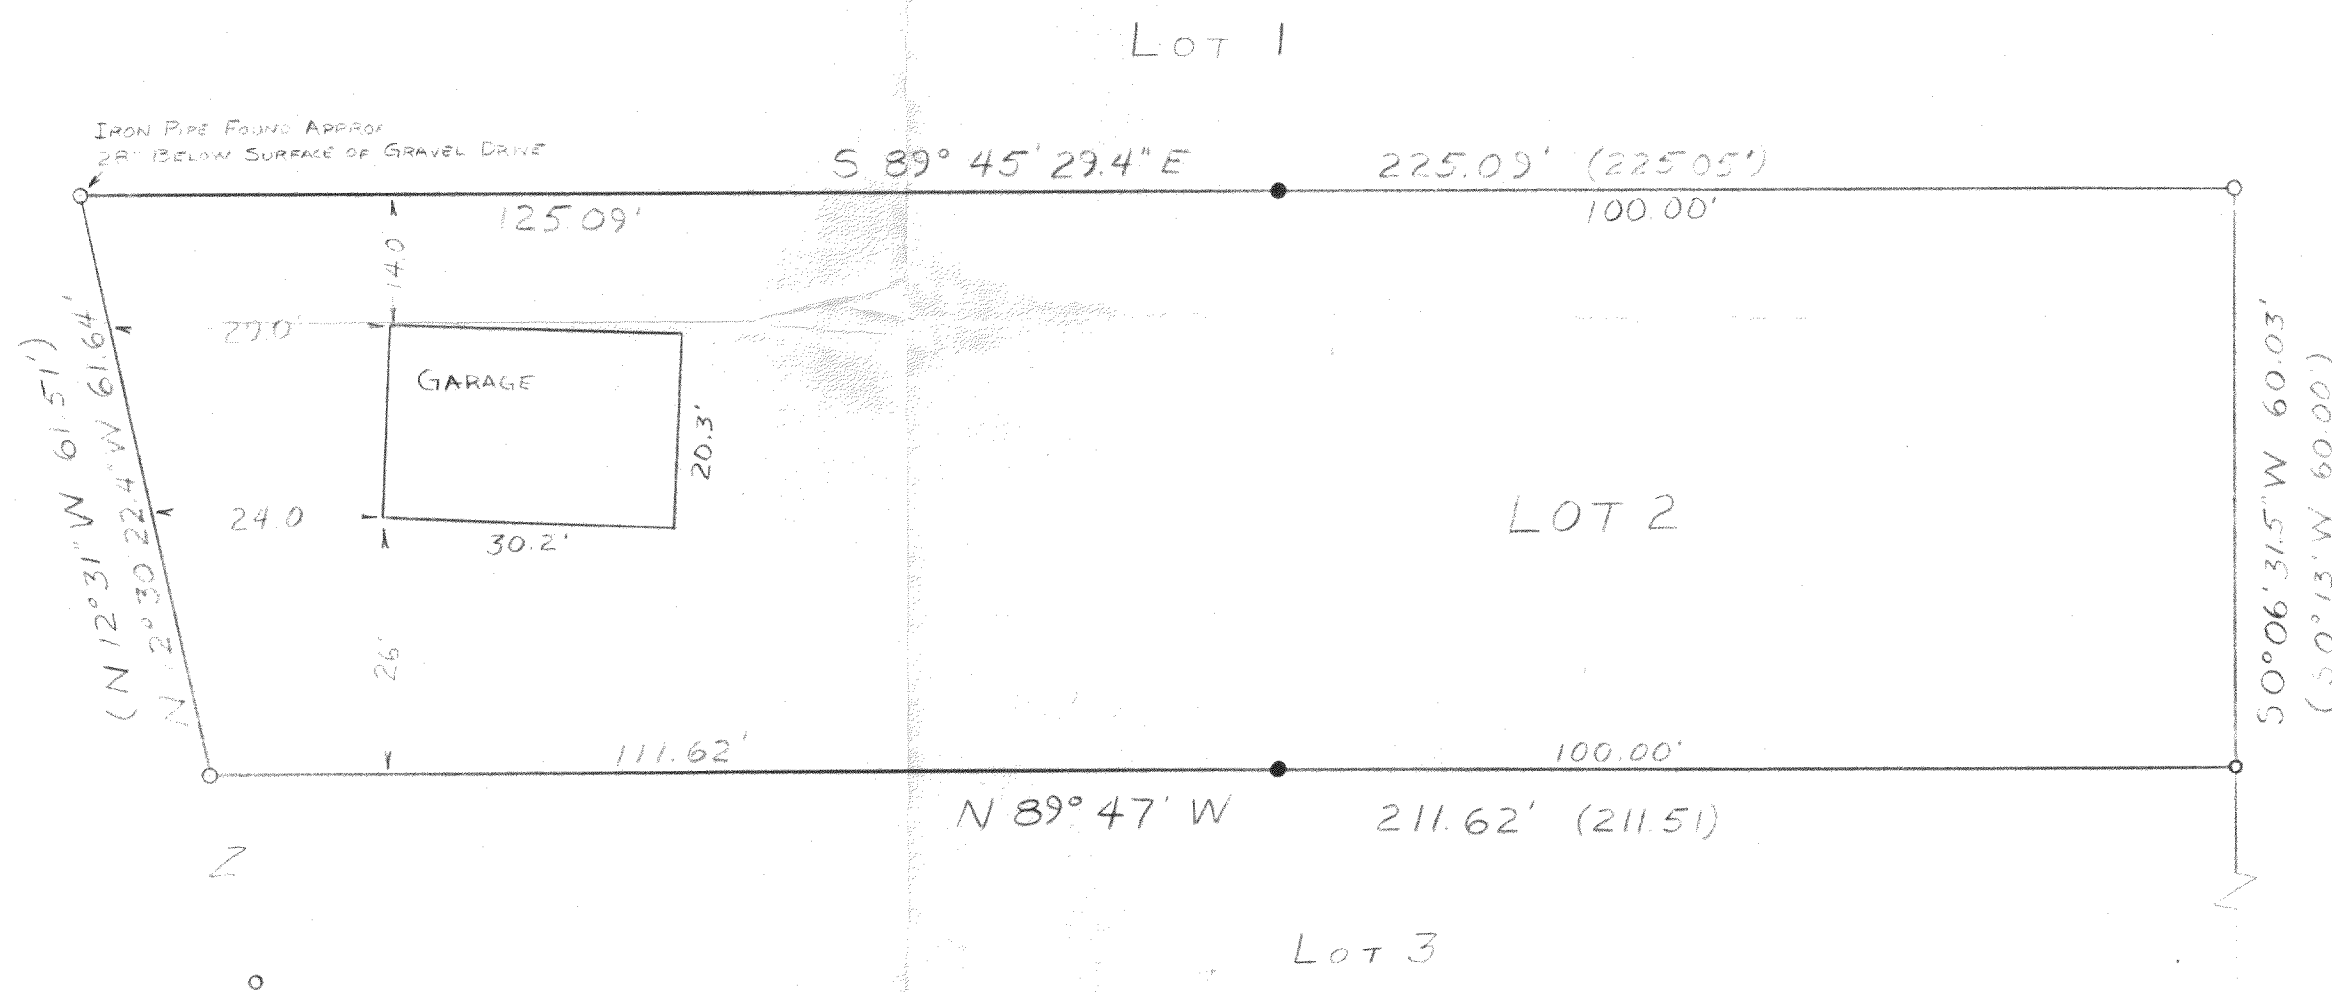


FG-1A

Surveyors Certificate I, WILLIAM A. SHEARMAN, REGISTERED LAND SURVEYOR, DO HEREBY CERTIFY THAT THE PLAT SHOWN HEREON IS A TRUE AND ACCURATE SURVEY AND A TRUE REPRESENTATION THEREOF AND THE EXTERIOR BOUNDARY LINES AND ALL DIVISIONS OF SAID PROPERTY HAVE BEEN SURVEYED UNDER MY DIRECTION AND TO THE BEST OF MY KNOWLEDGE AND BELIEF.

William A. Shearman DATED THIS 5th DAY OF Aug, 1978.
WILLIAM A. SHEARMAN
REGISTERED LAND SURVEYOR S-1378

JENSEN & JOHNSON
ENGINEERS AND SURVEYORS
PO BOX 290, ELKHORN, WISCONSIN
414-723-3204
A Division of
Donohue & Associates, Inc.

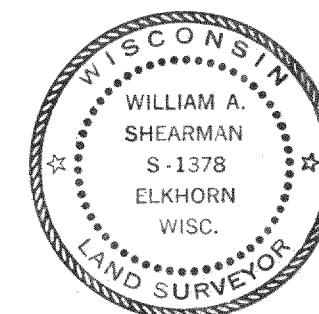

Date	8-04-78	Scale	1" = 20'
Drawn By	SM	Surveyed For	DWAYNE HAYEN
Checked By		Project No.	1658.327

216-656 ✓