


MORTGAGE LENDER SURVEY

NOTE: This is not a "Property Survey" as defined in Section AE-5.01 of the Wisconsin Administrative Code.

LEGAL DESCRIPTION: Lot 13, Block 2, Inlet Oaks Subdivision Number 3, Town of Delavan, Walworth County, Wisconsin

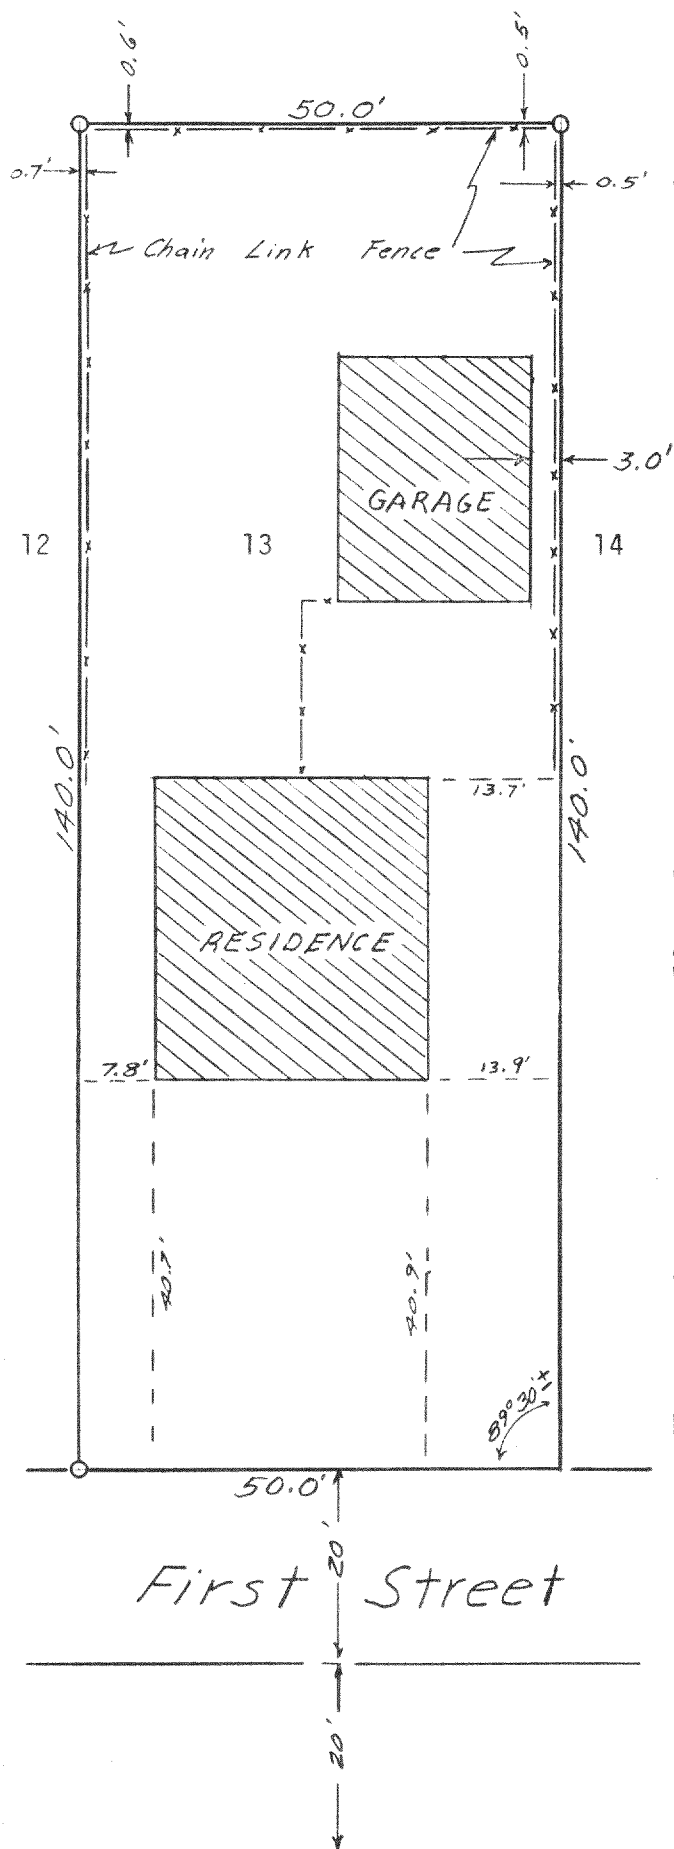

Map Scale: 1" = 20'

O = Iron Pipe Found

BUYER: Richard J. & Veronica L. Telfer

SELLER: Jeanne King


Address: 316 First Street

WORK ORDERED BY: Sandra J. Butler for Waukesha Savings & Loan -- East Troy Office

I HEREBY CERTIFY that this map is a true and accurate representation of the lot lines and of the buildings located thereon to the best of my knowledge and belief

Dated this 11th day of September, 1978

Robert A. Farris
Robert A. Farris RLS

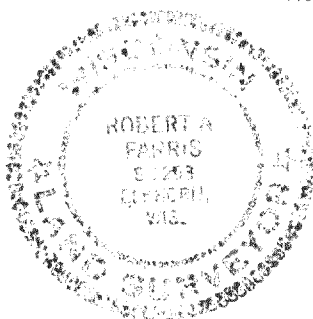

FARRIS, HANSEN & COOPER, INC.

715 W. WALWORTH AVE. P.O. BOX 487 216-659
EKAHORN, WISCONSIN 53121
TELEPHONE 414-723-2098

DRAWING NO. **1401**

FIN3-35