


DUNHAM SURVEYING, S.C.
SURVEYING & SUBDIVIDING
DELAVER, WISCONSIN 53115

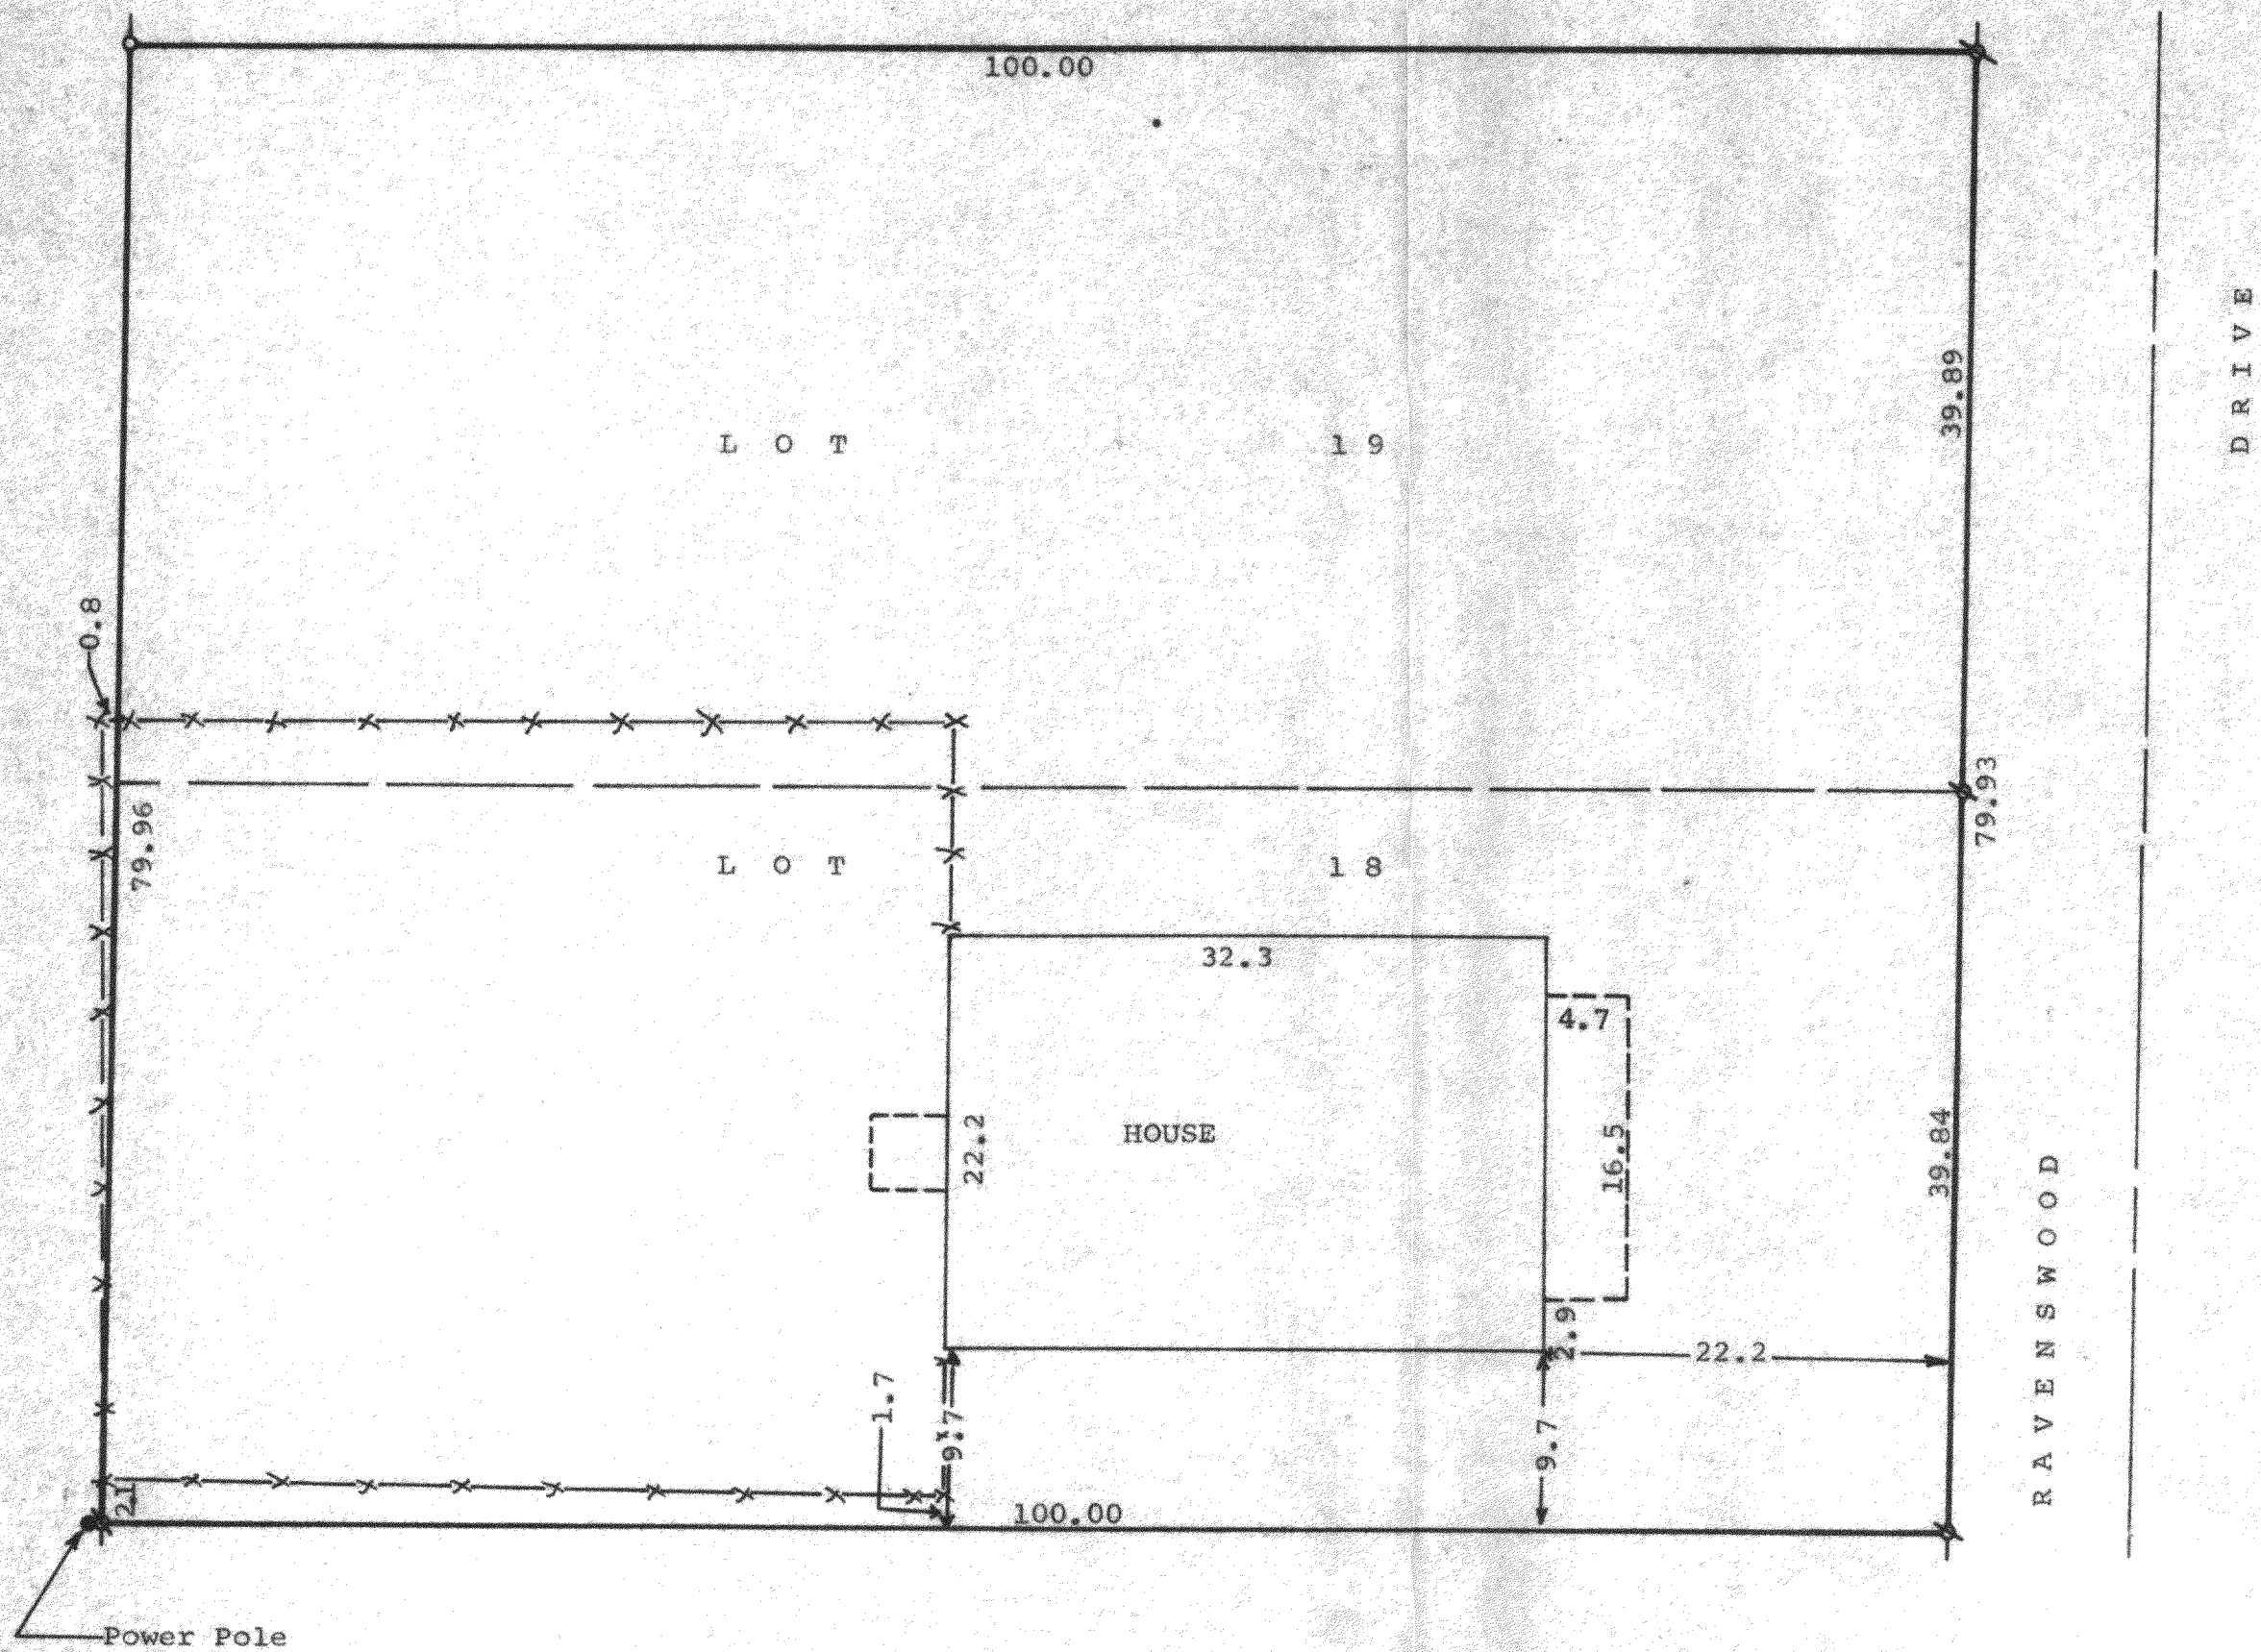

Scale - 1" = 10'
 X = Iron Pipe Found
 O = Iron Pipe Set
 X-X-X = Fence

STATE OF WISCONSIN) SS
 COUNTY OF WALWORTH)

I, George T. Dunham, Surveyor, certify that I have surveyed
 the property described as follows,

Lots 18 and 19, Ravenswood, located in Section 31, T 2 N,
 R 16 E, Walworth County, Wisconsin,
 and the above map is a true representation thereof and shows the size
 and location of the property, its exterior boundaries, the location and
 dimensions of all structures thereon, fences, apparent easements and
 roadways and visible encroachments, if any.
 This survey is made for the exclusive use of the present owners
 of the property, and also those who purchase, mortgage, or
 guarantee the title thereto within one (1) year from date hereof;
 and as to them I warrant the accuracy of said survey and map.
 December 4, 1978

George T. Dunham
 George T. Dunham, Surveyor

