


PLAT OF SURVEY OF PART OF LOT 9 OF CEDAR POINT
 RECORDED IN VOL. 6, PAGE 50 IN THE OFFICE OF THE
 WAL. CO. REGISTER OF DEEDS, THE SURVEY BEING
 THE LAND RECORDED IN VOL. 231 PAGE 705 OF DEEDS.

I CERTIFY THAT THE ABOVE DESCRIBED PROPERTY
 HAS BEEN SURVEYED UNDER MY DIRECTION AND THAT
 THE PLAT SHOWN HEREON IS AN ACCURATE SURVEY
 & A TRUE REPRESENTATION THEREOF & CORRECTLY
 SHOWS THE BOUNDARY LINES OF SAID PROPERTY &
 ALL BUILDINGS THEREON.

MAY 17, 1979

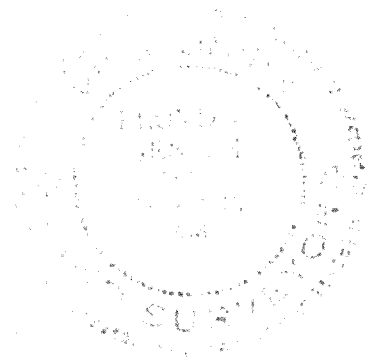

Lloyd L. Jensen
 Lloyd L. JENSEN 5-211
 ELKHORN, WISCONSIN

