


DUNHAM SURVEYING, S.C.
SURVEYING & SUBDIVIDING
DELAVER, WISCONSIN 53115

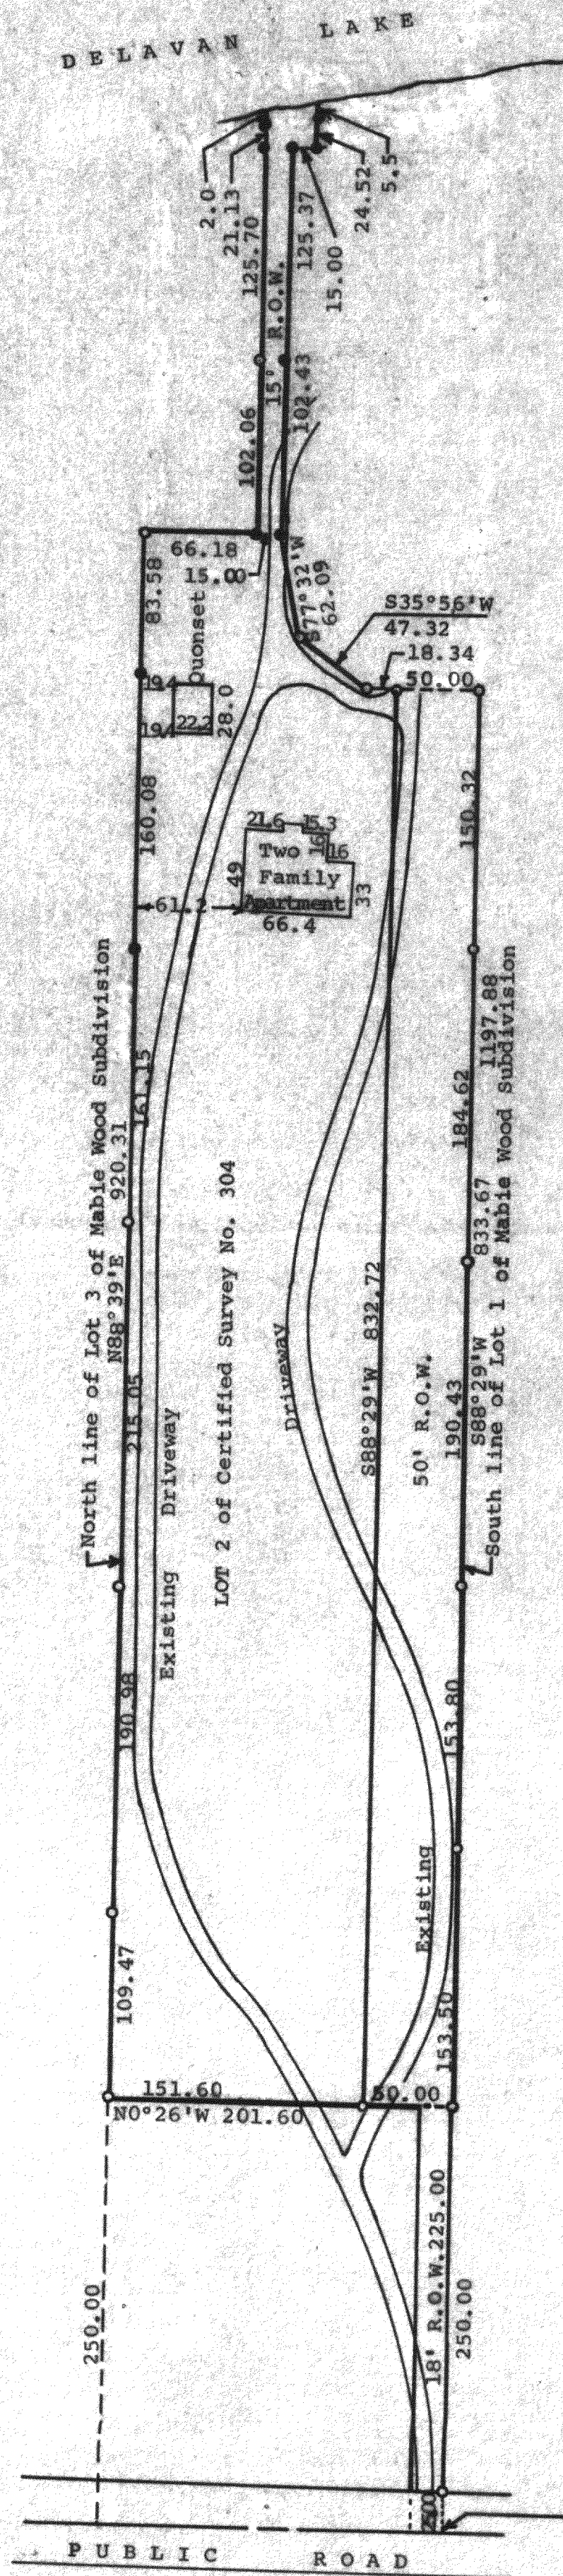

Scale - 1" = 80'
○ = Iron Pipe located on previous survey dated "Revised October 22, 1973."
● = Iron Pipe located on date of this survey.

STATE OF WISCONSIN) SS
COUNTY OF WALWORTH)
I, George T. Dunham, Surveyor, certify that I have surveyed the property described as follows:
Lot 2 of Certified Survey No. 304, recorded in Volume 2 of Certified Surveys, on page 71, in the office of the Register of Deeds, Walworth County, Wisconsin; said certified survey being a part of Lots 1, 2, and 3 of Mabie Wood Subdivision located in the Southeast 1/4 of Section 21, T2N, R16E, Walworth County, Wisconsin,
and the adjoining map is a true representation thereof and shows the size and location of the property, its exterior boundaries, the location of all visible structures and dimensions of all principal buildings thereon, boundary fences, apparent easements, roadways and visible encroachments, if any.
This survey is made for the use of the present owners of the property, and also those who purchase, mortgage, or guarantee the title thereto within one (1) year from date hereof.
January 22, 1979

George T. Dunham
George T. Dunham, Surveyor

