


PLAT OF SURVEY

OF PART OF THE N1/2 OF SEC.31, T.2N, R.16E, OF THE 4TH
PRINCIPAL MERIDIAN, WALWORTH COUNTY, WISCONSIN

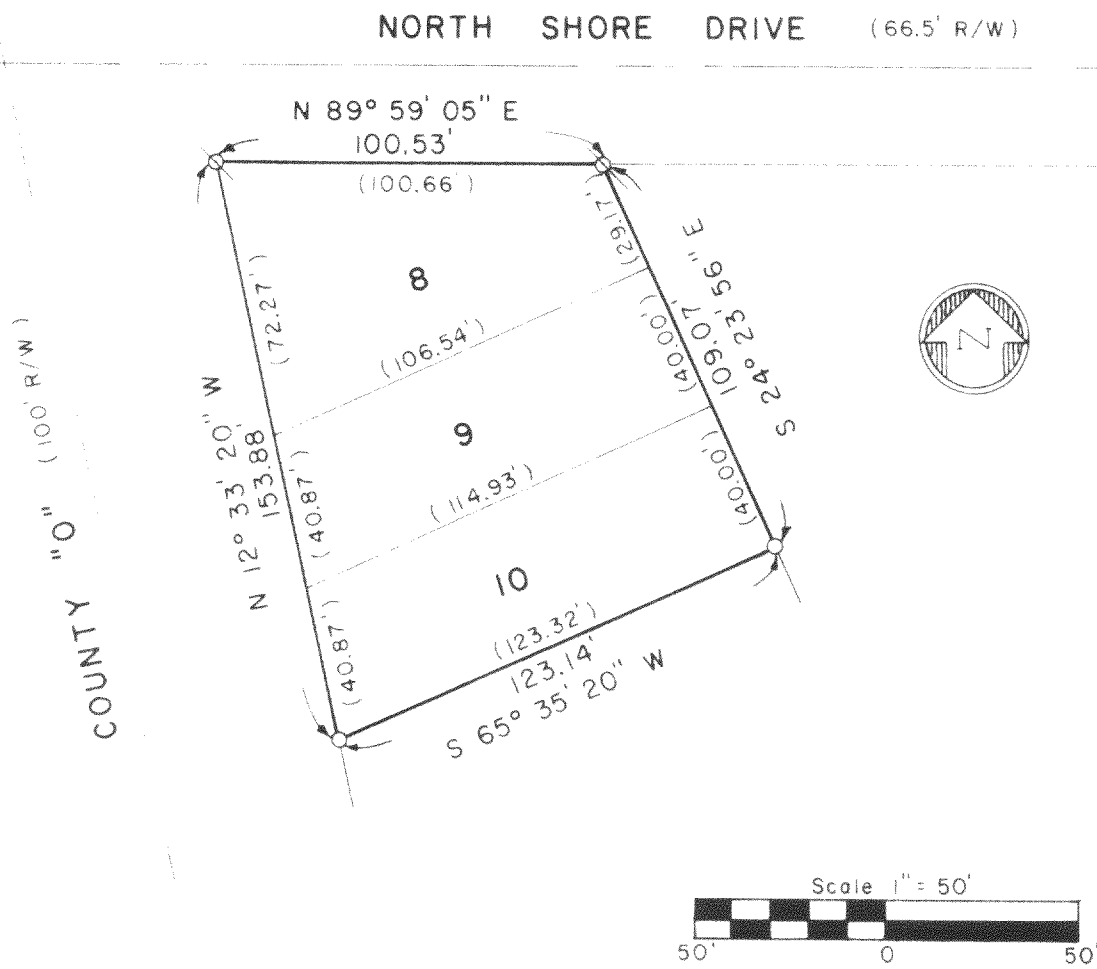

- Iron pipe set
- ⊗ Iron rod set
- () Indicates "Recorded as"

DESCRIPTION: Lots 8, 9, and 10 of Block 2 of Delavan Lakeview Crest, a subdivision of part of the N 1/2 of Section 31, Township 2 North, Range 16 East, of the 4th Principal Meridian, Delavan Township, Walworth County, Wisconsin.

SURVEYOR'S CERTIFICATE: I hereby certify that I have surveyed the above described property and that the above map is a true representation thereof and shows the size and location of the property, its exterior boundaries, the location of all visible structures and dimensions of all principal buildings thereon, boundary fences, apparent easements, roadways and visible encroachments, if any. This survey is made for the use of the present owners of the property, and also those who purchase, mortgage, or guarantee the title thereto within one (1) year from date hereof.

January 2, 1977
Date

Dennis W. Valentine
Dennis W. Valentine, RLS S-1419

FDLV-242 (P1)

SURV.

Prepared By	Prepared For	Date	Sheet Number
VALENTINE AND ASSOCIATES, INC.	DENNIS STONEWALL	12-4-78	of
DELAVAN, WISCONSIN	DELAVAN, WISCONSIN	Job Number	Reference
		7827	file

216-683