


PLAT OF SURVEY

OF PART OF THE N1/2 OF SEC.31, T.2N, R.16E, OF THE 4TH
PRINCIPAL MERIDIAN, WALWORTH COUNTY, WISCONSIN

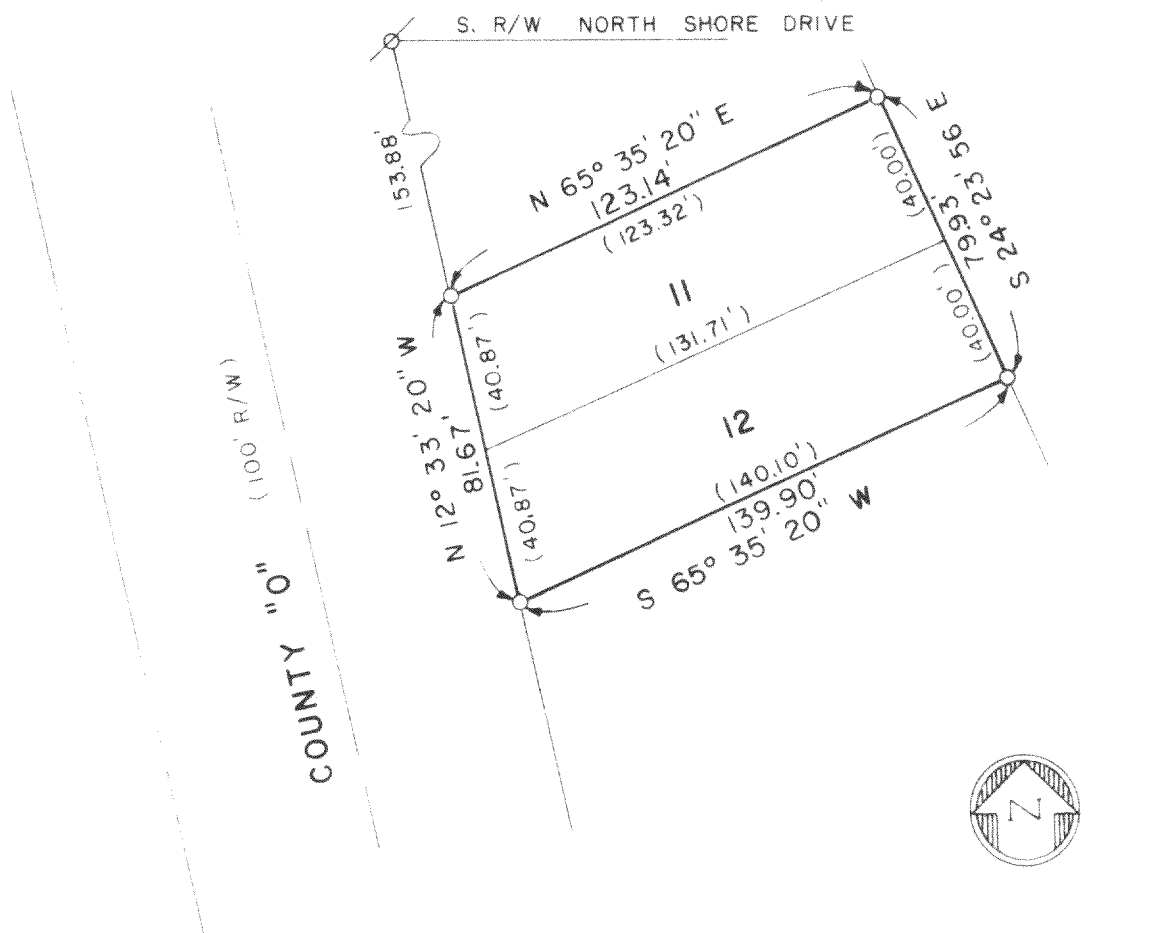

- Iron pipe set
 ∅ Iron rod set
 () Indicates "Recorded as"

DESCRIPTION: Lots 11 and 12
 of Block 2 of Delavan Lakeview Crest,
 a subdivision of part of the N 1/2
 of Section 31, Township 2 North,
 Range 16 East, of the 4th Principal
 Meridian, Delavan Township, Walworth
 County, Wisconsin.

SURVEYOR'S CERTIFICATE: I hereby certify that I have surveyed
 the above described property and that the above map is a
 true representation thereof and shows the size and location
 of the property, its exterior boundaries, the location of
 all visible structures and dimensions of all principal
 buildings thereon, boundary fences, apparent easements,
 roadways and visible encroachments, if any. This survey is
 made for the use of the present owners of the property, and
 also those who purchase, mortgage, or guarantee the title
 thereto within one (1) year from date hereof.

February 2, 1979
 Date

Dennis W. Valentine
 Dennis W. Valentine, RLS S-1419

FDLW-2A2 (PL)

SURV.

Prepared By	Prepared For	Date	Sheet Number
VALENTINE AND ASSOCIATES, INC.	DENNIS STONEWALL	12-6-78	of
DELAVAN, WISCONSIN	DELAVAN, WISCONSIN	Job Number	Reference
		7827	file

216-684