


216-694-D

DUNHAM SURVEYING, S.C.  
SURVEYING & SUBDIVIDING  
DELAVER, WISCONSIN 53115

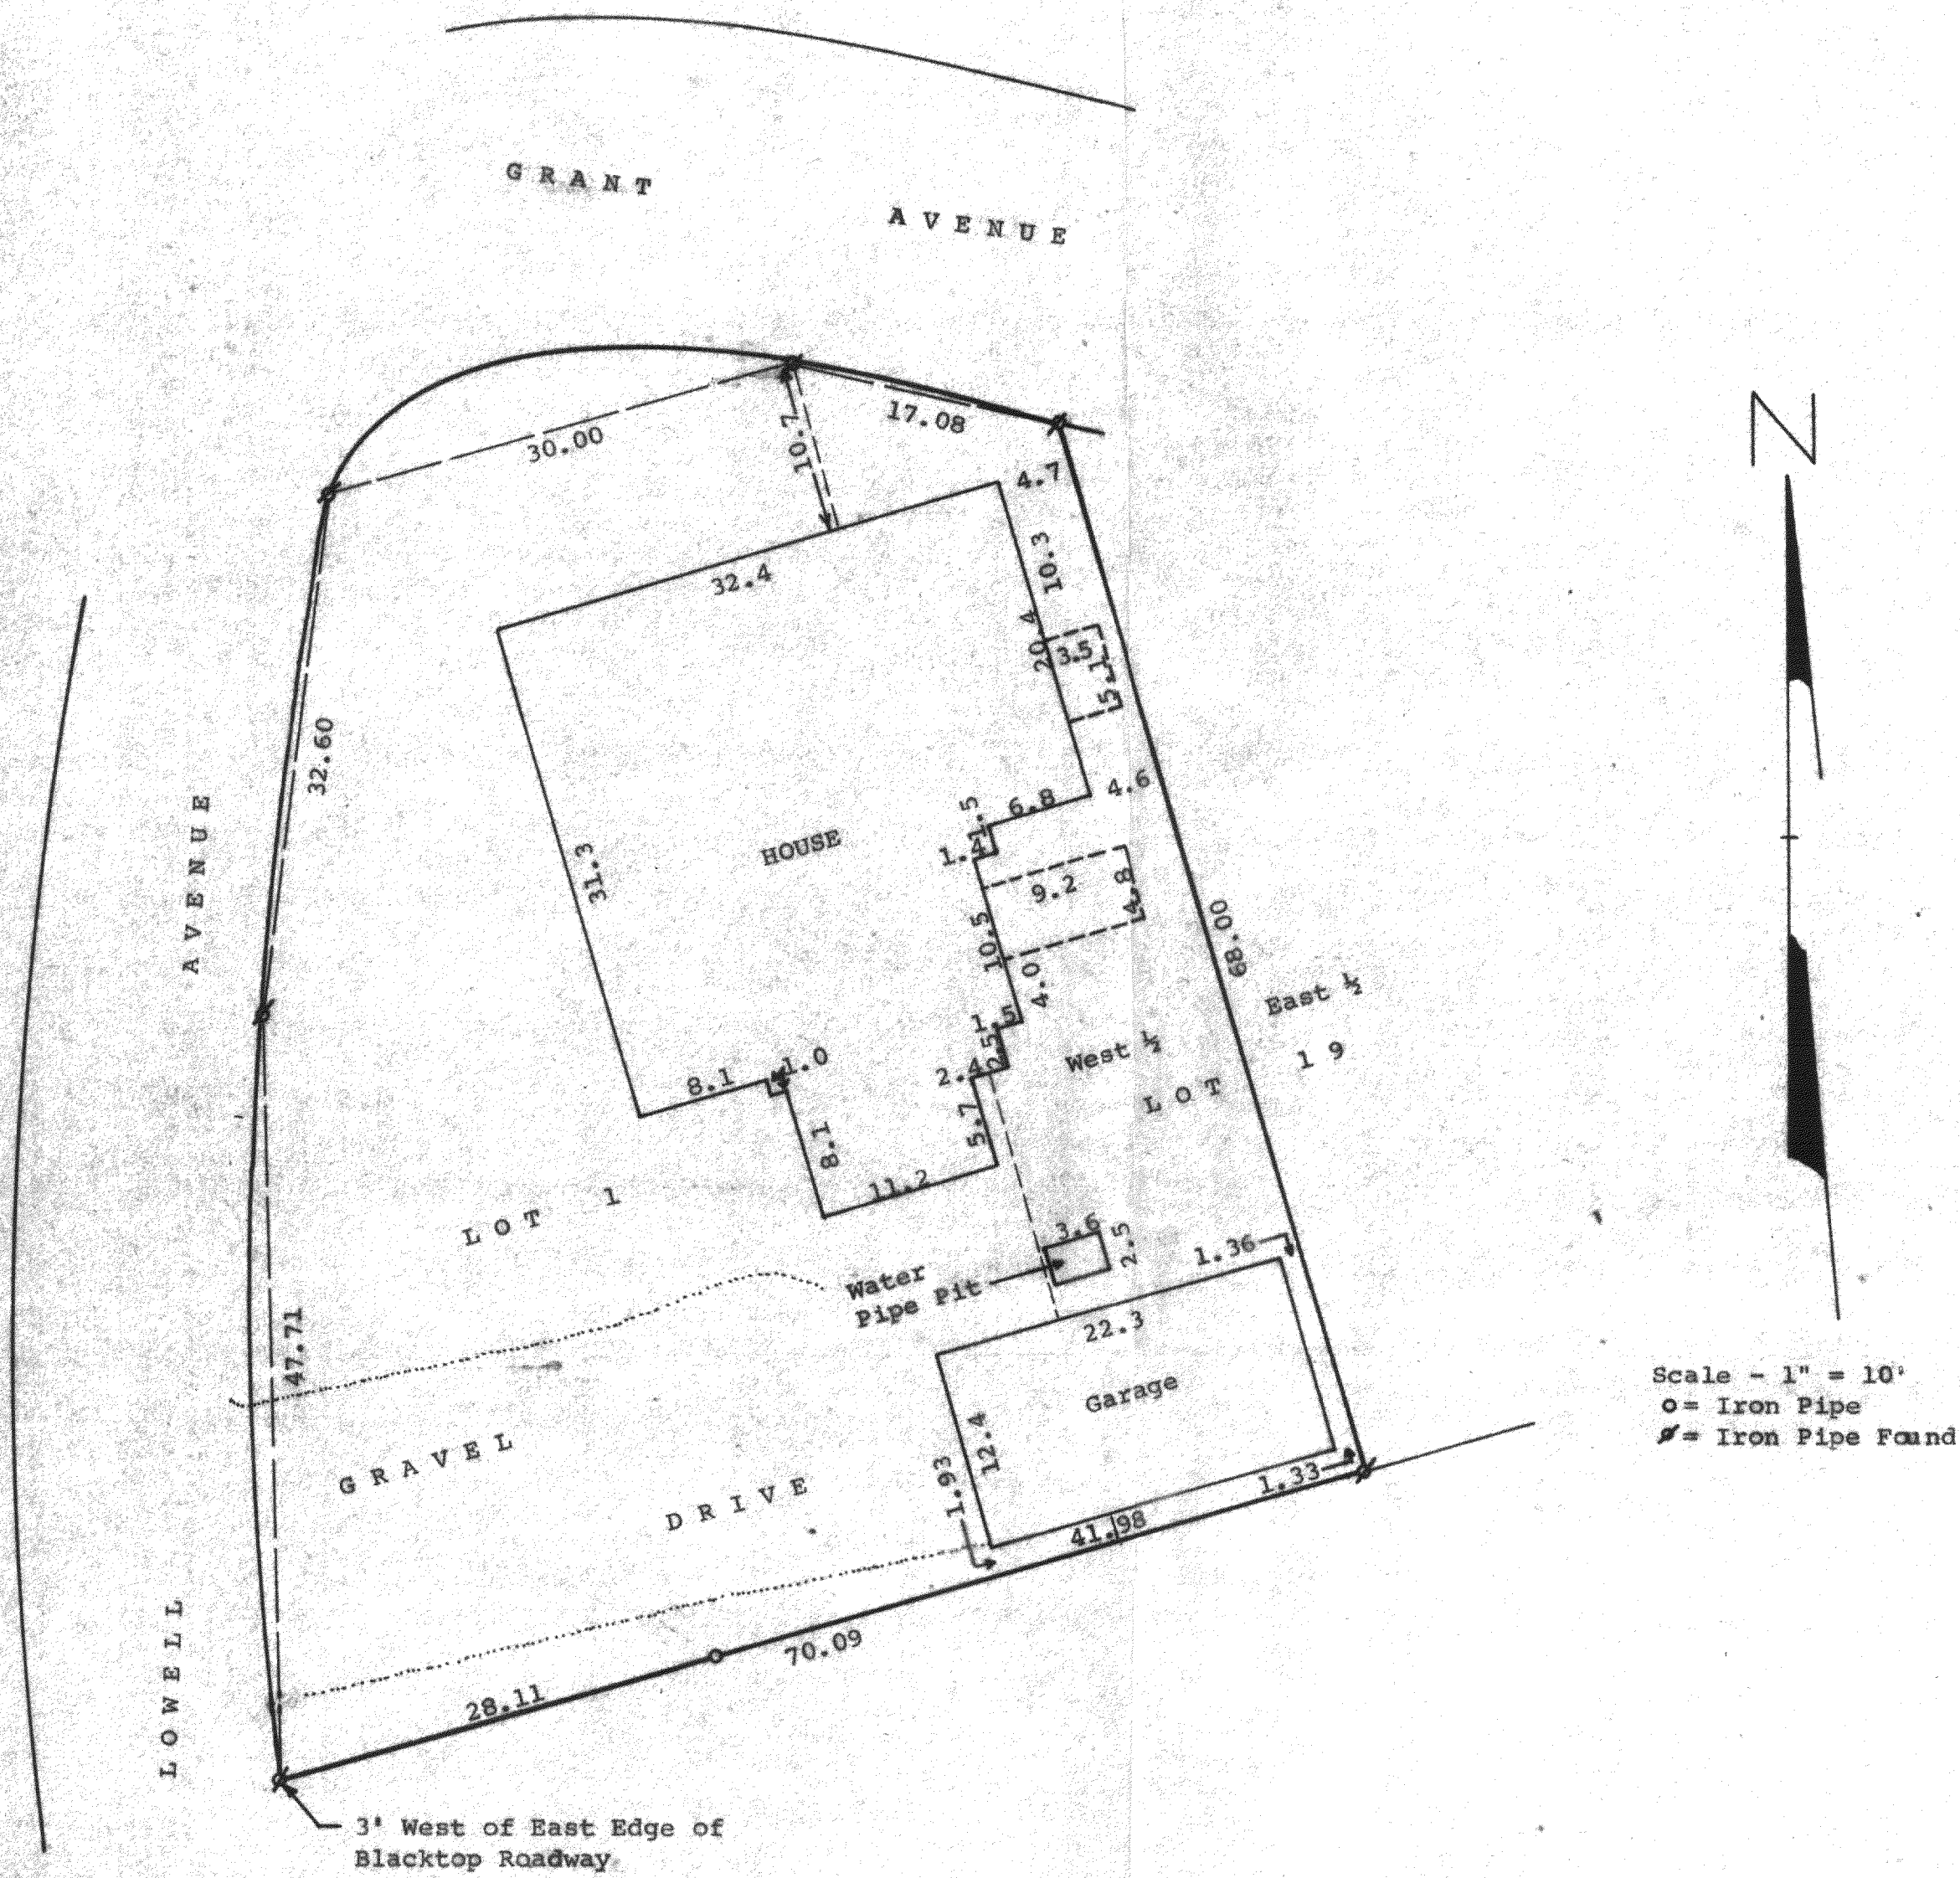

STATE OF WISCONSIN)  
COUNTY OF WALWORTH) SS

I, George T. Dunham, Surveyor, certify that I have surveyed  
the property described as follows,

Lot 1 and the West 1/4 of Lot 19, Block "N" of Delavan Lake  
Assembly Grounds, a subdivision located in Fractional Section  
21, T2N, R16E, Walworth County, Wisconsin,

and that the above map is a true representation thereof and shows the  
size and location of the property, its exterior boundaries, the location  
of all visible structures and dimensions of all principal buildings  
thereon, boundary fences, apparent easements, roadways and visible  
encroachments, if any.

This survey is made for the use of the present owners of the property,  
and also those who purchase, mortgage, or guarantee the title thereto  
within one (1) year from date hereof.  
October 4, 1979

*George T. Dunham*  
George T. Dunham, Surveyor

