


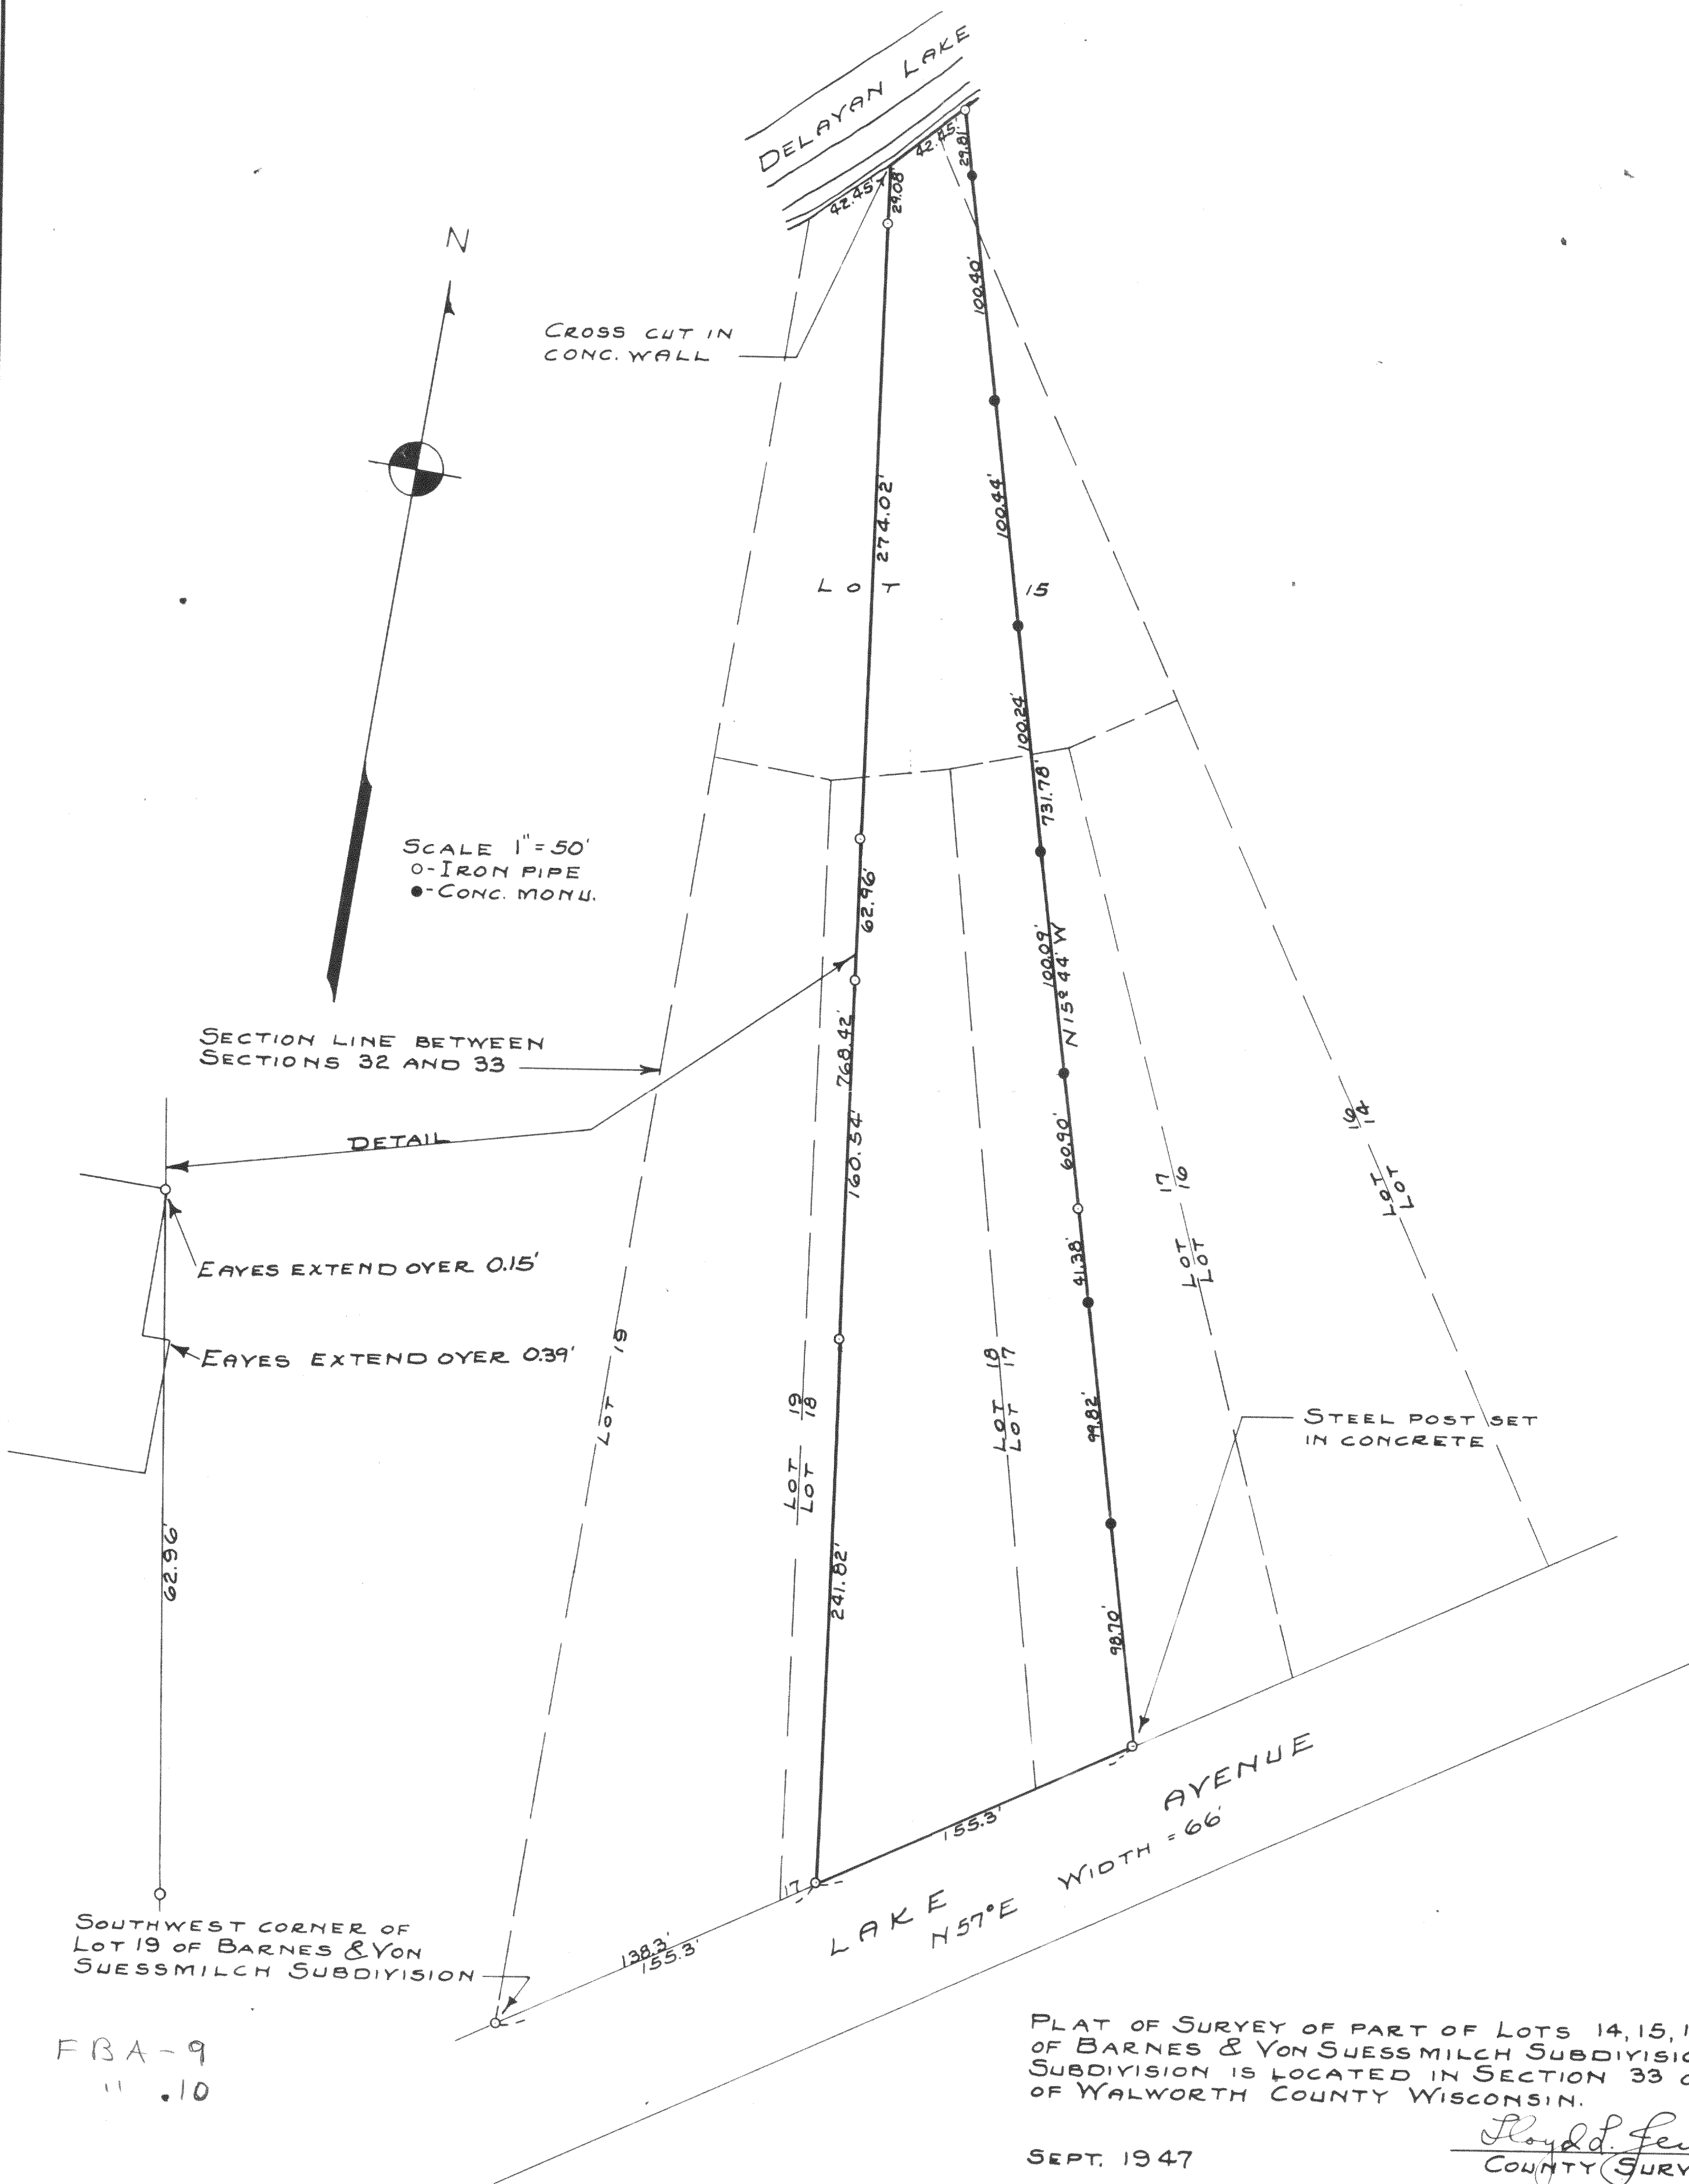

SEPT. 1947