


PLAT OF SURVEY OF LOT 5, BLOCK 2 OF ROYAL OAKS
SUBDIVISION LOCATED IN THE NE 1/4 OF THE SE 1/4 OF SECTION 3
T2N, R16E, WALWORTH COUNTY, WISCONSIN

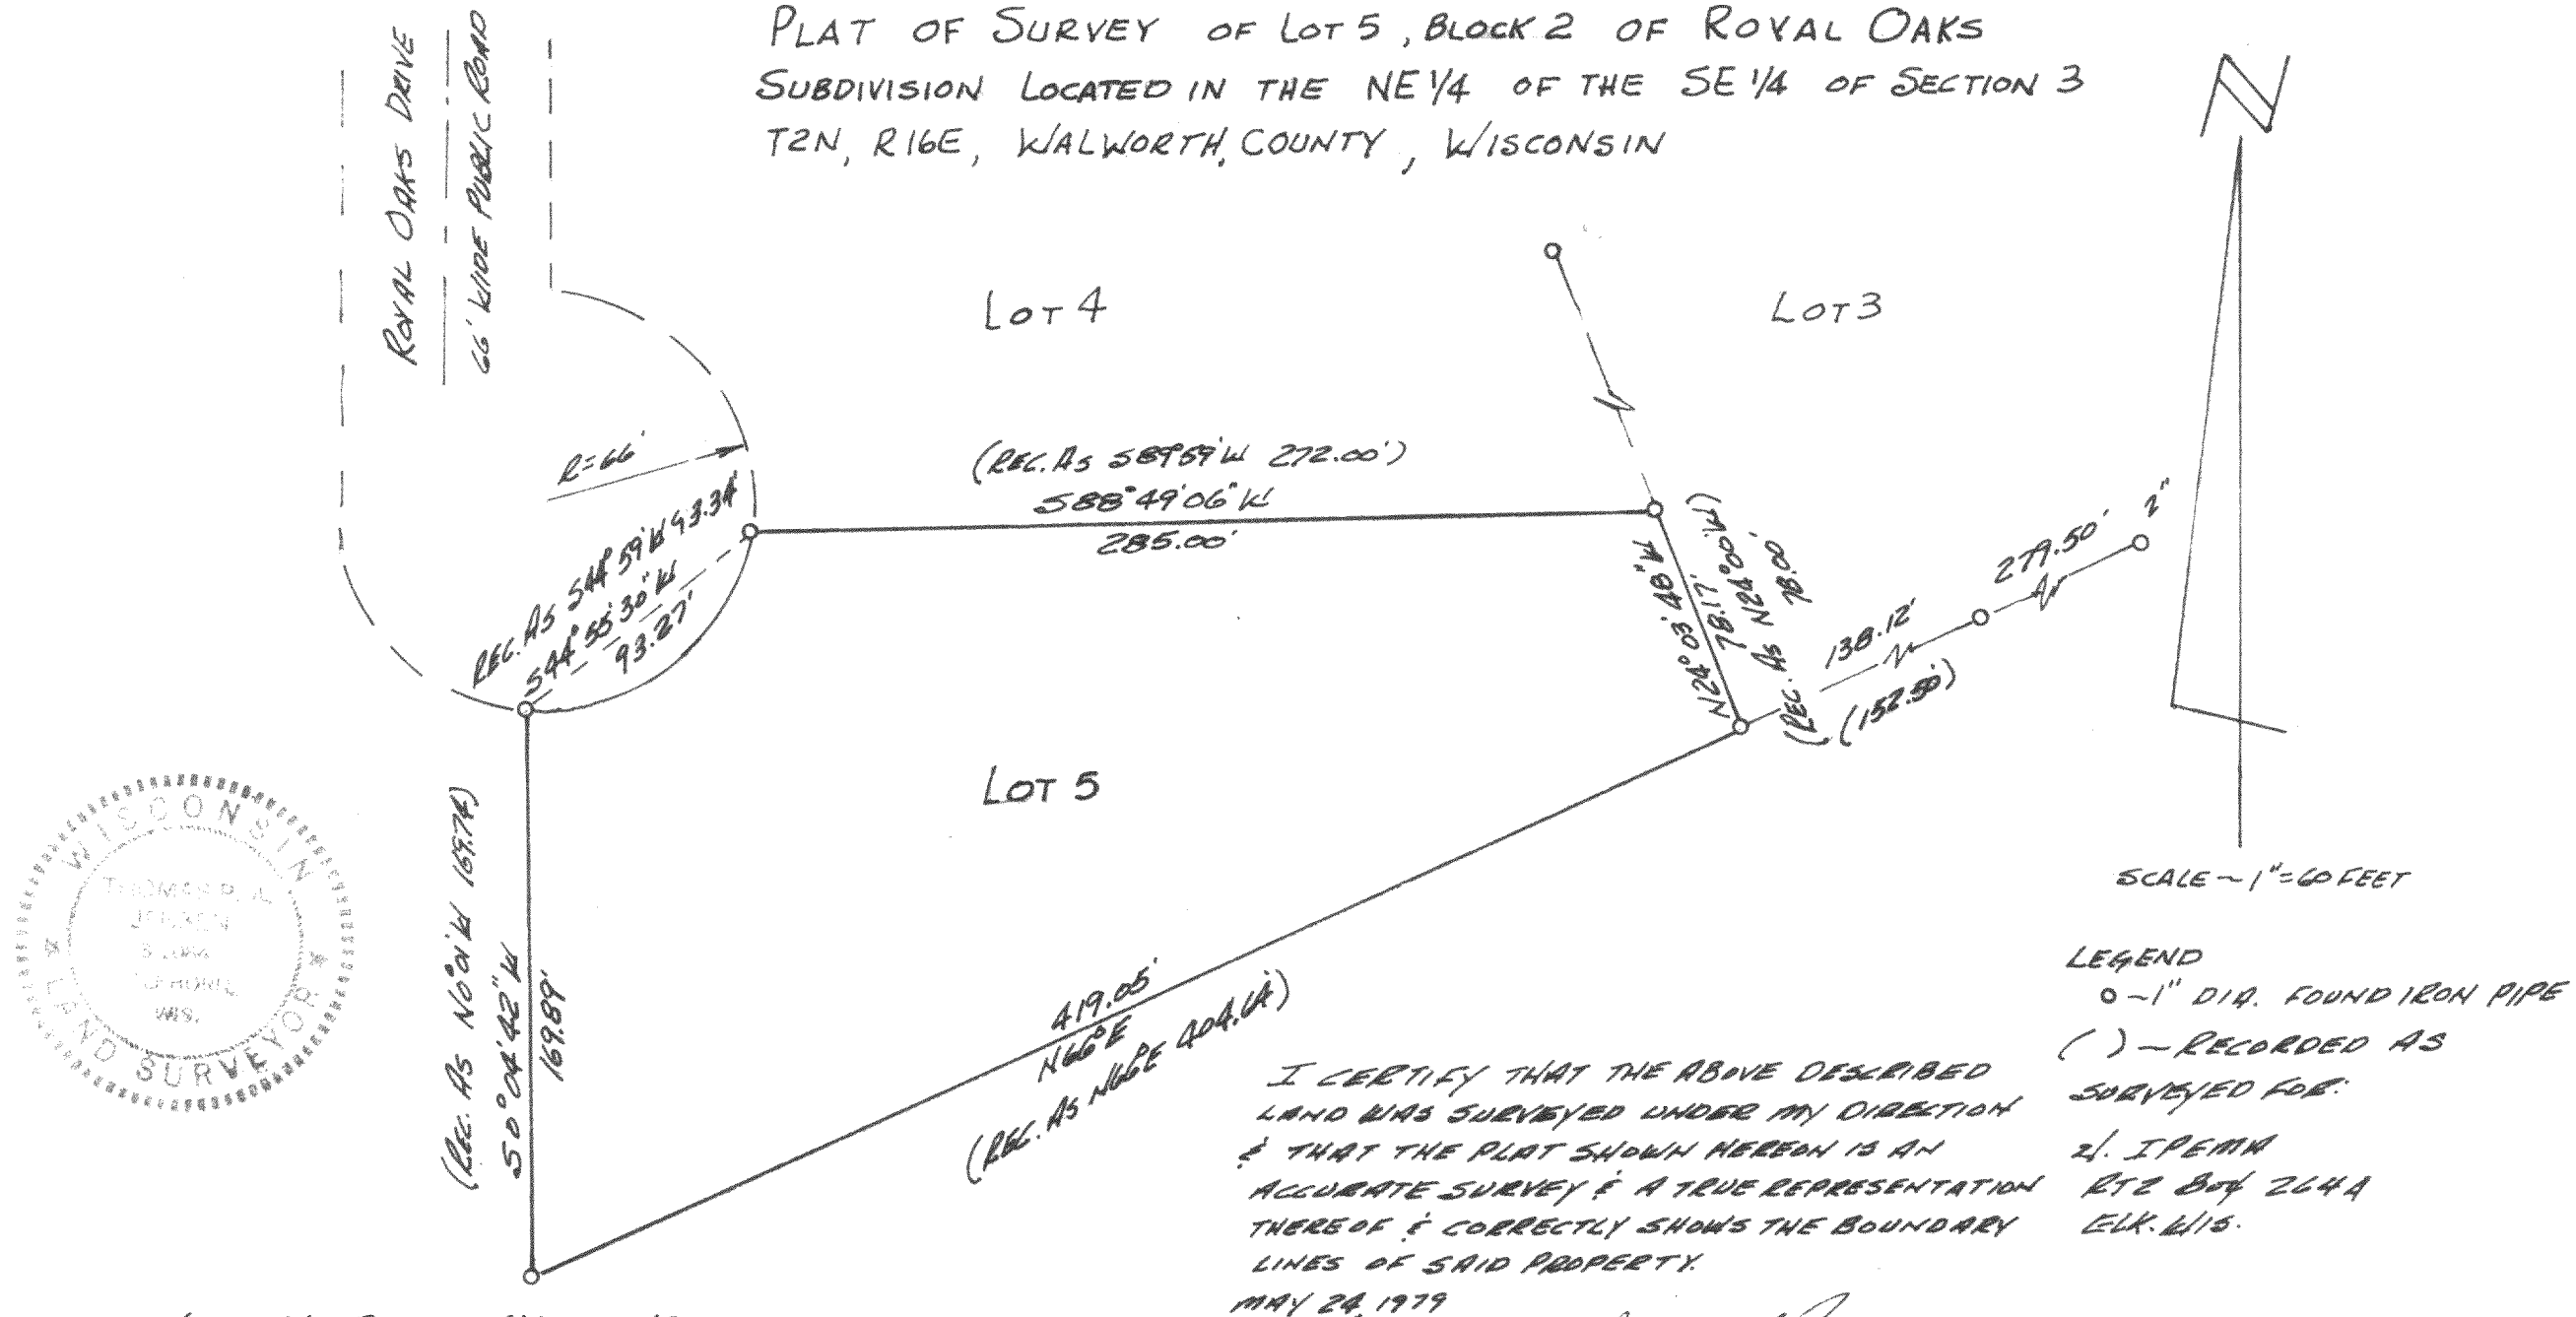

NOTE: WE FOUND ALL OF THE ORIGINAL IRON PIPE LOT CORNER MARKERS AND THE LOTS DO NOT MATCH THE RECORDED SUBD. PLAT.

FROL-9

I CERTIFY THAT THE ABOVE DESCRIBED
LAND WAS SURVEYED UNDER MY DIRECTION
& THAT THE PLAT SHOWN HEREON IS AN
ACCURATE SURVEY & A TRUE REPRESENTATION
THEREOF & CORRECTLY SHOWS THE BOUNDARY
LINES OF SAID PROPERTY.

MAY 24 1979

THOMAS P.A. JENSEN 5-1084
JENSEN SURVEYING & MAPPING
ELKHORN, WISCONSIN

LEGEND
 ○ - 1" DIA. FOUND IRON PIPE
 () - RECORDED AS
 SURVEYED FOR:

2. IPEMIN
RTZ 804 264A
ELK. 4/15.

216-709

77.027