


DELAYAN

LAKE

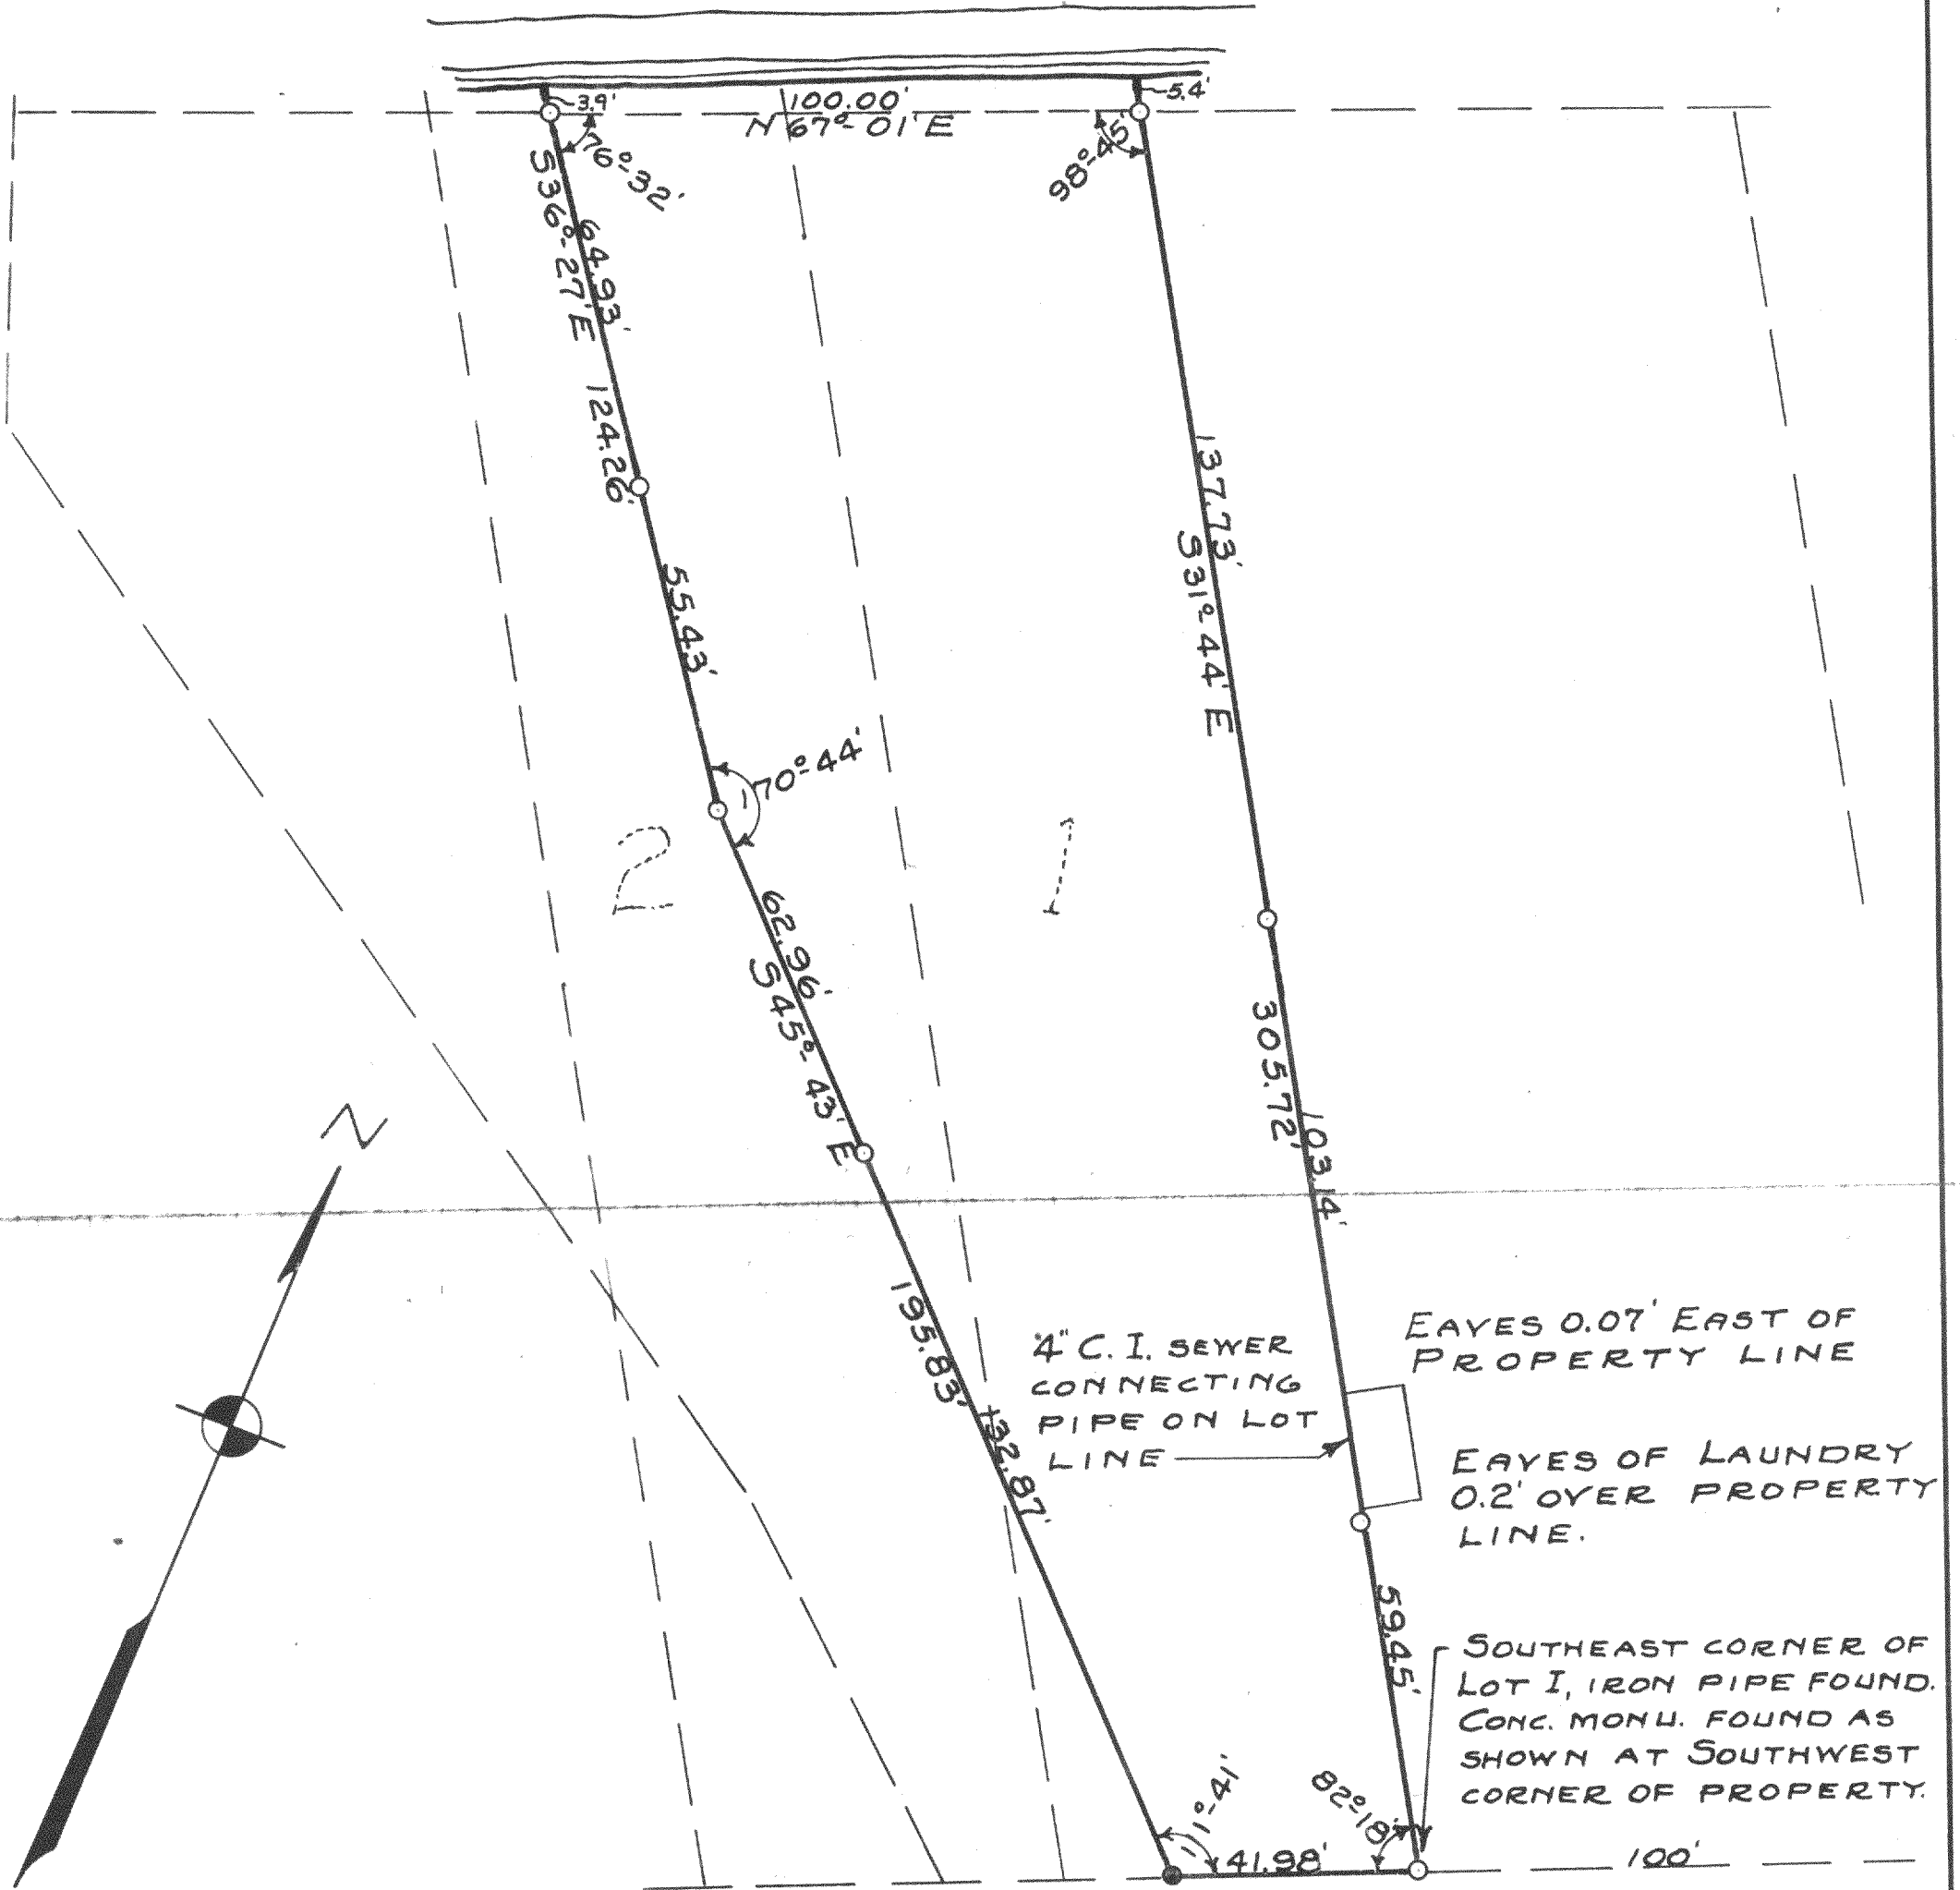

SCALE-1"=30'
 O = IRON PIPE
 ● = CONC. MONU.

PLAT OF SURVEY OF PART OF LOTS 1 AND 2
 OF THE PLAT OF SANS SOUCI, LOCATED IN
 SECTION 22, T2N R16E OF WALWORTH COUNTY
 WISCONSIN
 Nov. 1947

Lloyd L. Jensen
 COUNTY SURVEYOR

FSA-1