

OF

DEHAVAN LAKE

385°-16'E
117.49'

~~S58-57E~~
~~63.55~~

310°-53'W
116.56'

91.31

8.99

-5.73'

600

ENTIRE BUILDING
- LIES WITHIN
LARK ROAD
RIGHT OF WAY

8.79'

907.04'E

○ - 1 1/2" Ø IRON PIPE SET
⊖ - 1" Ø IRON PIPE FOUND
● - 1 1/2" Ø IRON PIPE FOUND



da

donohue & associates inc.
CONSULTING ENGINEERS
1000 W. 15th St., Suite 1000
Chicago, IL 60604
Tel: 312/467-1000
Fax: 312/467-1001
www.donohue-engineers.com

216-711D

PLAT OF SURVEY

OF
DELAVAN LAKE SANITARY DISTRICT LIFT STATION NO. 6

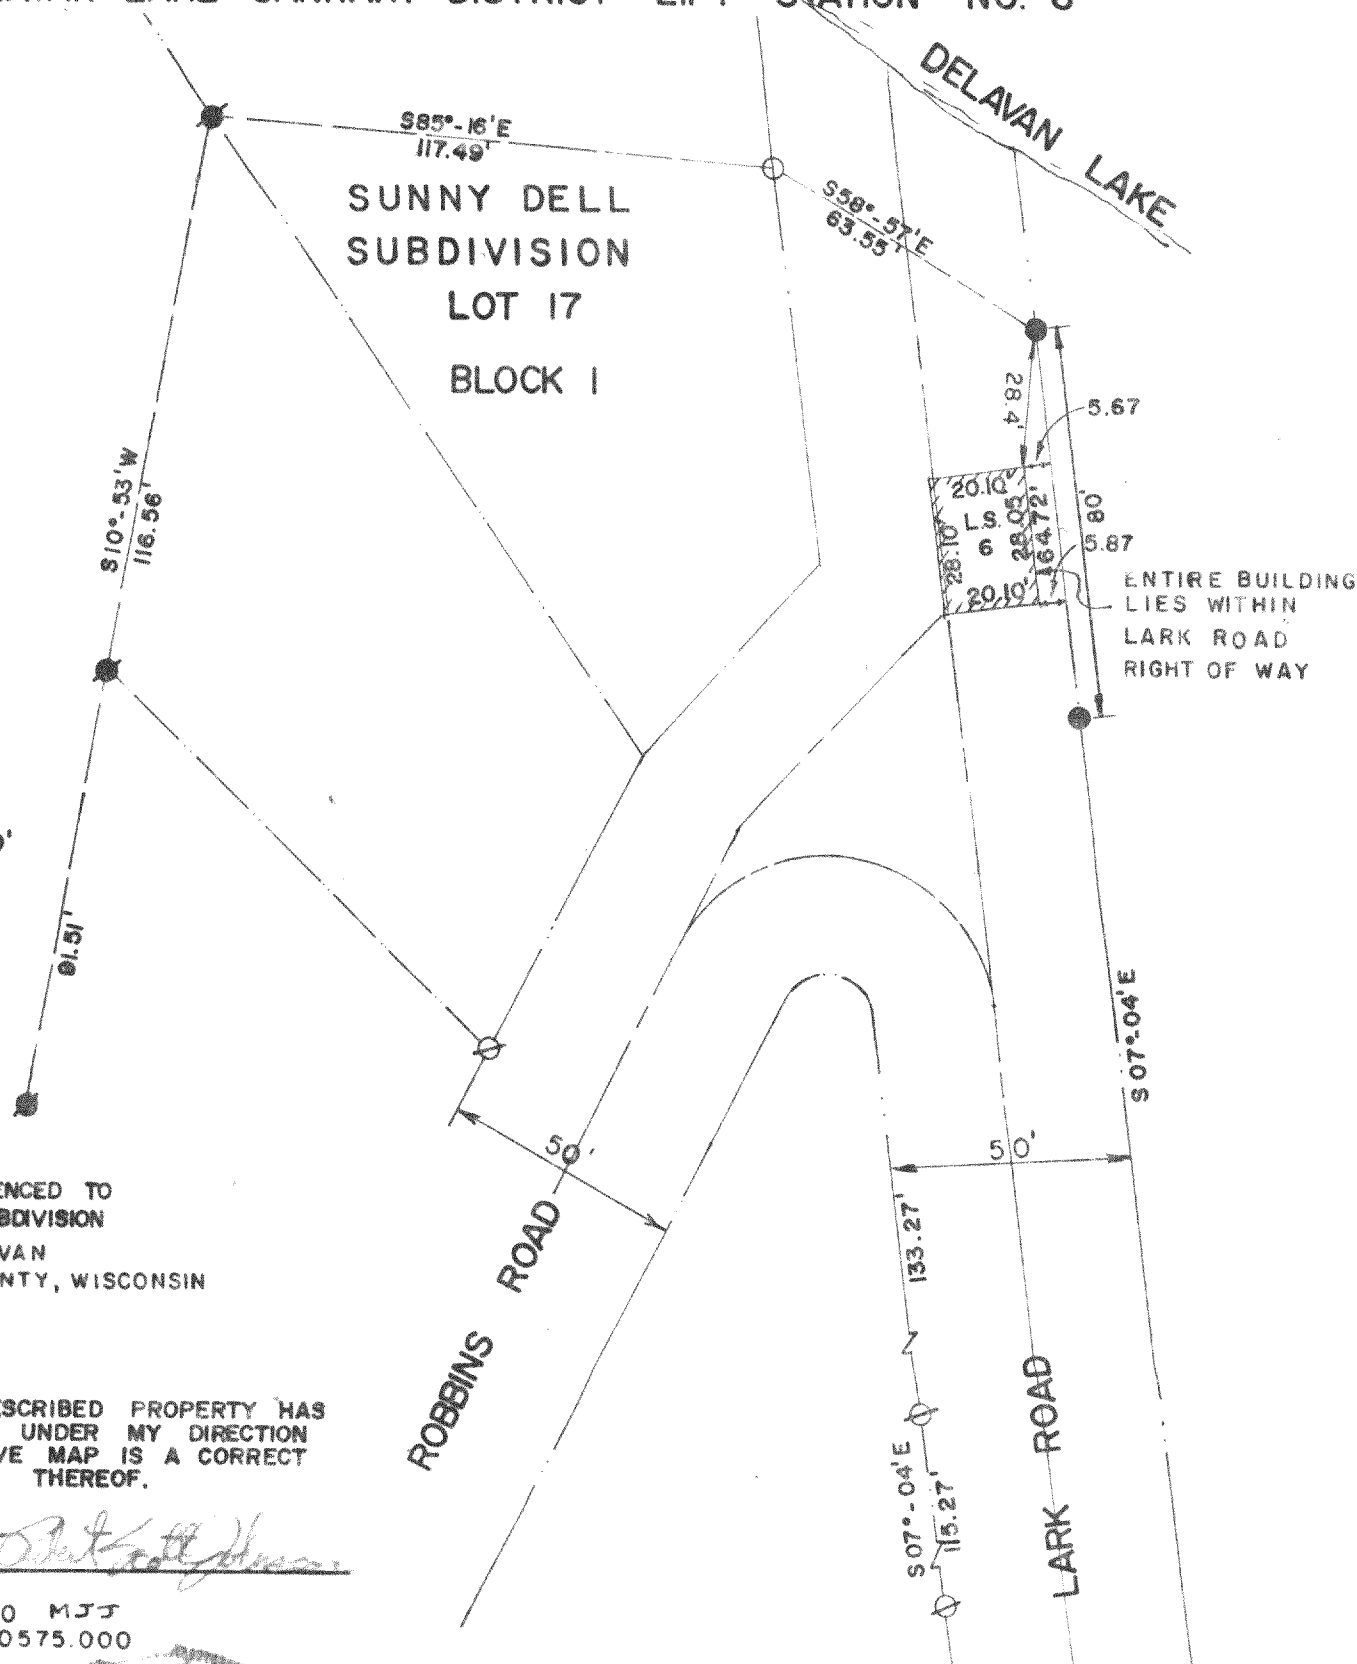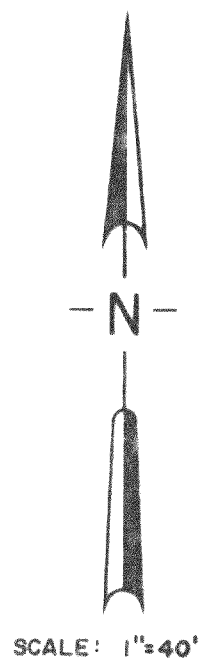


BEARINGS REFERENCED TO
SUNNY DELL SUBDIVISION
TOWN OF DELAVAN
WALWORTH COUNTY, WISCONSIN

CERTIFICATE

THE ABOVE DESCRIBED PROPERTY HAS
BEEN SURVEYED UNDER MY DIRECTION
AND THE ABOVE MAP IS A CORRECT
REPRESENTATION THEREOF.

JUNE 25, 1980

REVISED 11/5/80 MJS
PROJECT NO. 10575.000

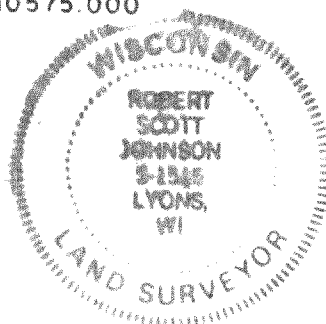

LEGEND

- - 1 1/2" IRON PIPE SET
- ⊙ - 1" IRON PIPE FOUND
- - 1 1/2" IRON PIPE FOUND
- - 3/4" IRON PIPE SET

SURVEY AND PLAT BY



donohue & associates inc.