

THE WEST 3/4 OF THE NORTHEAST 1/4 OF THE NORTHEAST 1/4 OF SECTION 3, TOWN 2 NORTH,
RANGE 16 EAST OF THE 4TH PRINCIPAL MERIDIAN, WALWORTH COUNTY, WISCONSIN

THE WEST 3/4 OF THE NORTHEAST 1/4 OF THE NORTHEAST 1/4 OF SECTION 3, TOWN 2 NORTH,
RANGE 16 EAST OF THE 4TH PRINCIPAL MERIDIAN, WALWORTH COUNTY, WISCONSIN

North '4
corner
Sec 3-2-16

JE corner
Dec-3-2-10

991.98'

AMES

LN line of NE 14 Sec. 3-2-16

Read:

2000

332.56'

North-South Quarter Section Line Sec. 3-2-100

PRIG

100

center of
Section 3-2-10

30.0

20.0


BLOCK
&
FRAME
SHED

Diagram of a rectangular frame labeled "FRAME GARAGE". The dimensions are indicated as 22.3 (width), 22.4 (height), and 22.4 (height).

30.2742 ACRES

331.06'

SCALE : 1" = 50'

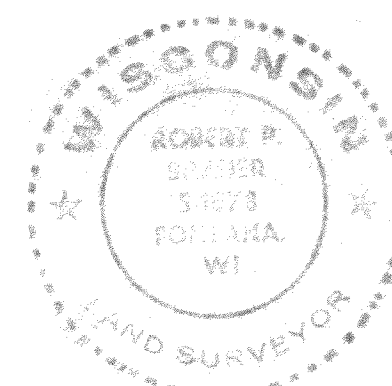

STATE OF WISCONSIN } G.S.
WALWORTH COUNTY }

I HEREBY CERTIFY THAT I HAVE SURVEYED THE ABOVE DESCRIBED PROPERTY AND THE ABOVE MAP IS A TRUE REPRESENTATION THEREOF AND SHOWS THE SIZE AND LOCATION OF THE PROPERTY, ITS EXTERIOR BOUNDARIES, THE LOCATION OF ALL VISIBLE STRUCTURES AND DIMENSIONS OF ALL PRINCIPLE BUILDINGS THEREON, BOUNDARY FENCES, APPARENT EASEMENTS, ROADS, AND VISIBLE ENCRoACHMENTS, IF ANY.

THIS SURVEY IS MADE FOR THE PRESENT OWNERS OF THE PROPERTY, AND ALSO THOSE WHO PURCHASE, MORTGAGE, OR GUARANTEE THE TITLE THERE TO WITHIN ONE YEAR FROM DATE THEREOF.

DATED AT FONTANA, WISCONSIN THIS 28TH DAY OF JANUARY, 1983.

Walt P. Bauer

ROBERT P. BRAUER RLS-1578

216-720-B