


WORTH COUNTY (WISCONSIN)
T.2 N.16 E.



C. J. DUNHAM SURVEY

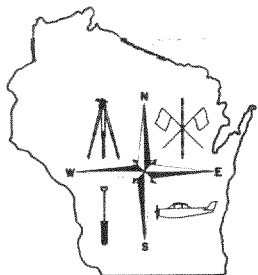

Sidler Surveying Company

709 Odana Lane, Madison, Wisconsin

(608)-274-4714

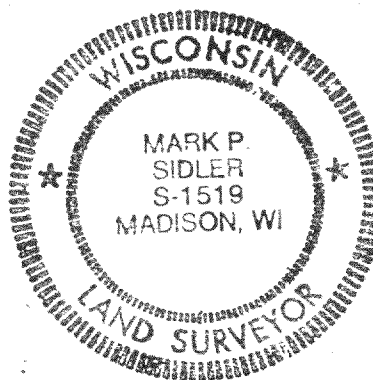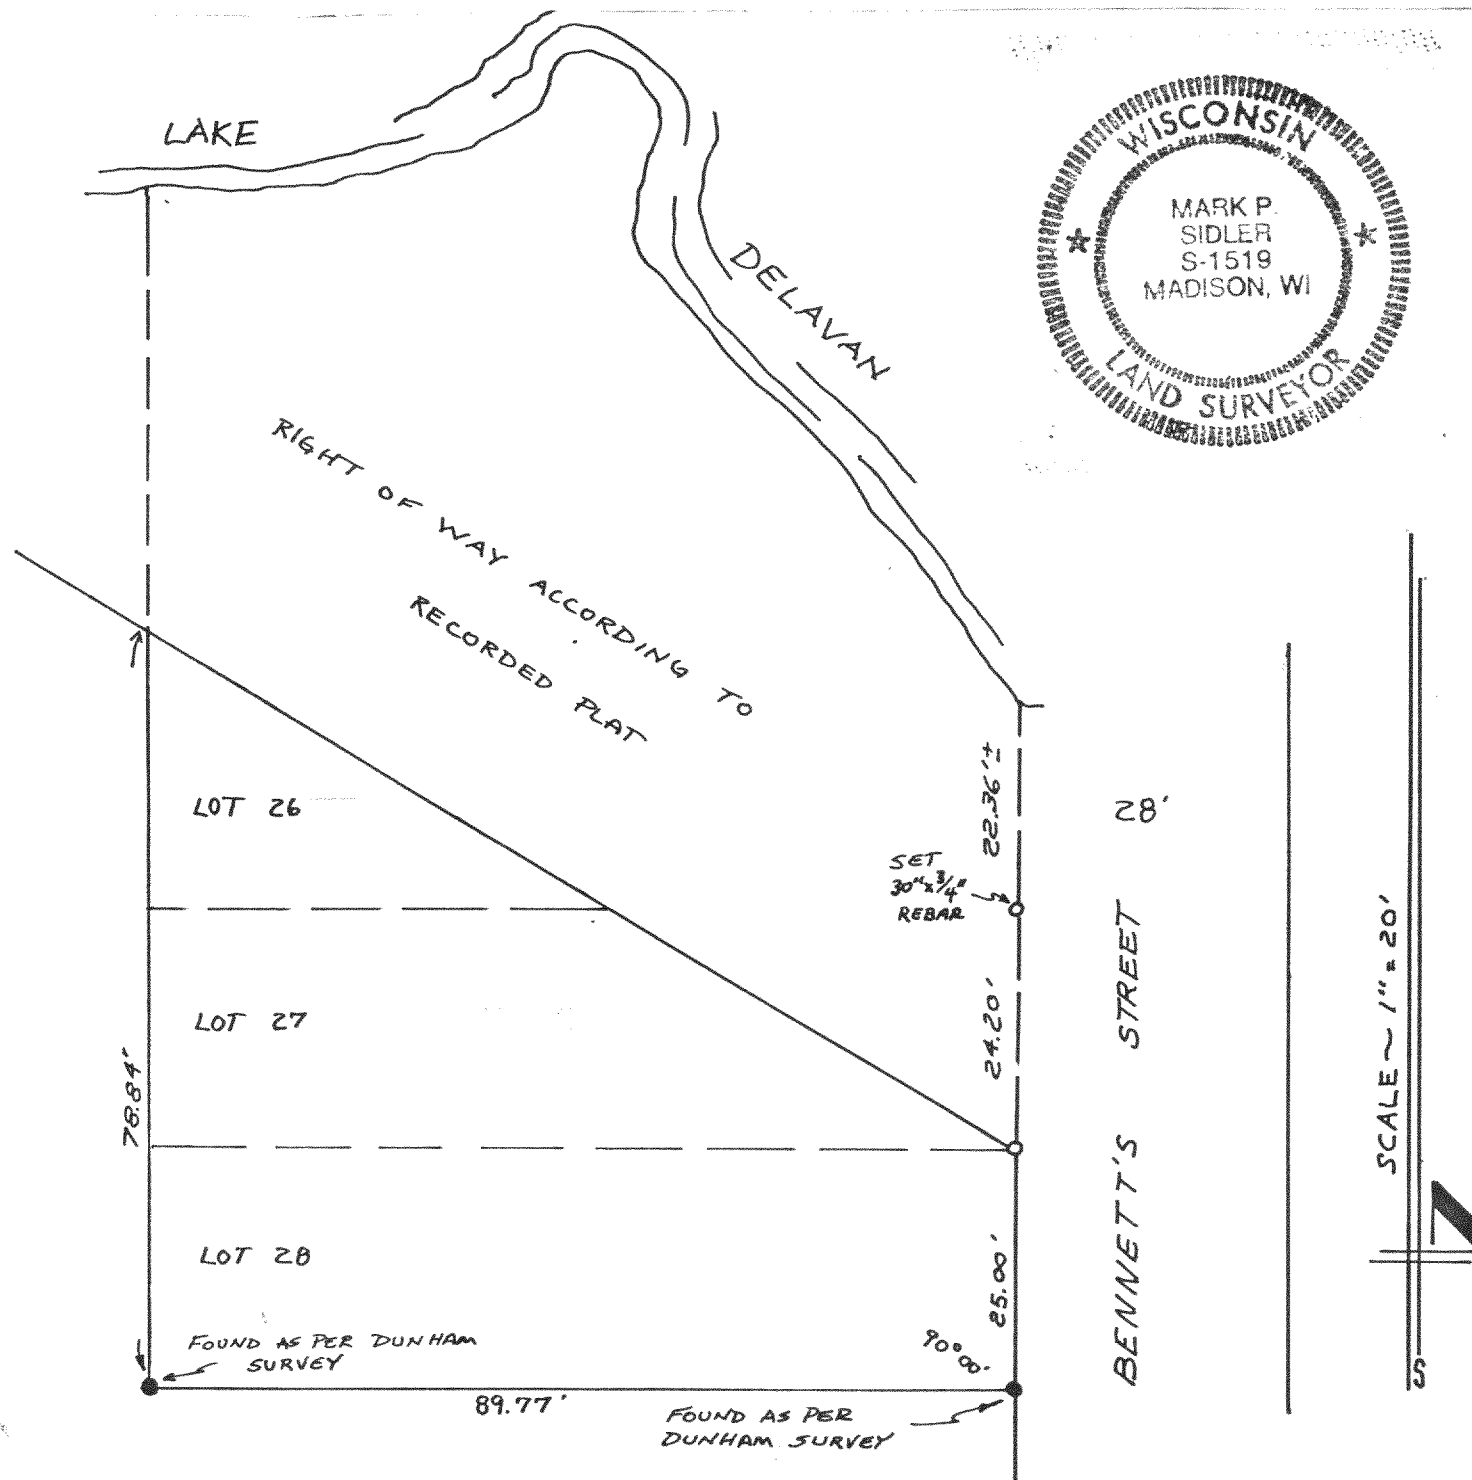

CERTIFICATE

I Mark P. Sidler, Registered Land Surveyor, S-1519 of the State of Wisconsin do hereby certify that the intent of this survey was to reset property irons obliterated by construction work. That these irons were set as per George T. Dunham's survey of Lots 26, 27 and 28, Block 2 of Robbins Subdivision located in Section 32, T.2 N., R.16 E. Walworth County, Wisconsin, and also the land lying between said lots and Lake Delavan and the extension of their side lot lines. Dated September 19, 1978 and to this extent I certify their accuracy.

Mark P. Sidler
Mark P. Sidler RLS-1519

OWNER:

JON JUSEVIC

Box 329 R.R. 4

DELAVAN, WISCONSIN 53115

DATE: 7/18/80 SSC-80-1035

LEGEND

○ SET 7/8"x2' REBAR

● FOUND 1" IRON PIPE