


DUNHAM SURVEYING, S.C.
SURVEYING & SUBDIVIDING
DELAVER, WISCONSIN 53115

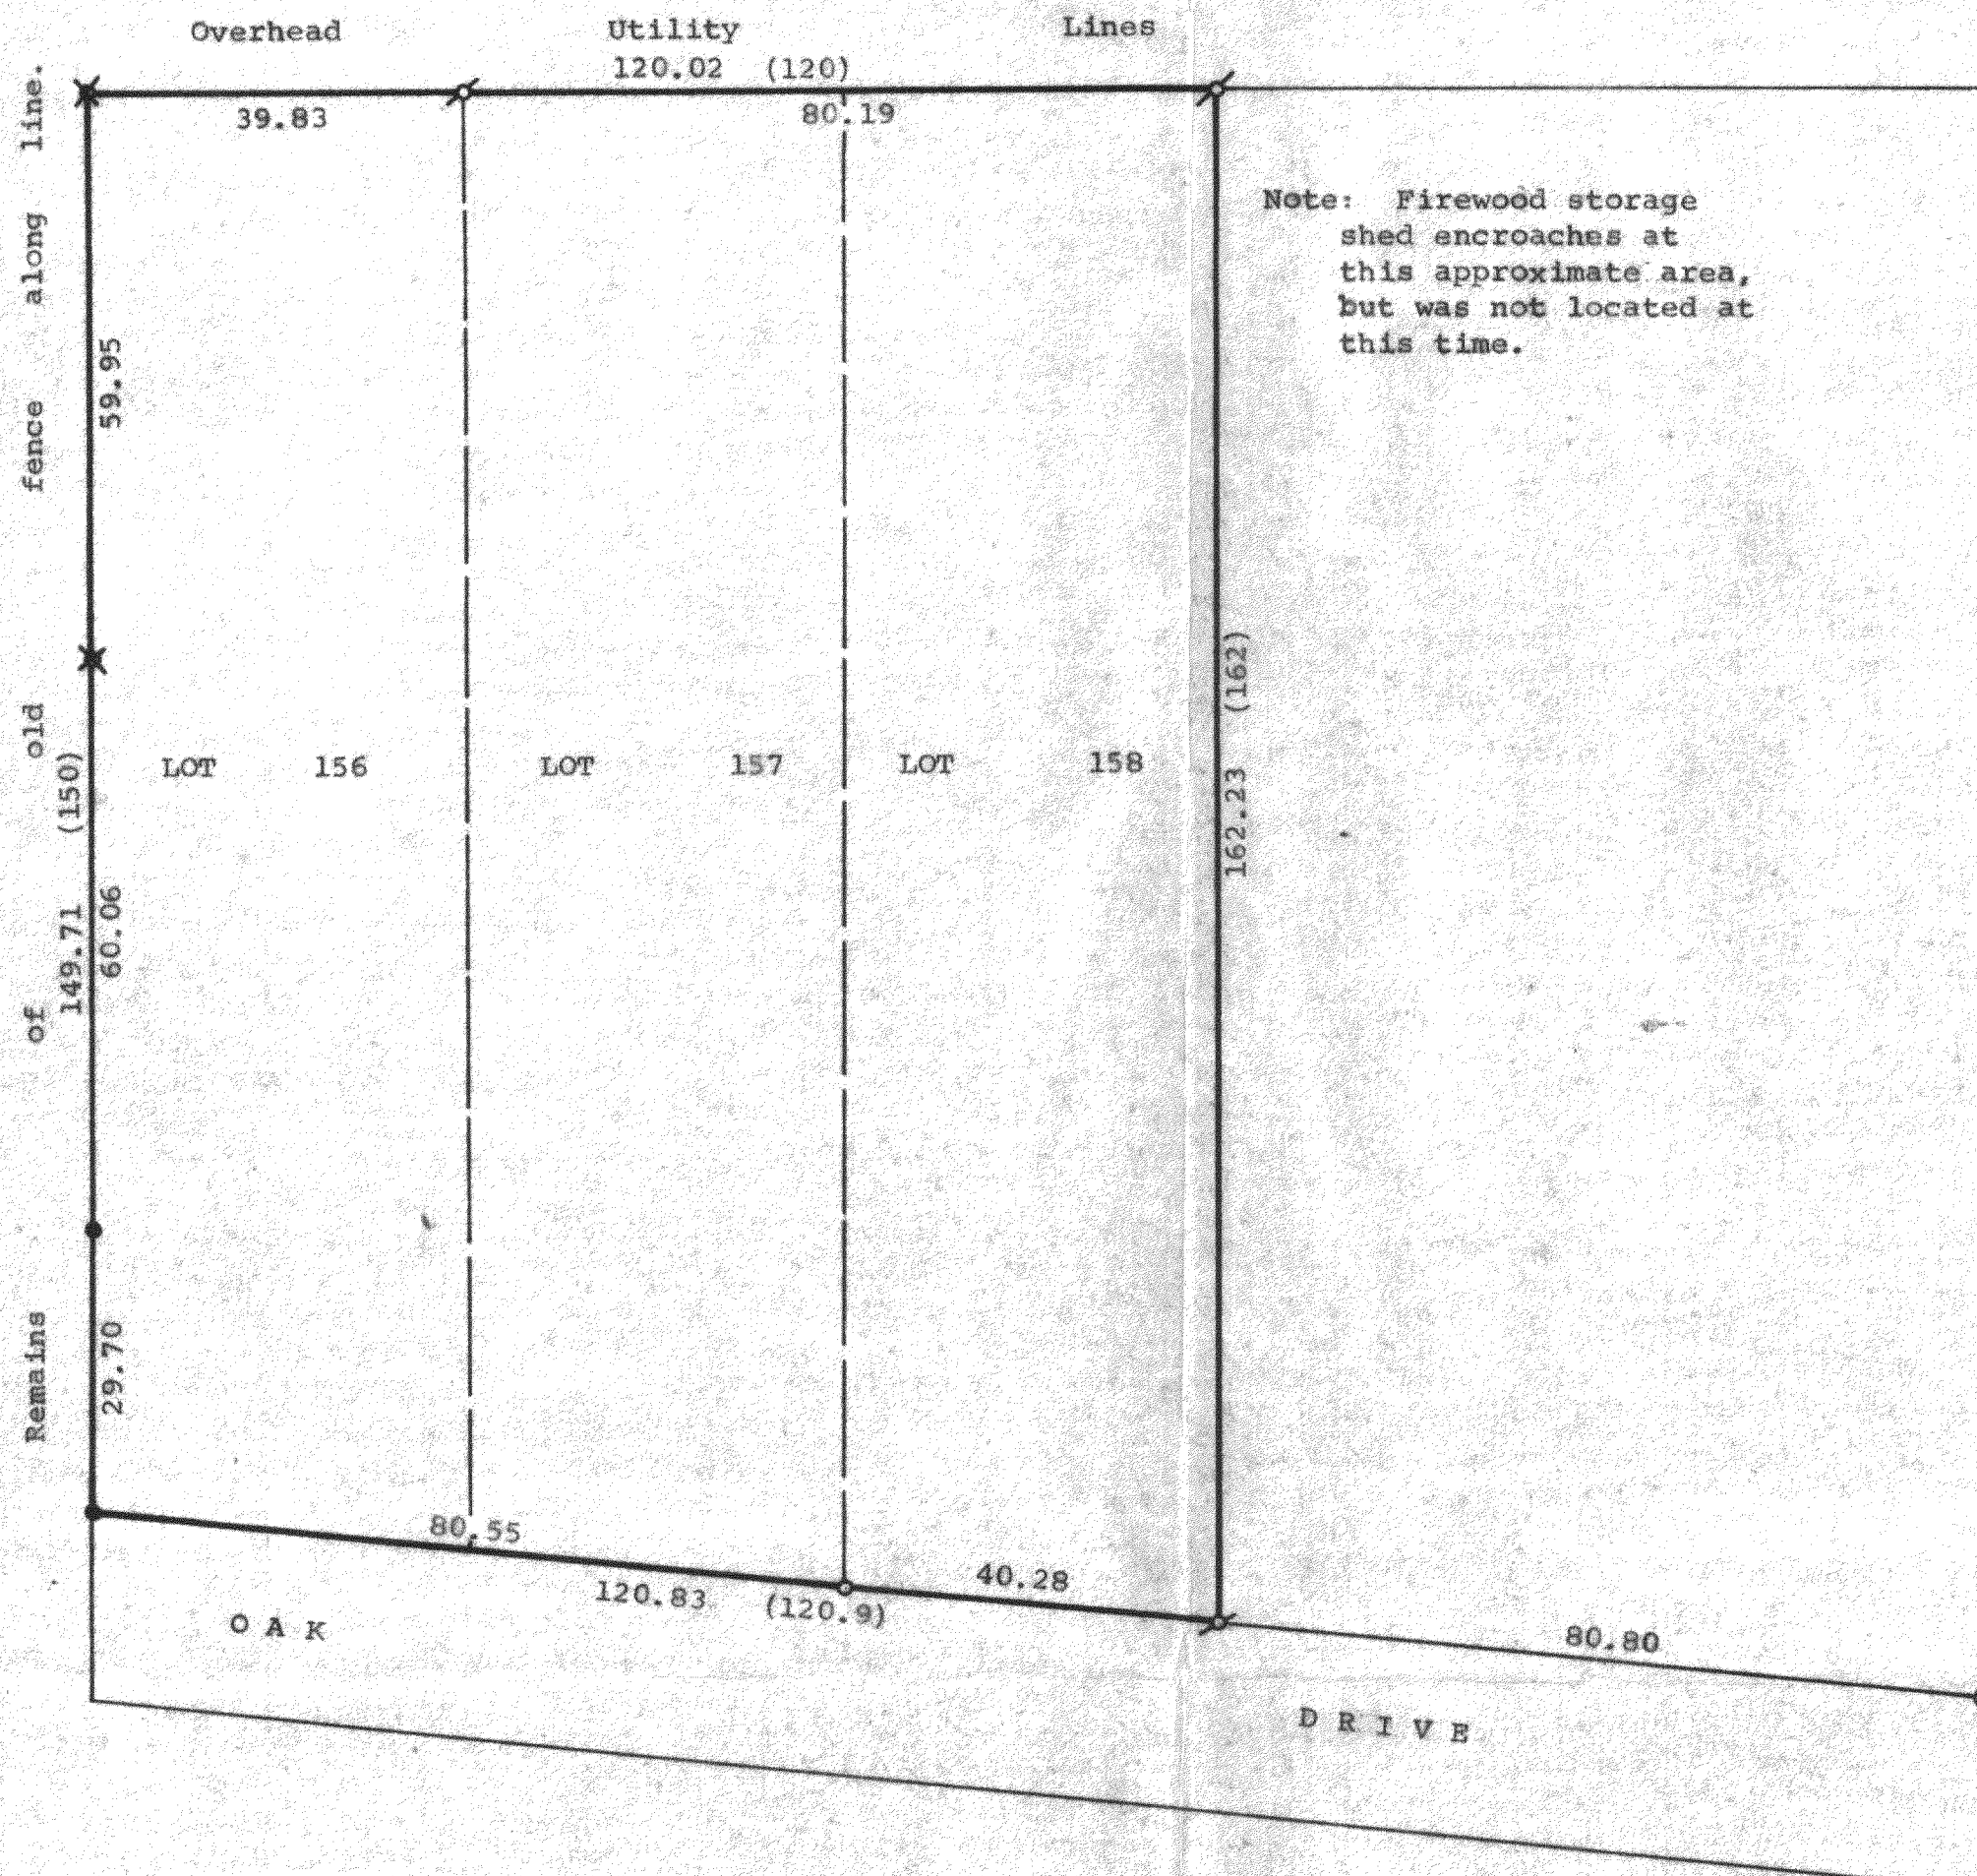

STATE OF WISCONSIN) SS
COUNTY OF WALWORTH)

I, James M. Dunham, Surveyor, certify that I have surveyed the property described as follows,
Lots 156, 157, and 158 of Krumhaar's 2nd Addition to Ravenswood, a subdivision located in Section 31, T2N, R16E, Walworth County, WI, and that the above map is a true representation thereof and shows the size and location of the property, its exterior boundaries, boundary fences, apparent easements, and roadways.
This survey is made for the use of the present owners of the property, and also those who purchase, mortgage, or guarantee the title thereto within one (1) year from date hereof.
November 25, 1980.

James M. Dunham
James M. Dunham, Surveyor

