




SCALE - 1" = 5'
o = IRON PIPE

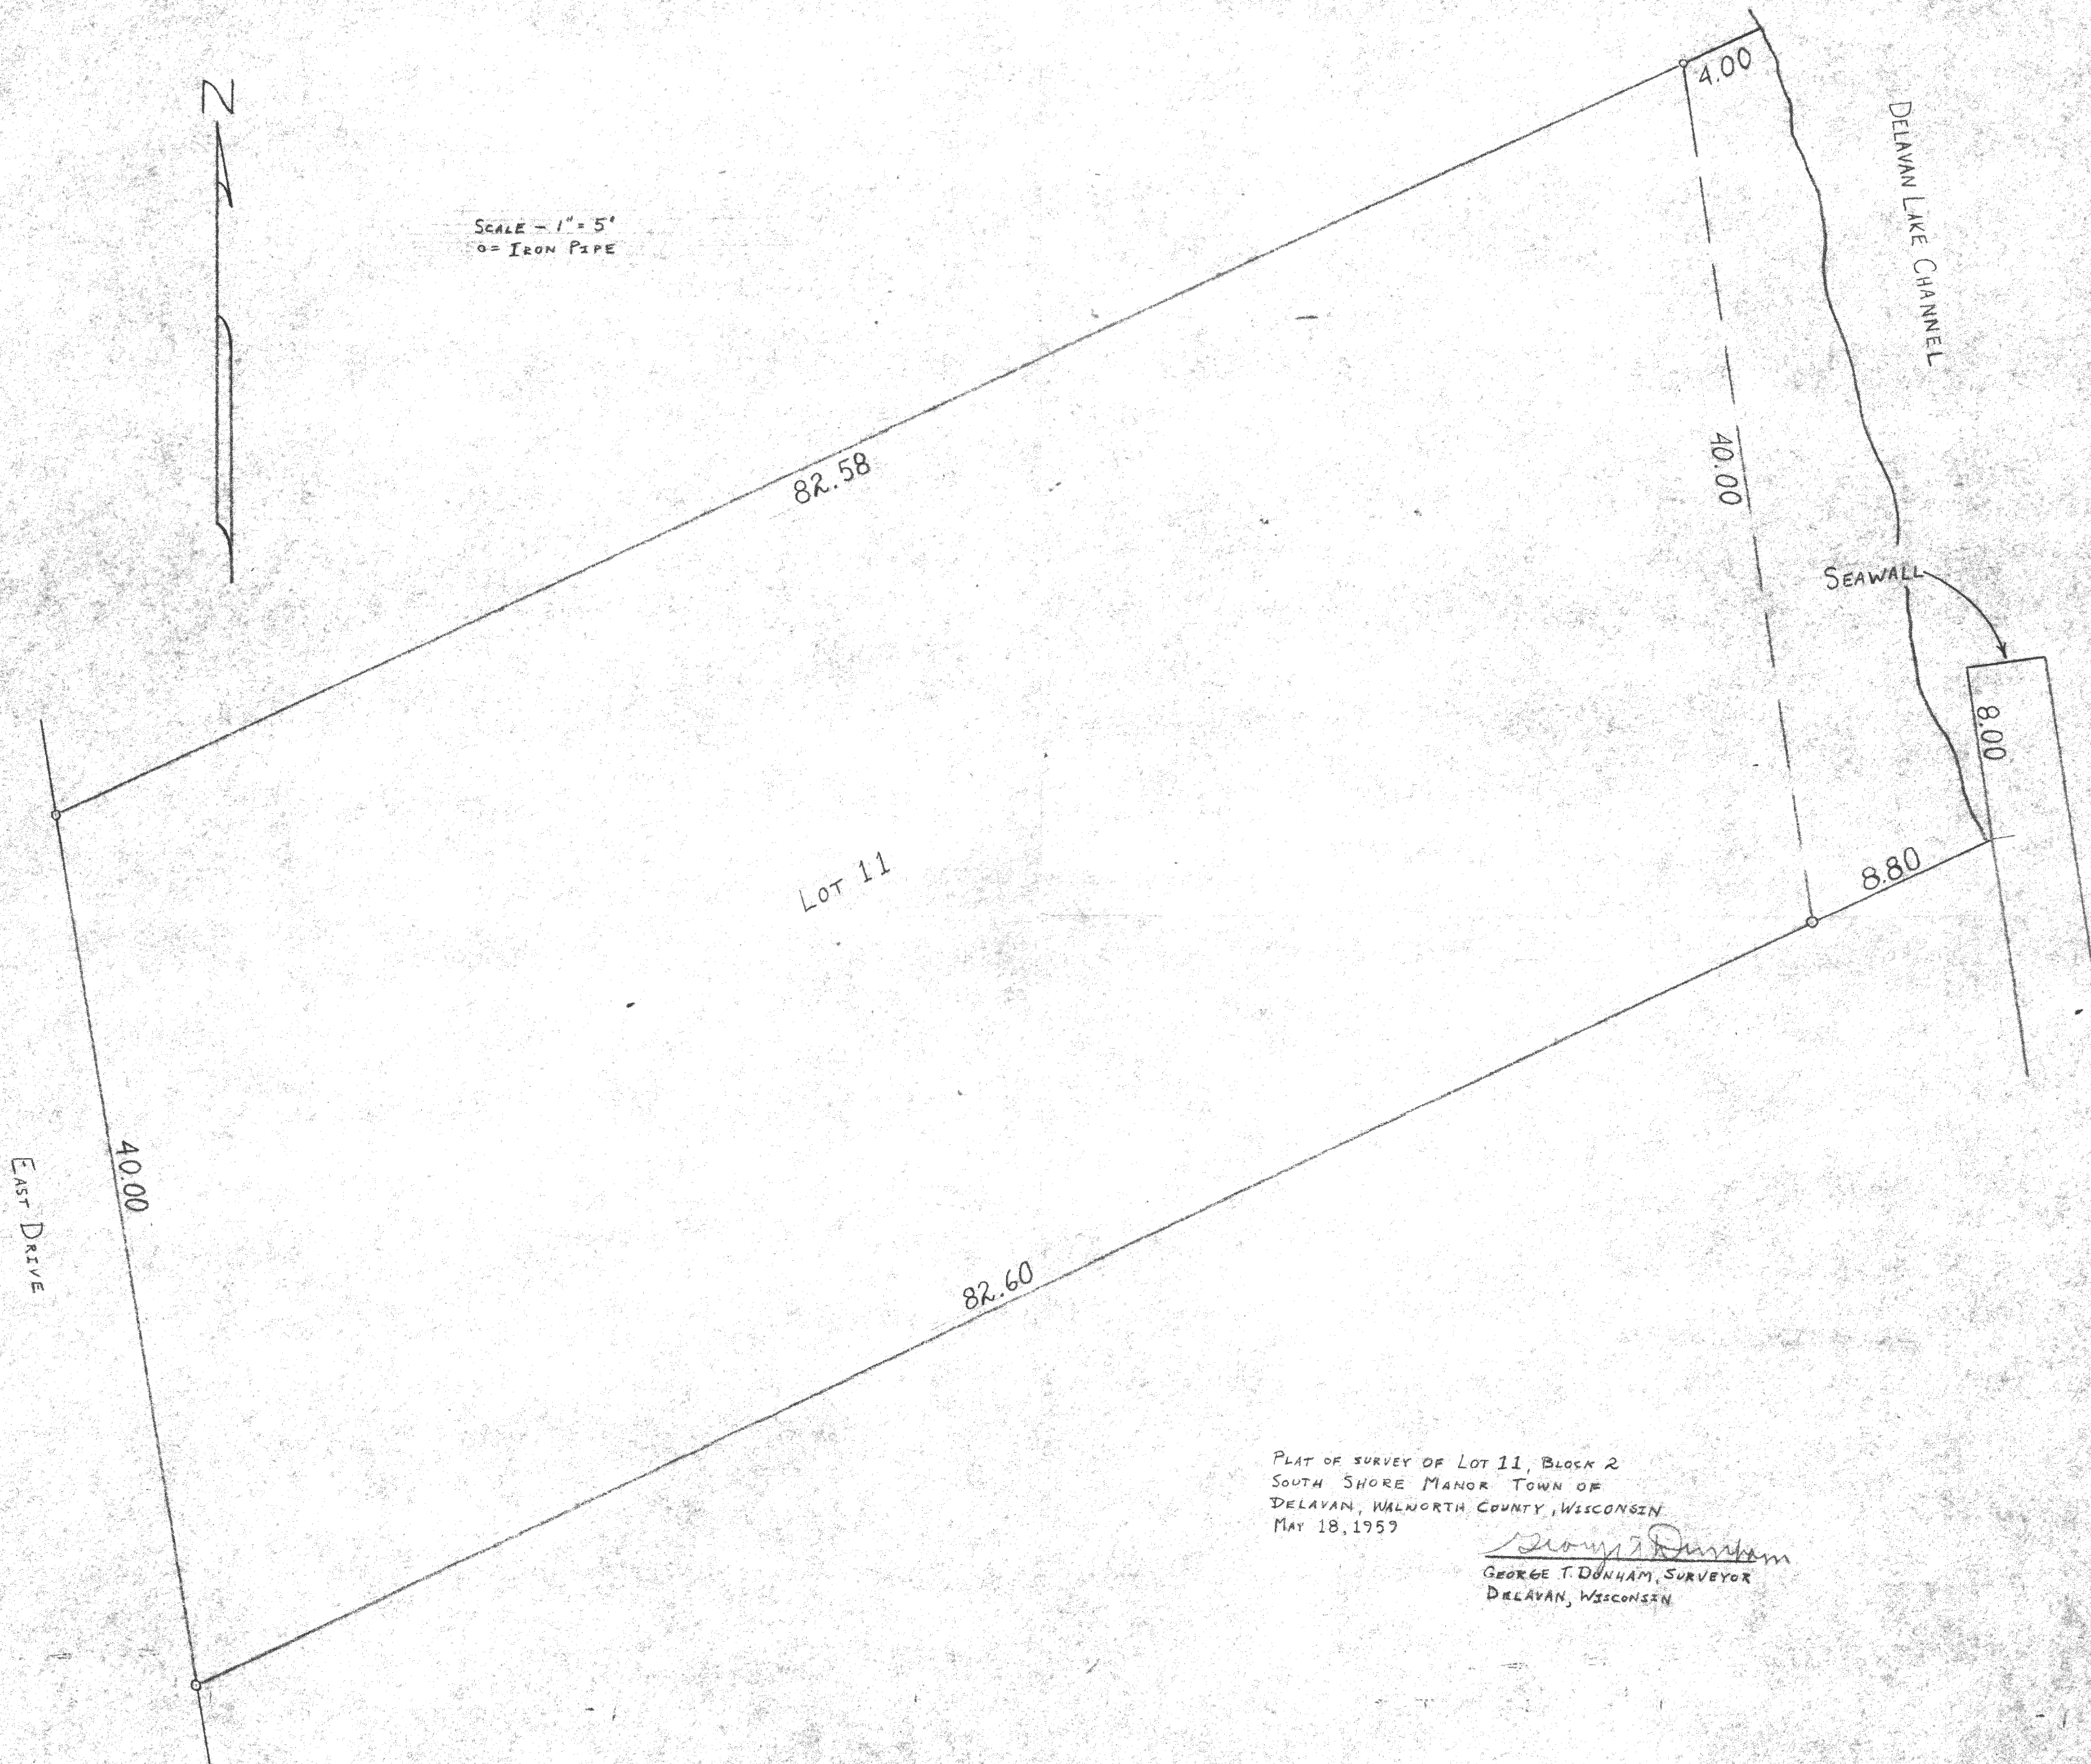

PLAT OF SURVEY OF LOT 11, BLOCK 2
SOUTH SHORE MANOR TOWN OF
DELAHAN, WALNORTH COUNTY, WISCONSIN
MAY 18, 1959

George T. Donham
GEORGE T. DONHAM, SURVEYOR
DELAHAN, WISCONSIN