


DUNHAM SURVEYING, S.C.  
SURVEYING & SUBDIVIDING  
DELAVAL, WISCONSIN 53115



Scale - 1" = 20'  
◎ = Iron Pipe Found  
○ = Iron Pipe Set  
● = Utility Pole  
(0.00) = Recorded As

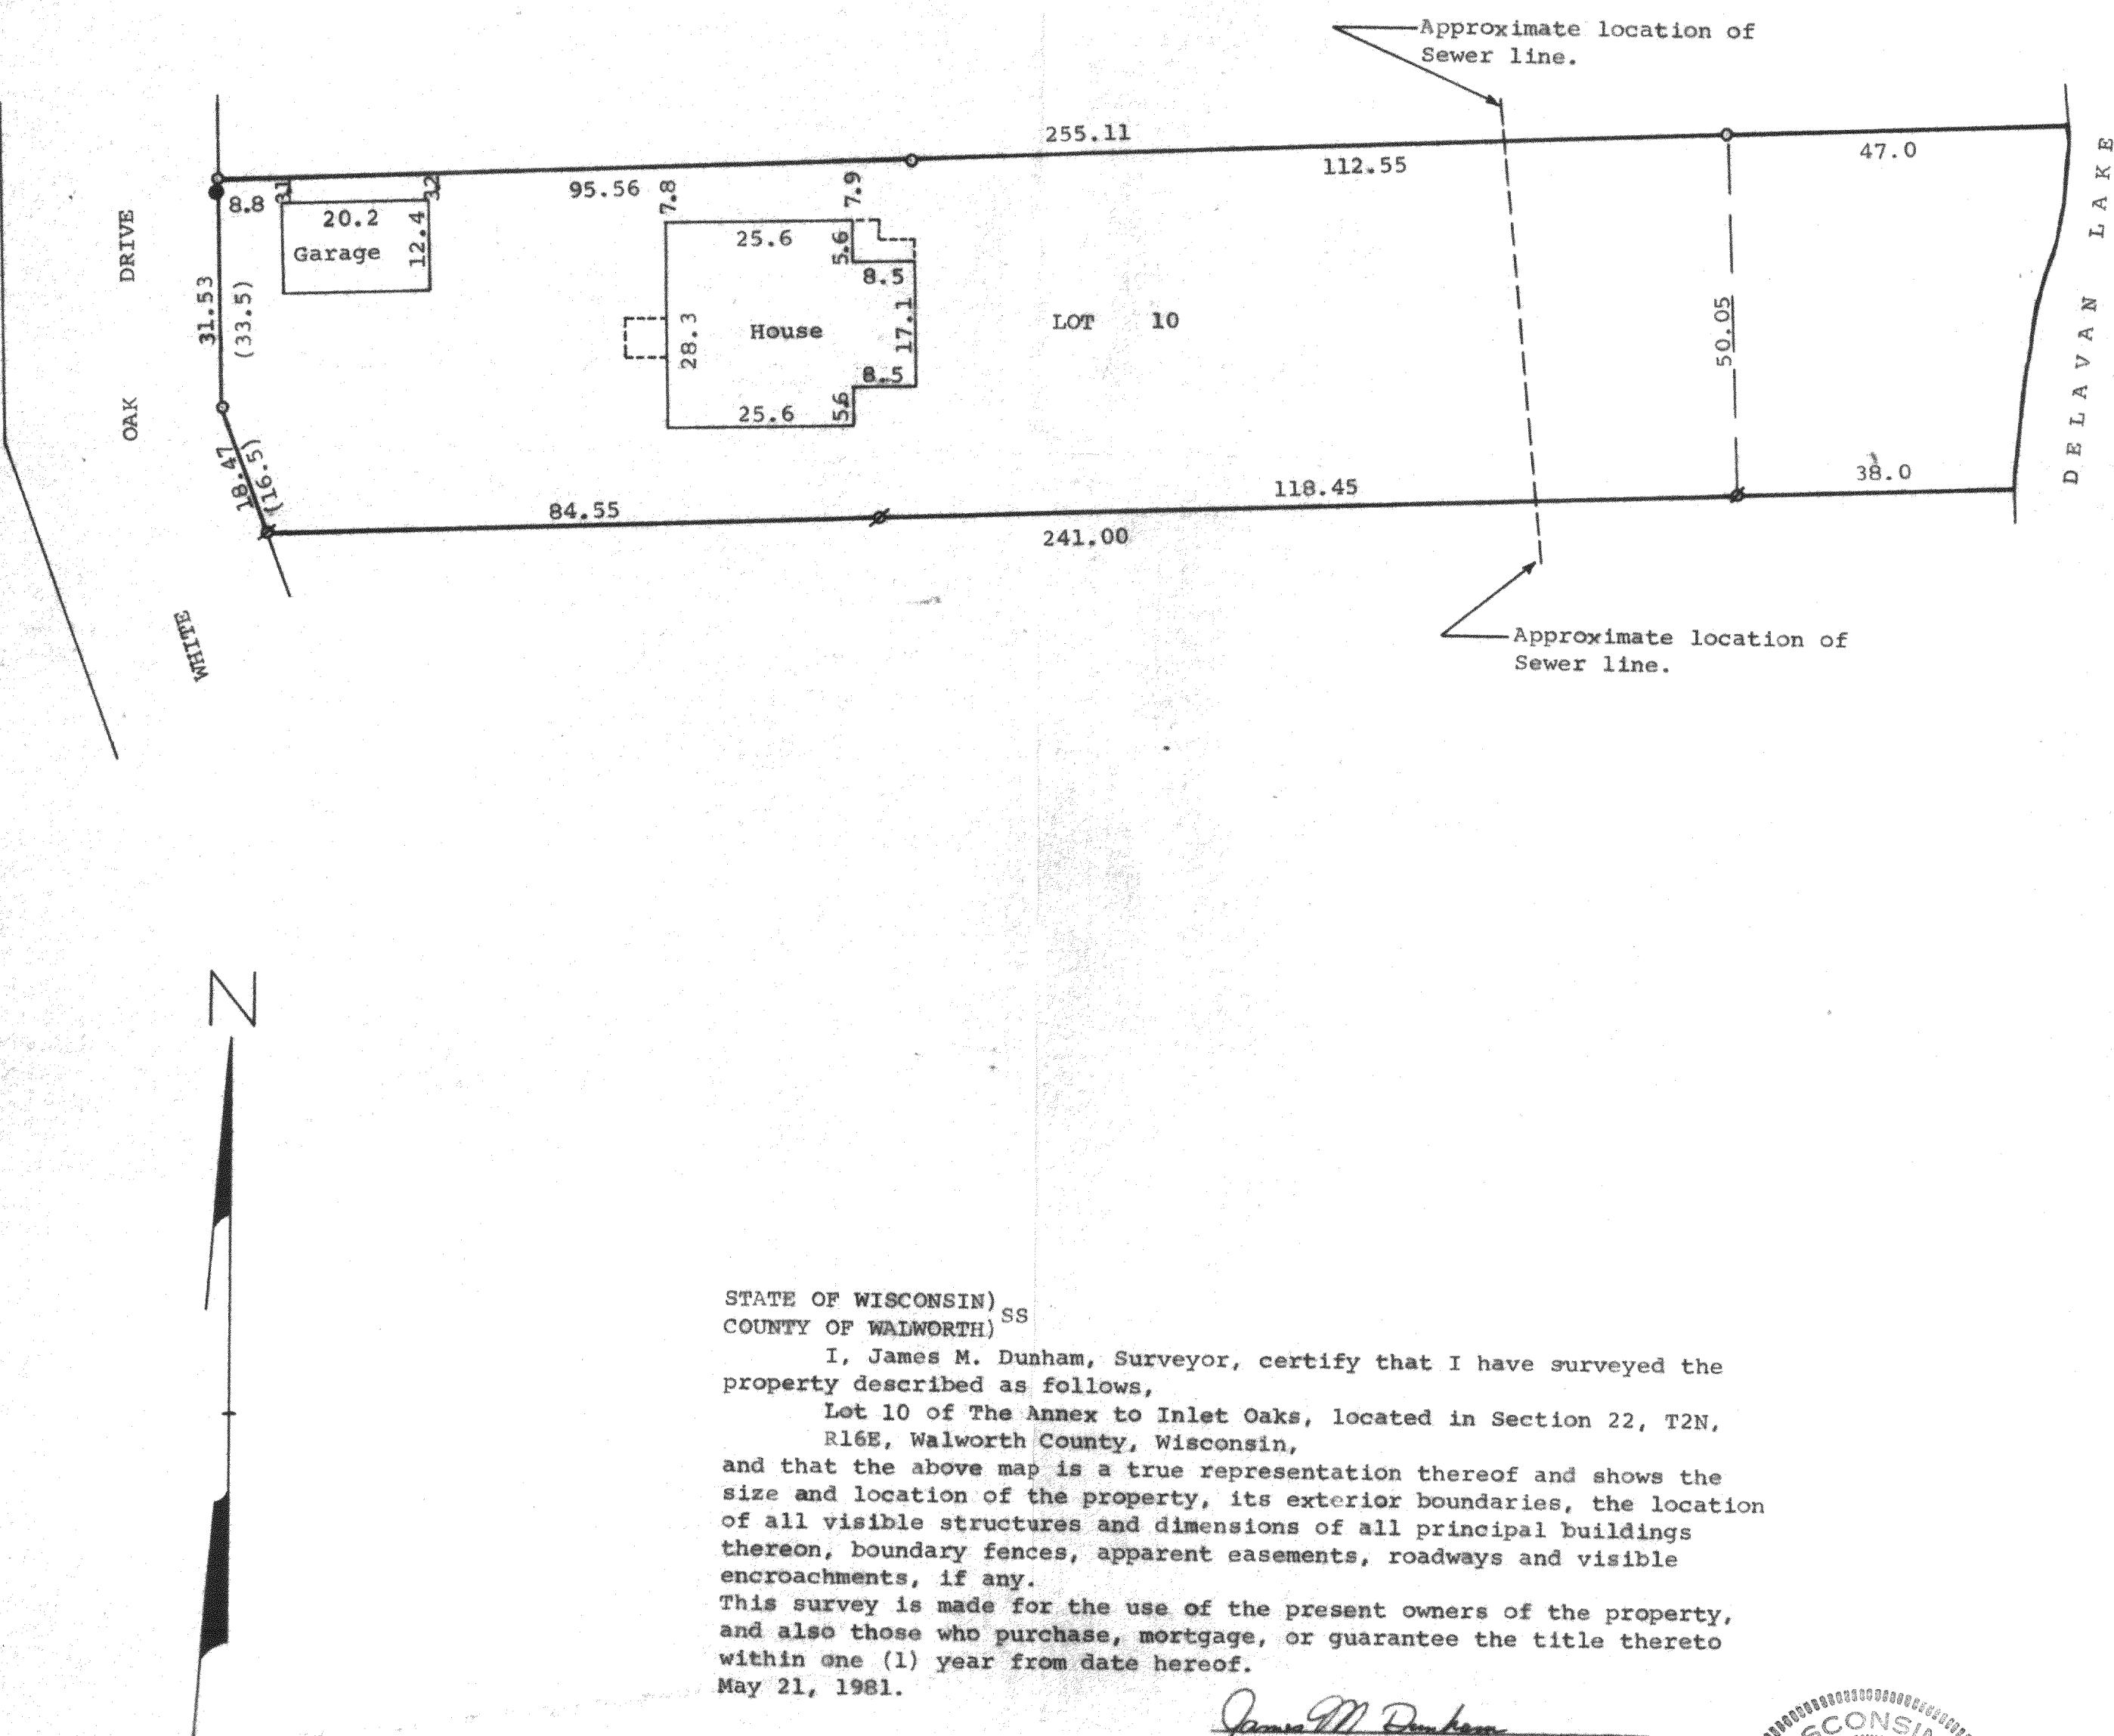