


FARRIS, HANSEN & COOPER, INC.

ENGINEERING, SURVEYING AND LAND PLANNING
715 W. WALWORTH ST. - P.O. BOX 487 - ELKHORN, WI 53121
OFFICE: 414/723-2098

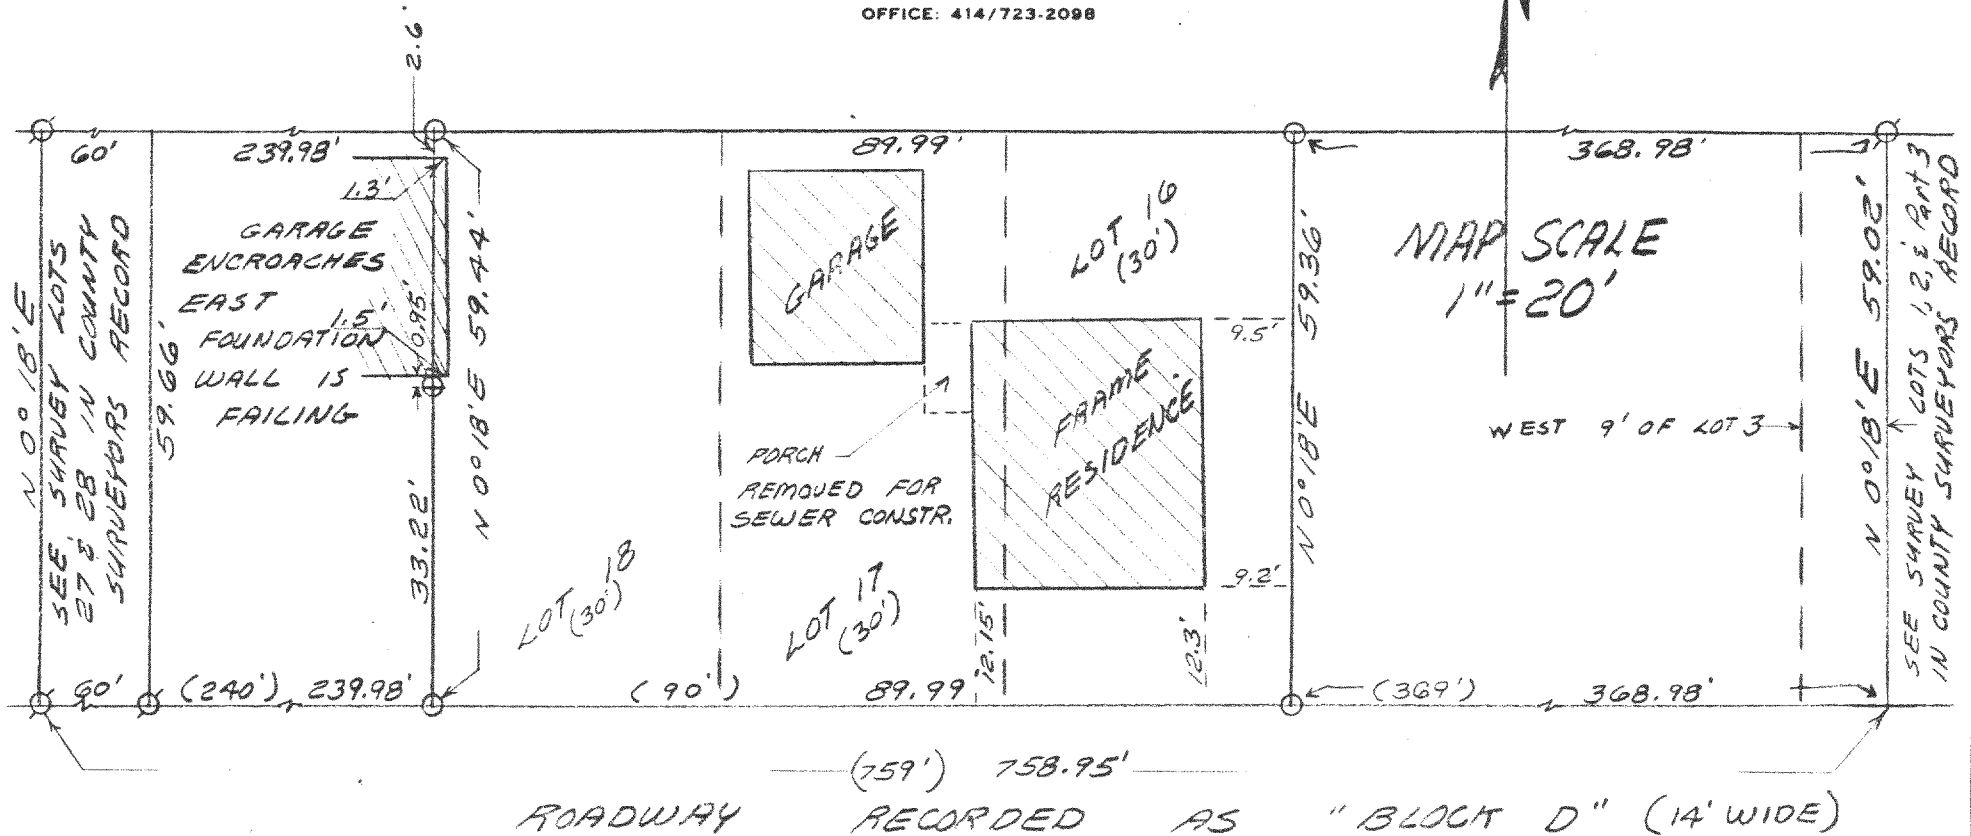

○ = IRON PIPE SURVEY STAKE FOUND
○ = 1"X24" IRON PIPE STAKE SET
(xxx) = RECORD DIMENSION

I hereby certify that at the direction of Mick Theobald I have surveyed LOTS 16, 17, & 18 OF BLOCK A OF JACKSONS SUBDIVISION located in the Southeast 1/4 of Section 21, Town of Delavan, Walworth County, Wisconsin and that this plat is a true and accurate representation of the lot lines and structures shown to the best of my professional knowledge and belief.

Dated this 14th day of OCT., 1982

Robert A. Farris
Robert A Farris, R.L.S



DRAWING NUMBER 2020