
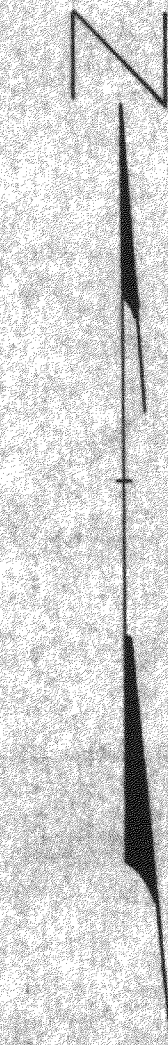



DUNHAM SURVEYING, S.C.
SURVEYING & SUBDIVIDING
DELAVER, WISCONSIN 53115

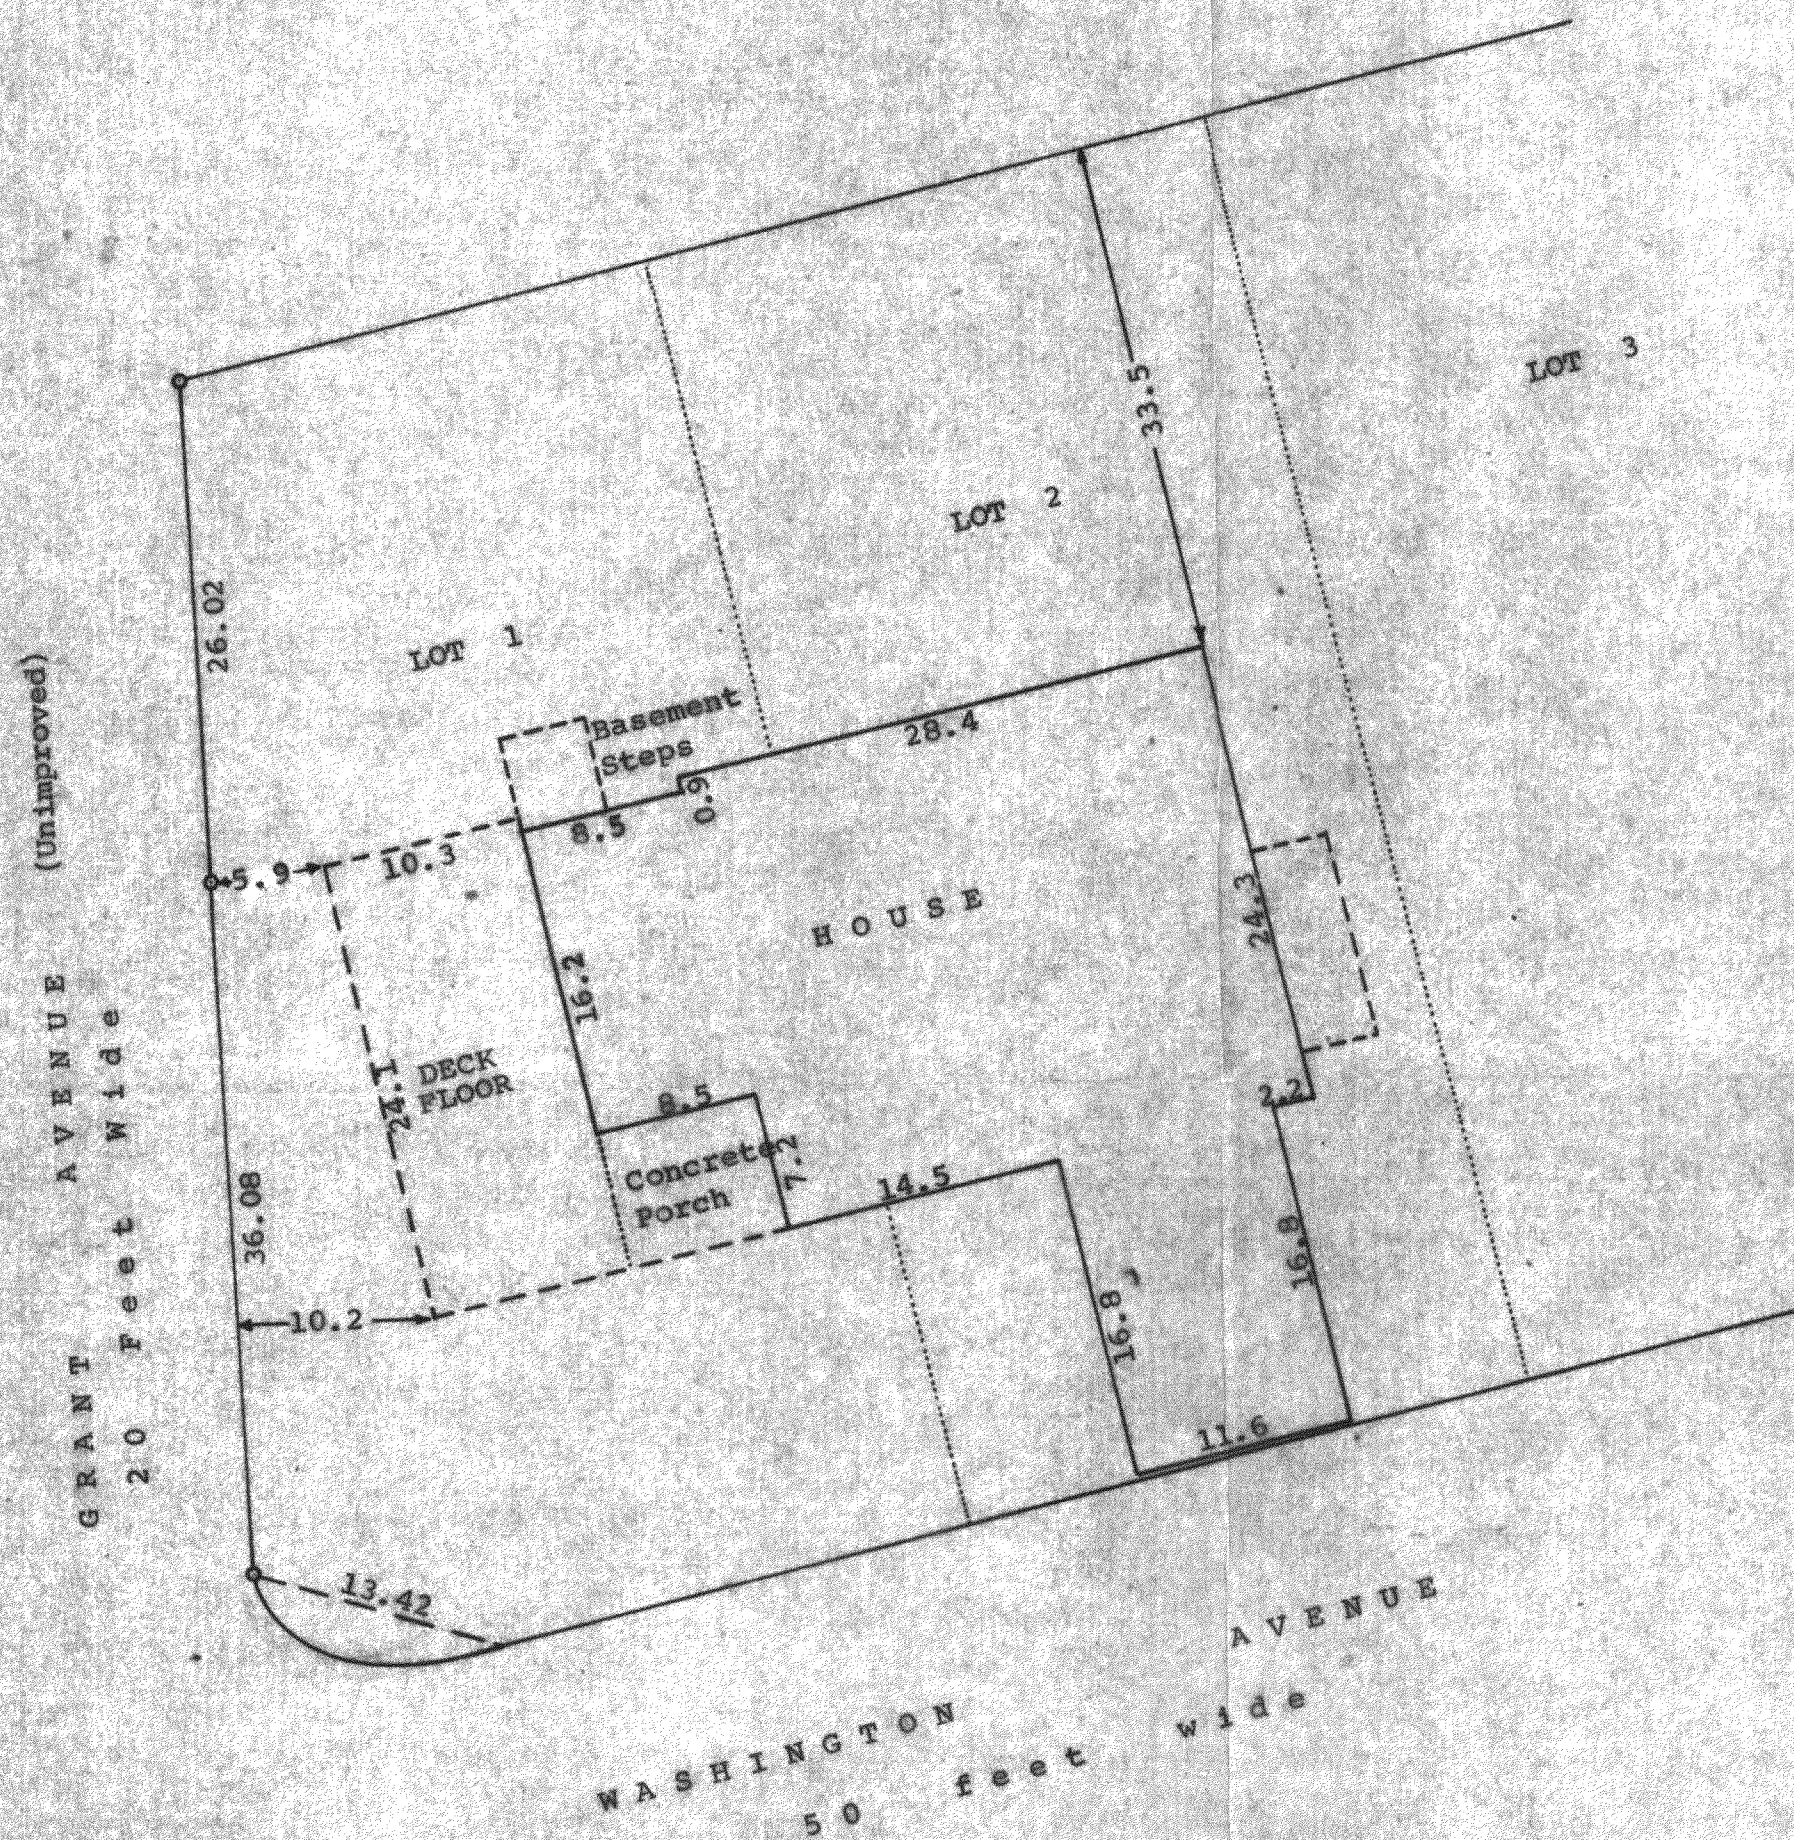

Scale - 1" = 10'
o = Iron Pipe

Plat of survey of the westerly line of Lot 1, Block 2
located in the Delavan Lake Assembly Grounds, and the
location of the house thereon, all in T 2 N, R 16 E,
Walworth County, Wisconsin.
April 27, 1981

James M. Dunham
James M. Dunham, Surveyor

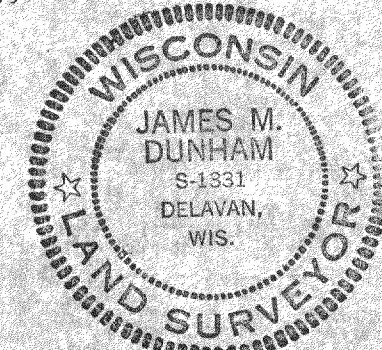

(FDLA-218 - W Line of Lot 1)