


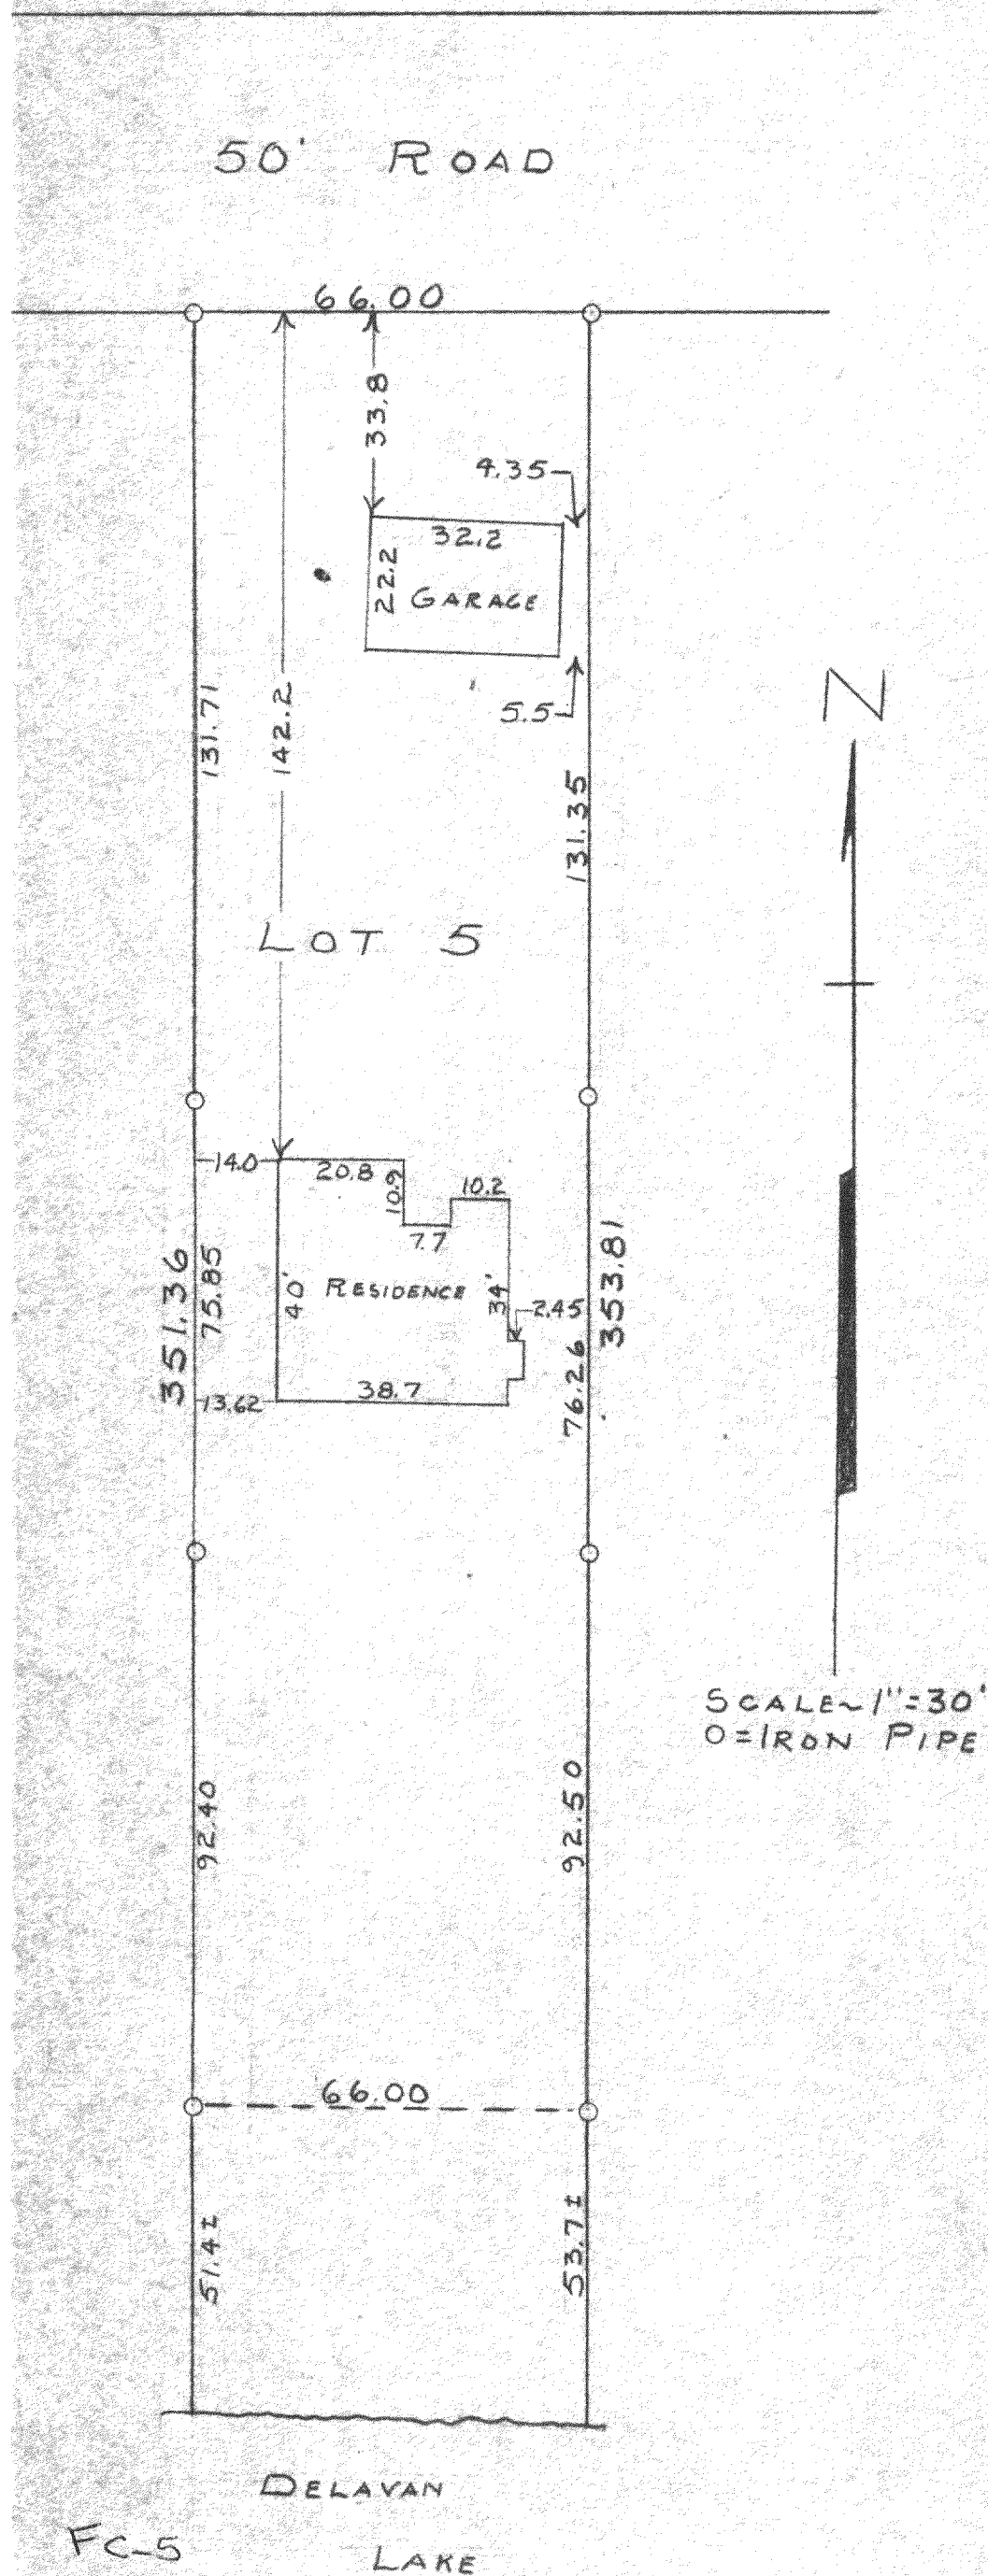

STATE OF WISCONSIN)SS
WALWORTH COUNTY)

I, GEORGE T. DUNHAM, DO HEREBY CERTIFY THAT I HAVE
SURVEYED THE PROPERTY DESCRIBED AS FOLLOWS
LOT 5 OF CEDAR POINT SUBDIVISION LOCATED IN
THE NE 1/4 OF SECTION 28, T2N R16E OF WALWORTH COUNTY
WISCONSIN.
AND THAT THE ADJACENT PLAT IS THE CORRECT REPRESENTATION
OF THE PROPERTY LINES AND OF THE IMPROVEMENTS LOCATED
THEREON
JUNE 11, 1959

George T. Dunham
GEORGE T. DUNHAM, SURVEYOR
DELAVAN, WISCONSIN

SCALE 1"=30'
O=IRON PIPE

216-74