




SCALE ~ 1" = 20'
O ~ IRON PIPE

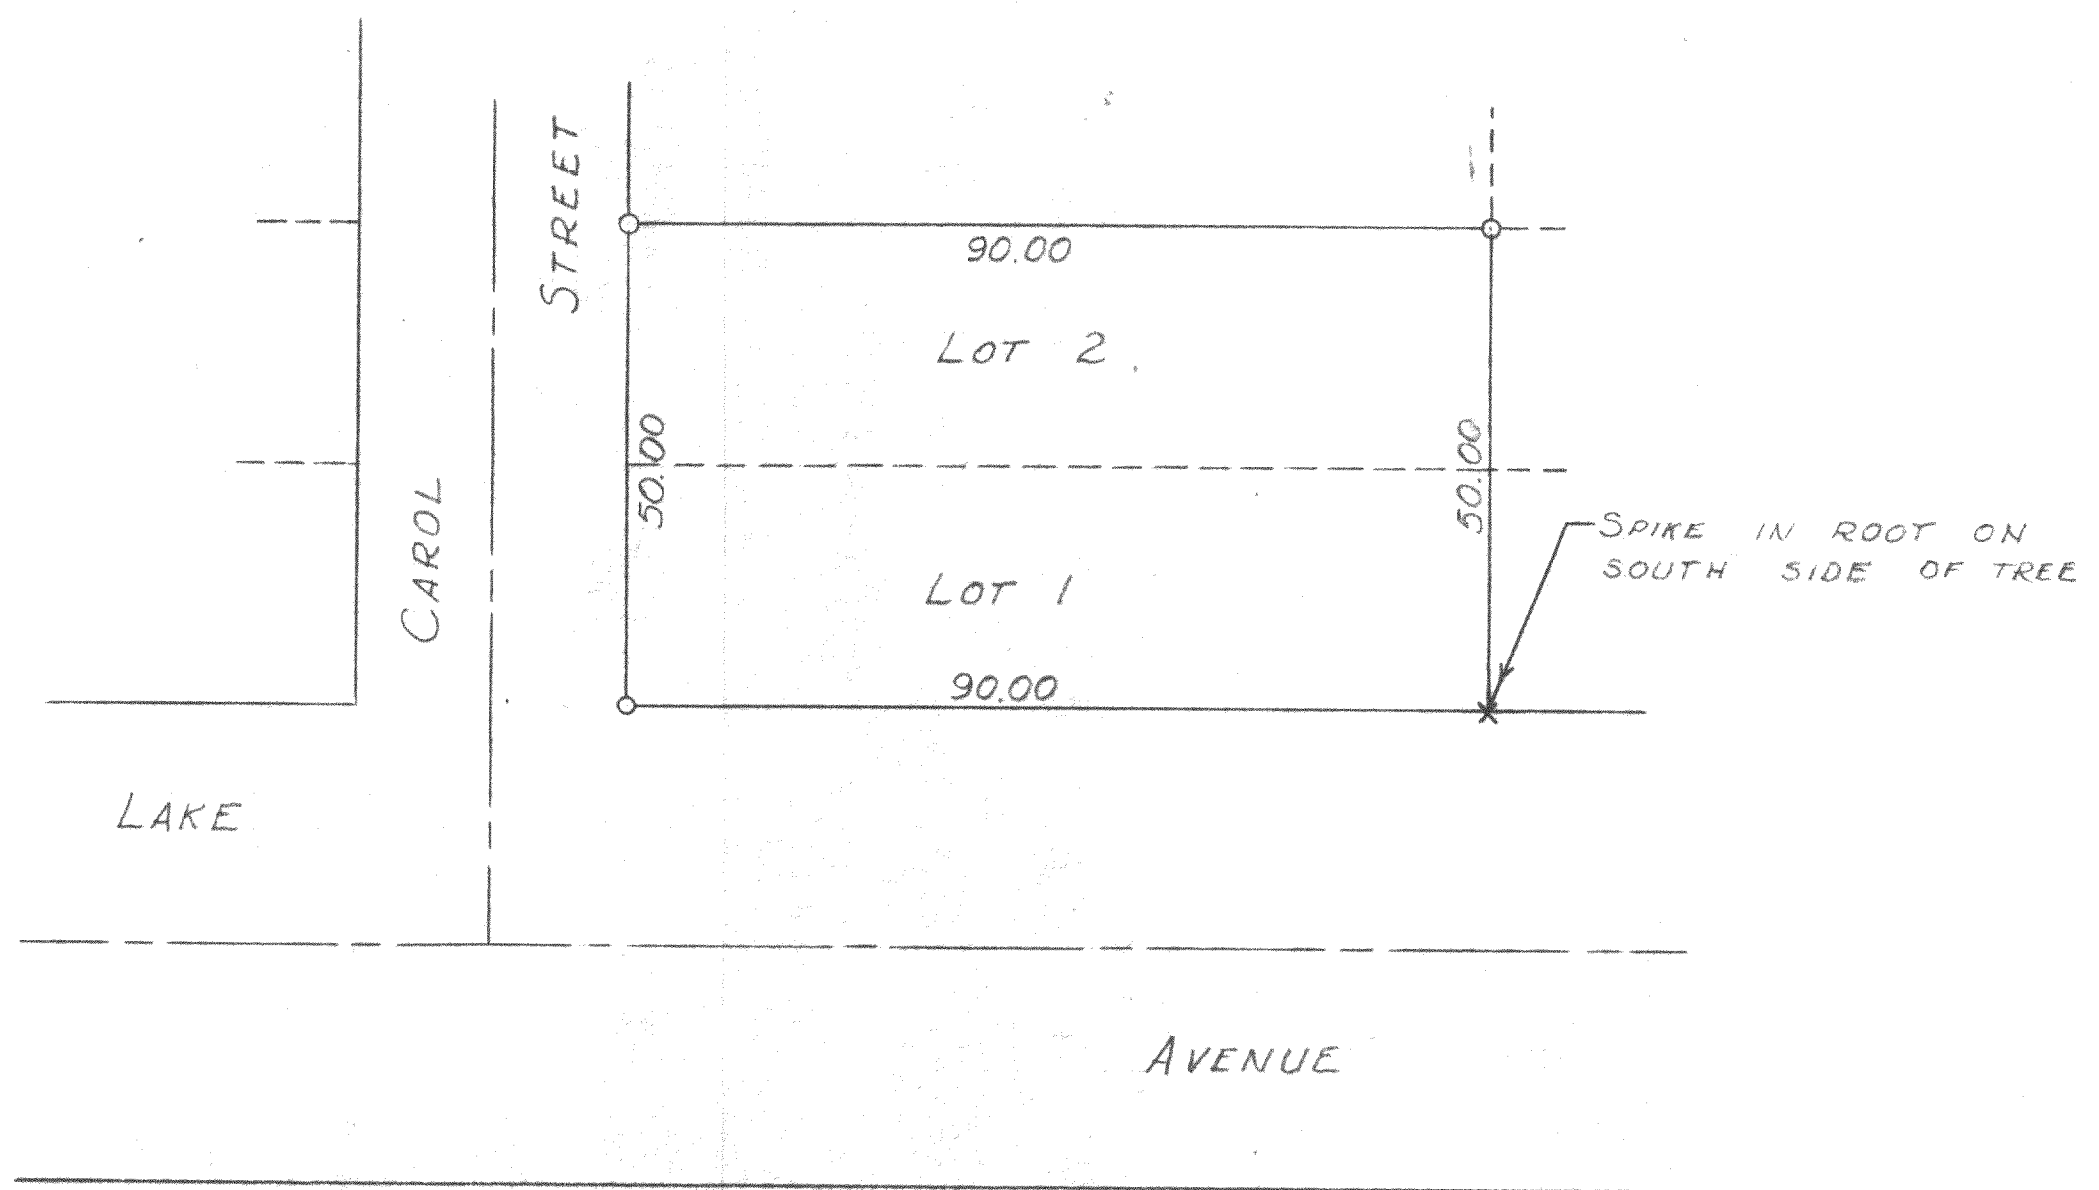

PLAT OF SURVEY OF LOTS 1 AND 2, BLOCK 2 OF ROBBINS SUBDIVISION LOCATED IN
SECTION 32, T2N R16E OF WALWORTH COUNTY, WISCONSIN,
JUNE 30, 1958

FRo-7

George T. Dunham
GEORGE T. DUNHAM, SURVEYOR
DELAVER, WISCONSIN.

216-75