


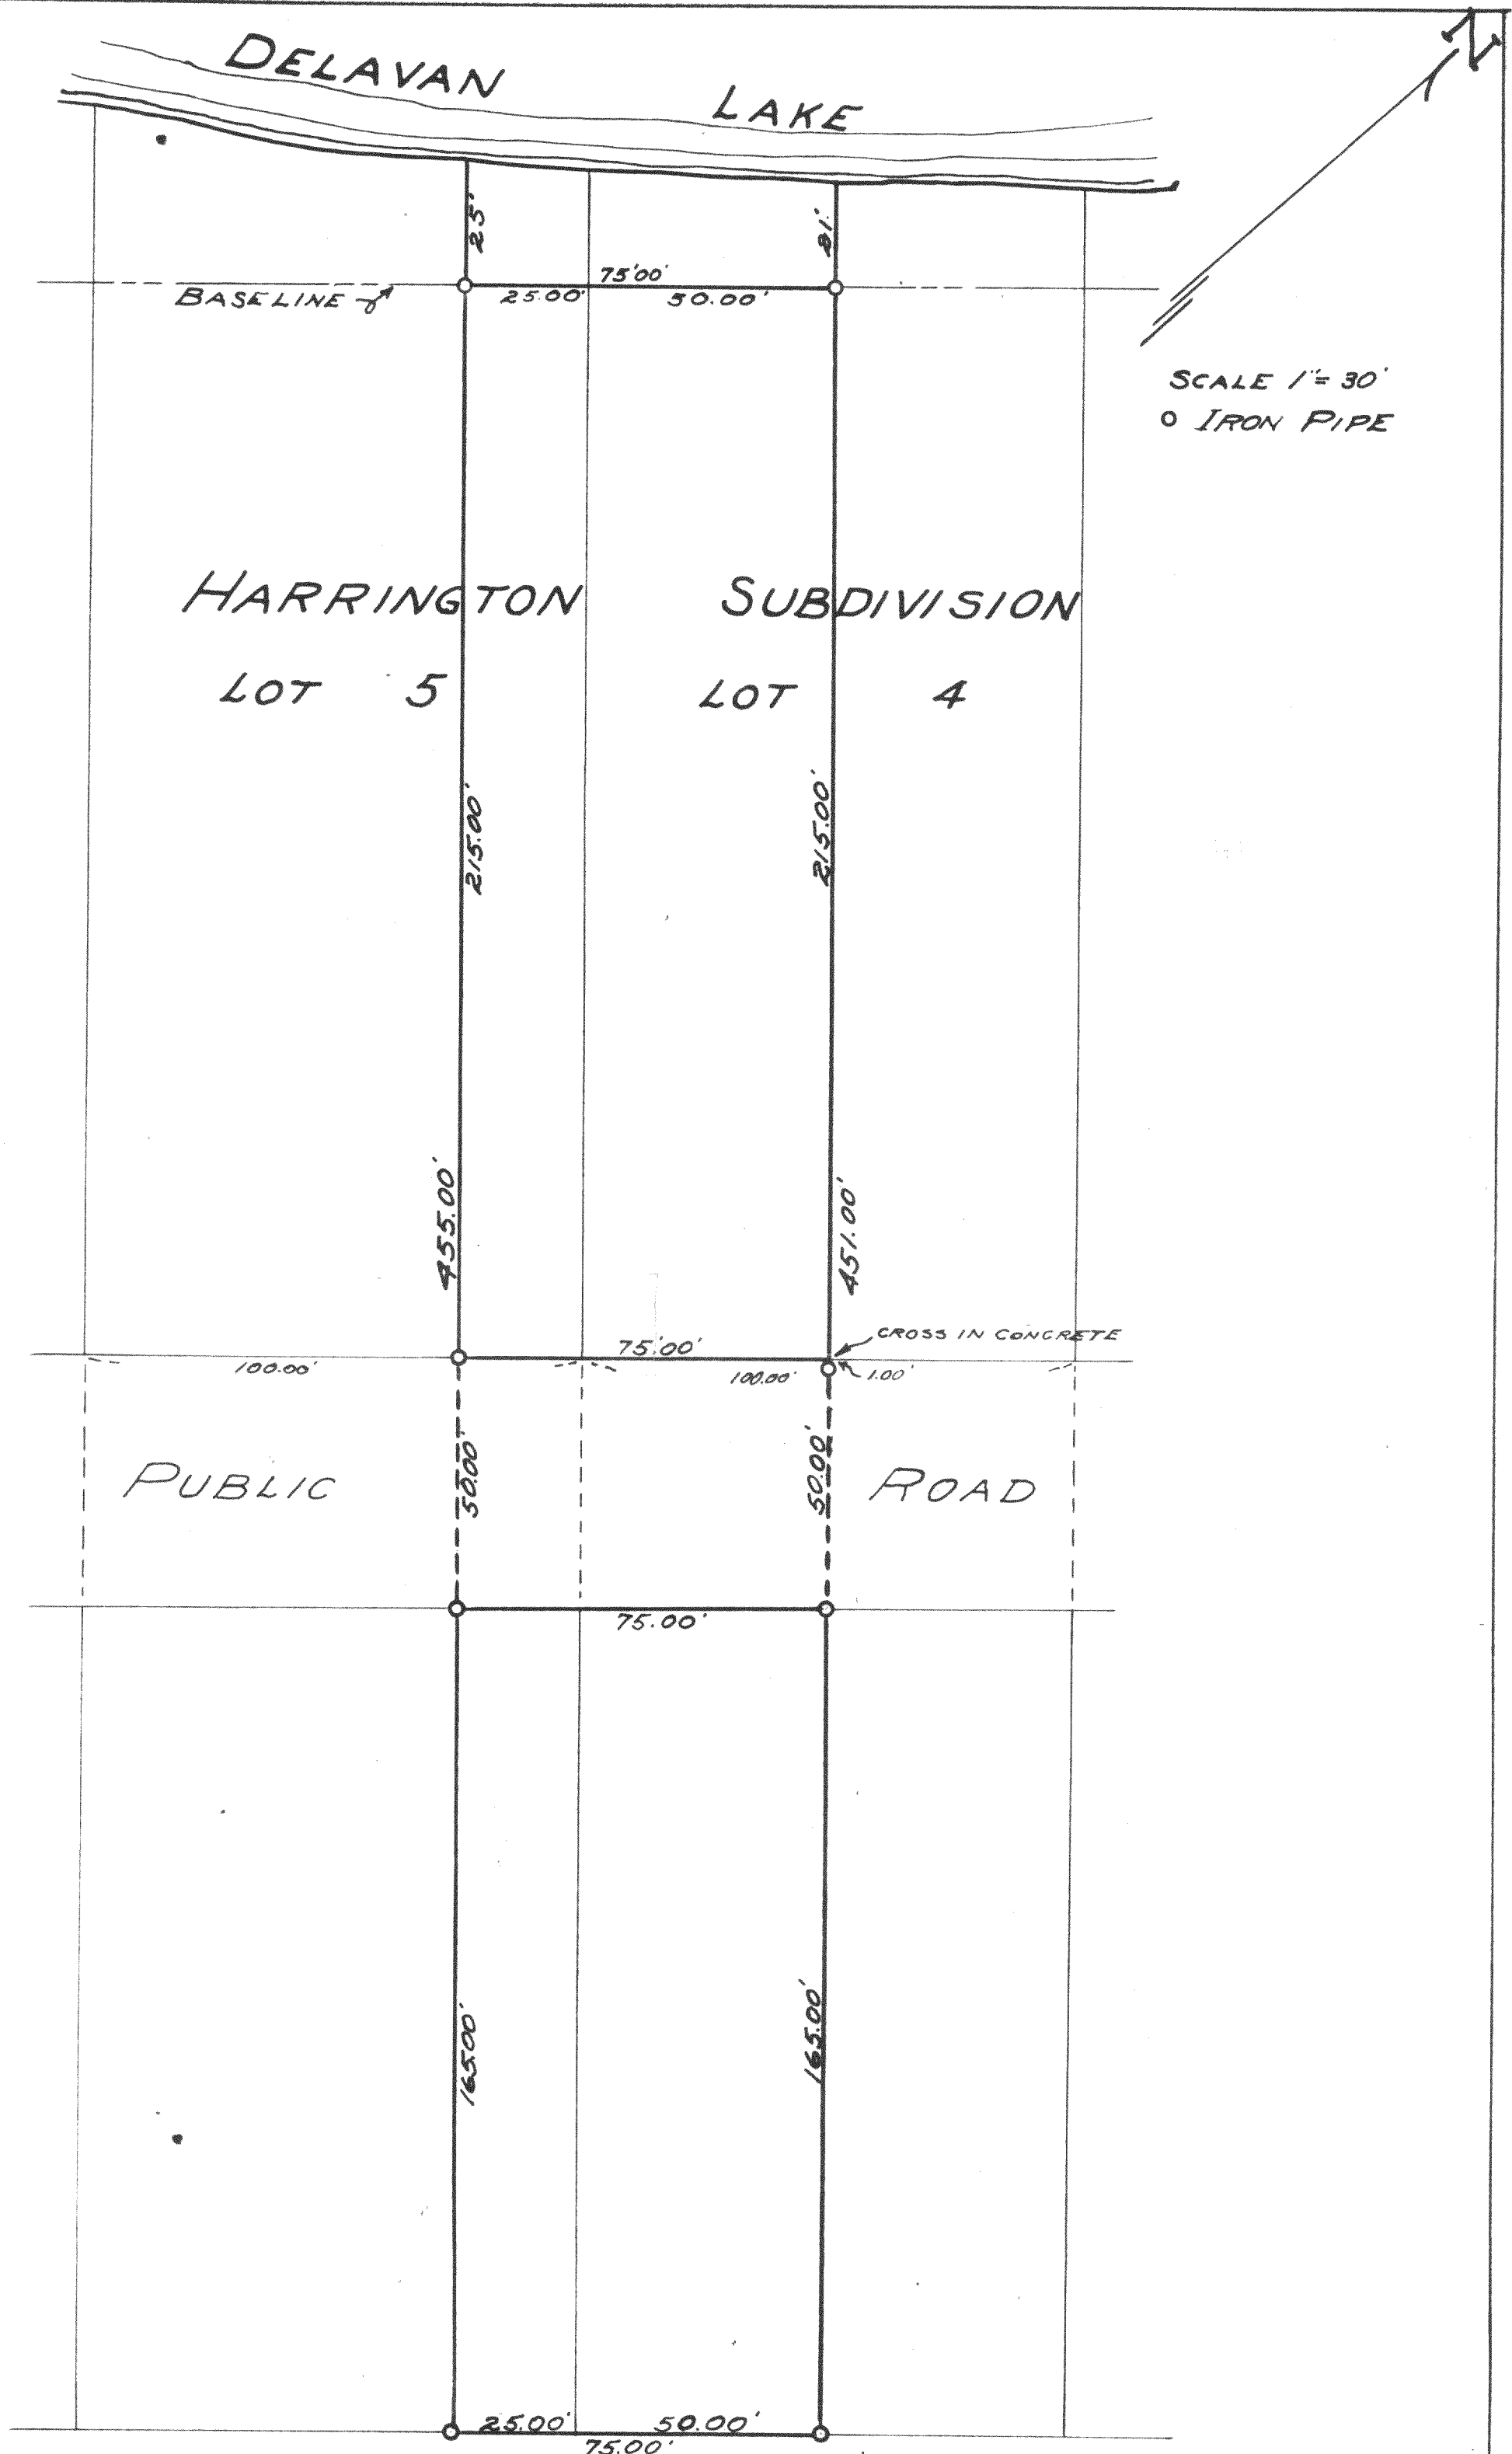

PLAT OF SURVEY OF NORTHEAST 25' OF LOT 5 AND SOUTHWESTERLY
 1/2 OF LOT 4 HARRINGTON SUBDIVISION ON DELAVAN LAKE
 WALWORTH COUNTY, WISCONSIN

JULY 1948

Lloyd S. Jensen
 COUNTY SURVEYOR

FHA-7 FD-27-11

216-76.1