

DUNHAM SURVEYING, S.C.
SURVEYING & SUBDIVIDING
DELAVER, WISCONSIN 53115


N



Scale - 1" = 20'

• = Iron Pipe Found
o = Iron Pipe Set

Bearings referenced to the west line of
Lot 3. Assumed Bearing of North
Owner: Patrick Sullivan
4524 West 99th Place
Oak Lawn, Illinois

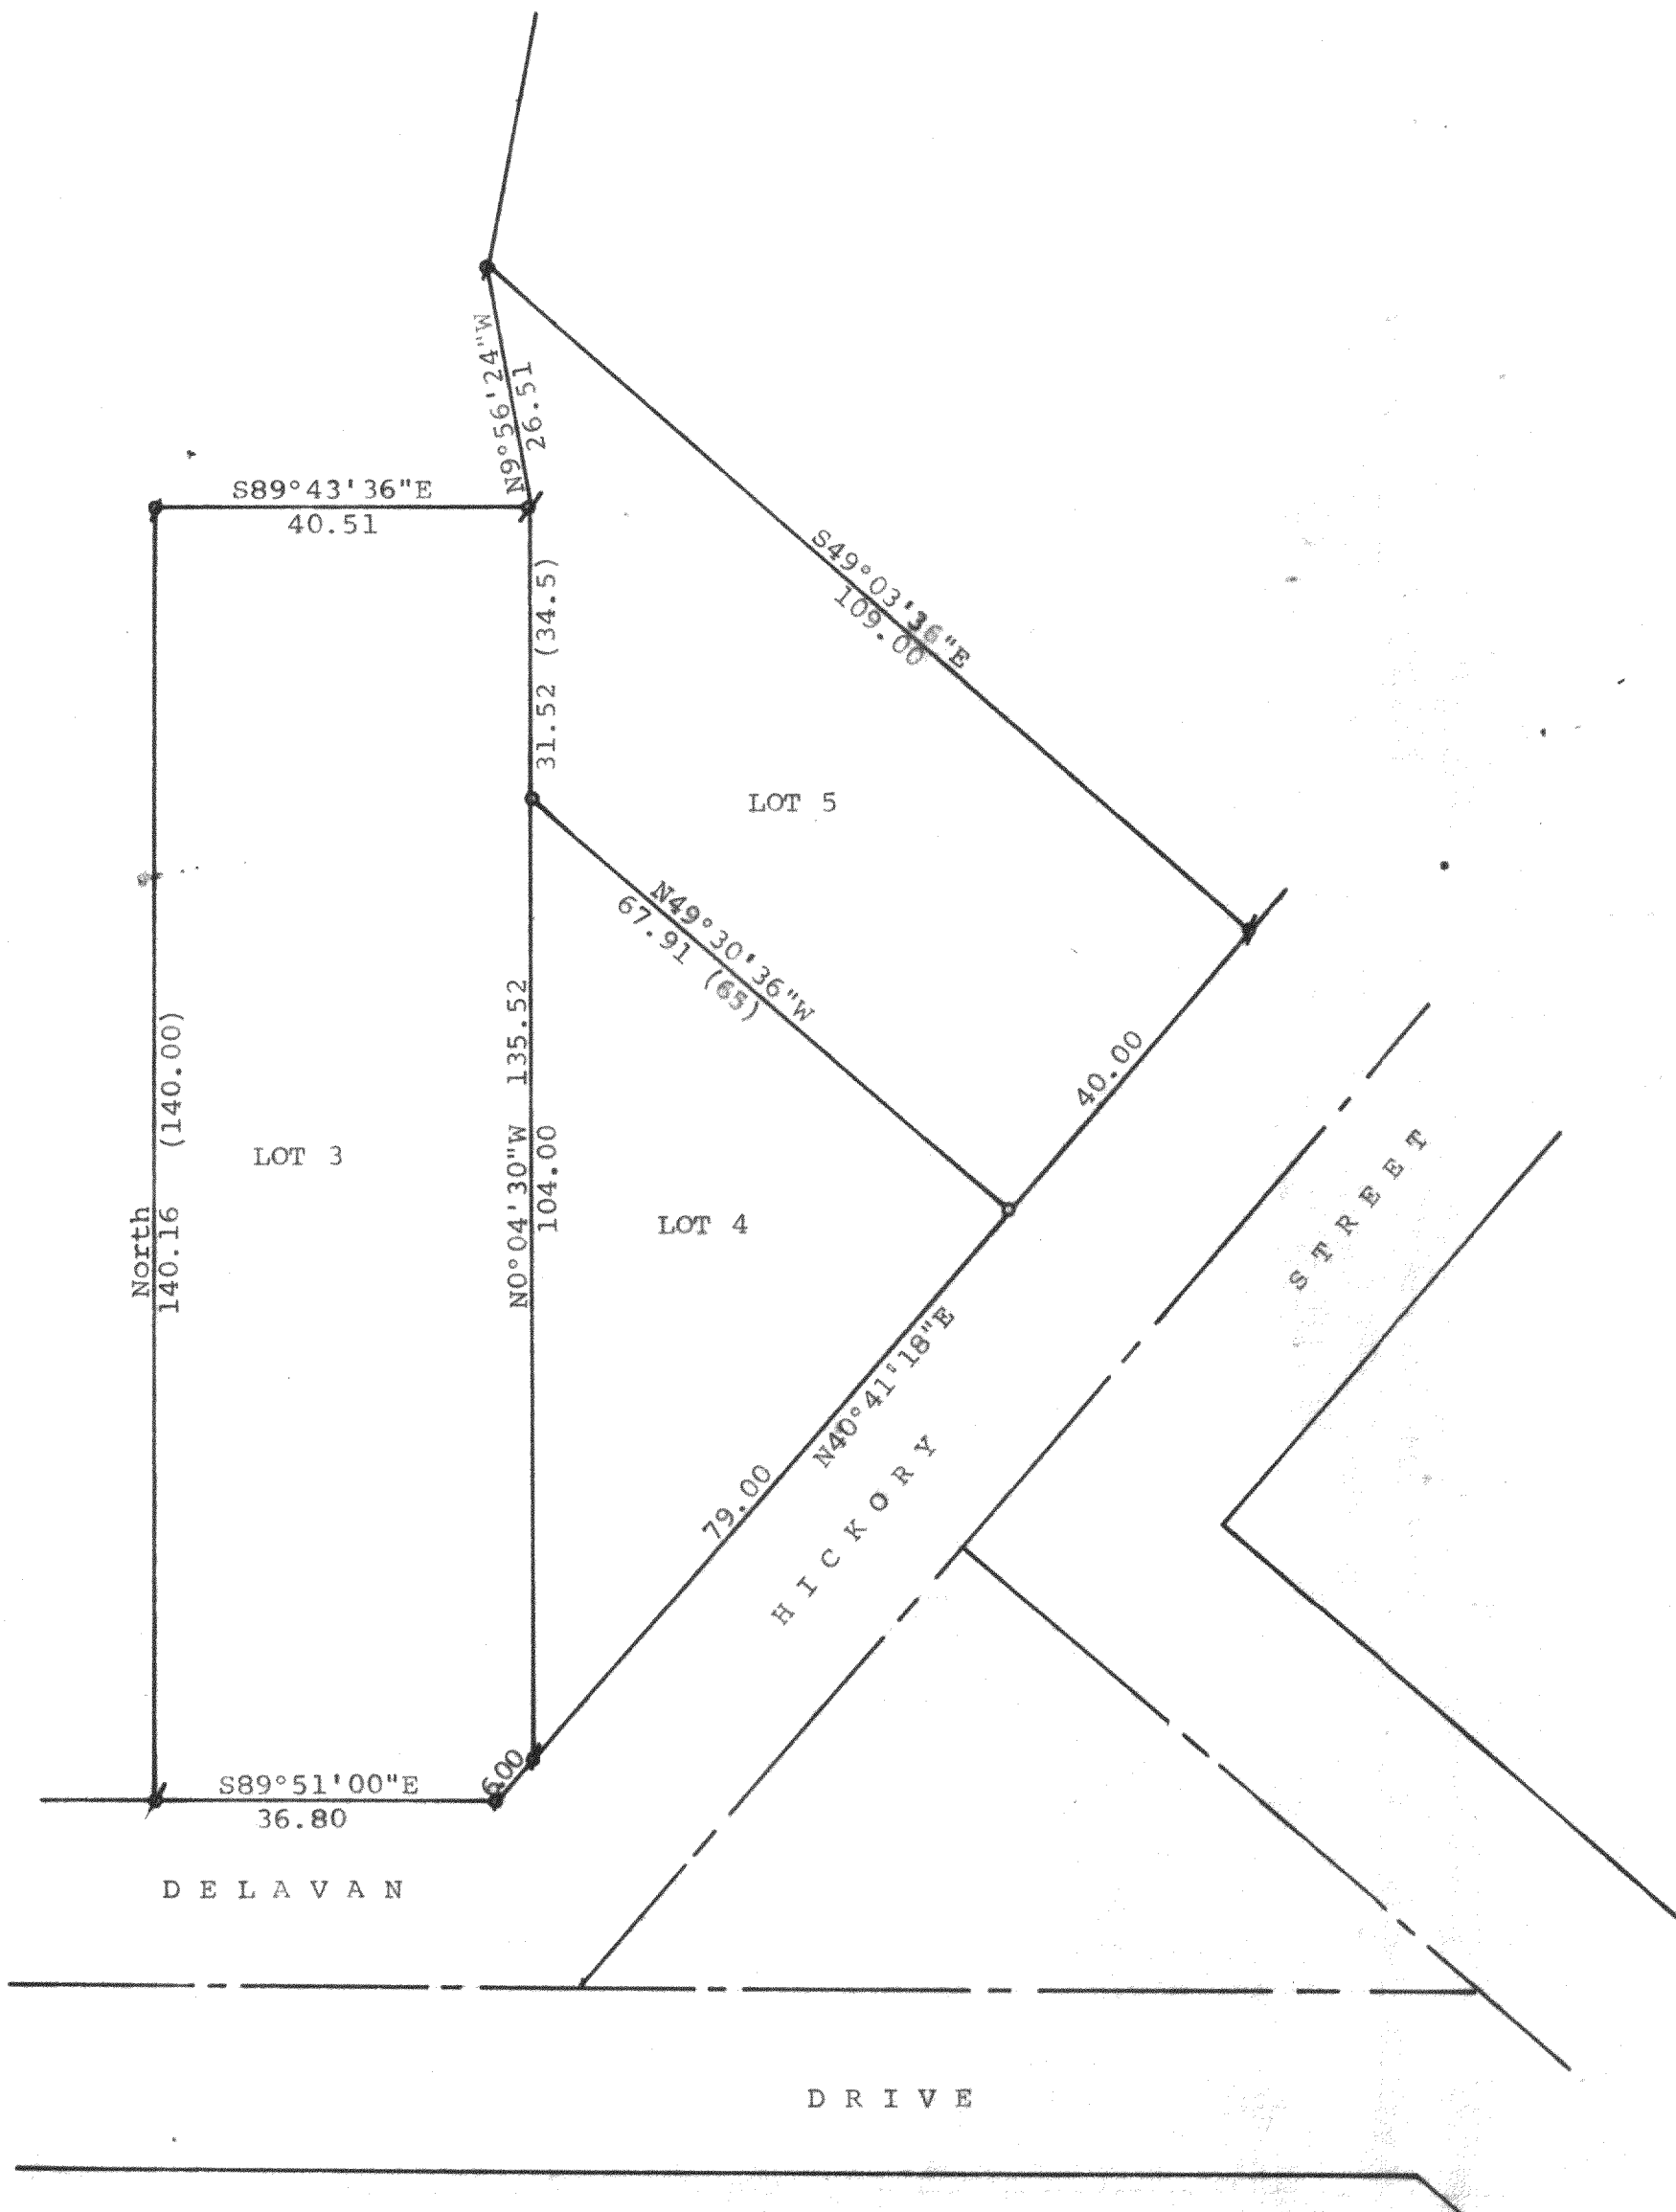

STATE OF WISCONSIN) SS
COUNTY OF WALWORTH)

I, George T. Dunham, Surveyor, certify that I have surveyed the
property described as follows:


Lot 3, 4, and 5 in Block 6, Inlet Oaks Subdivision No. 4 located
in the Southeast Fractional 1/4 of Section 15, T 2 N, R 16 E,
Walworth County, Wisconsin,

and that the above map is a true representation thereof and shows the
size and location of the property, its exterior boundaries, the location
of all visible structures and dimensions of all principal buildings
thereon, boundary fences, apparent easements, roadways and visible
encroachments, if any.

This survey is made for the use of the present owners of the property,
and also those who purchase, mortgage, or guarantee the title thereto
within one (1) year from date hereof.

September 27, 1982

George T. Dunham
George T. Dunham, Surveyor

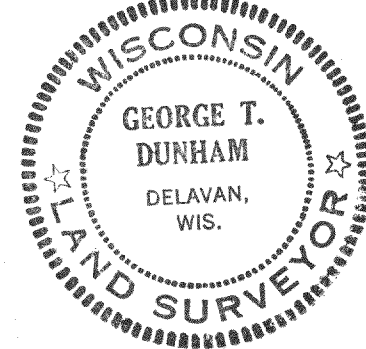

FIN443

Lots 3, 4 + 5 Blk 6 Inlet Oaks No 4, 15-2-16

216-7692