


DUNHAM SURVEYING, S.C.
SURVEYING & SUBDIVIDING
DELAVAN, WISCONSIN 53115

N

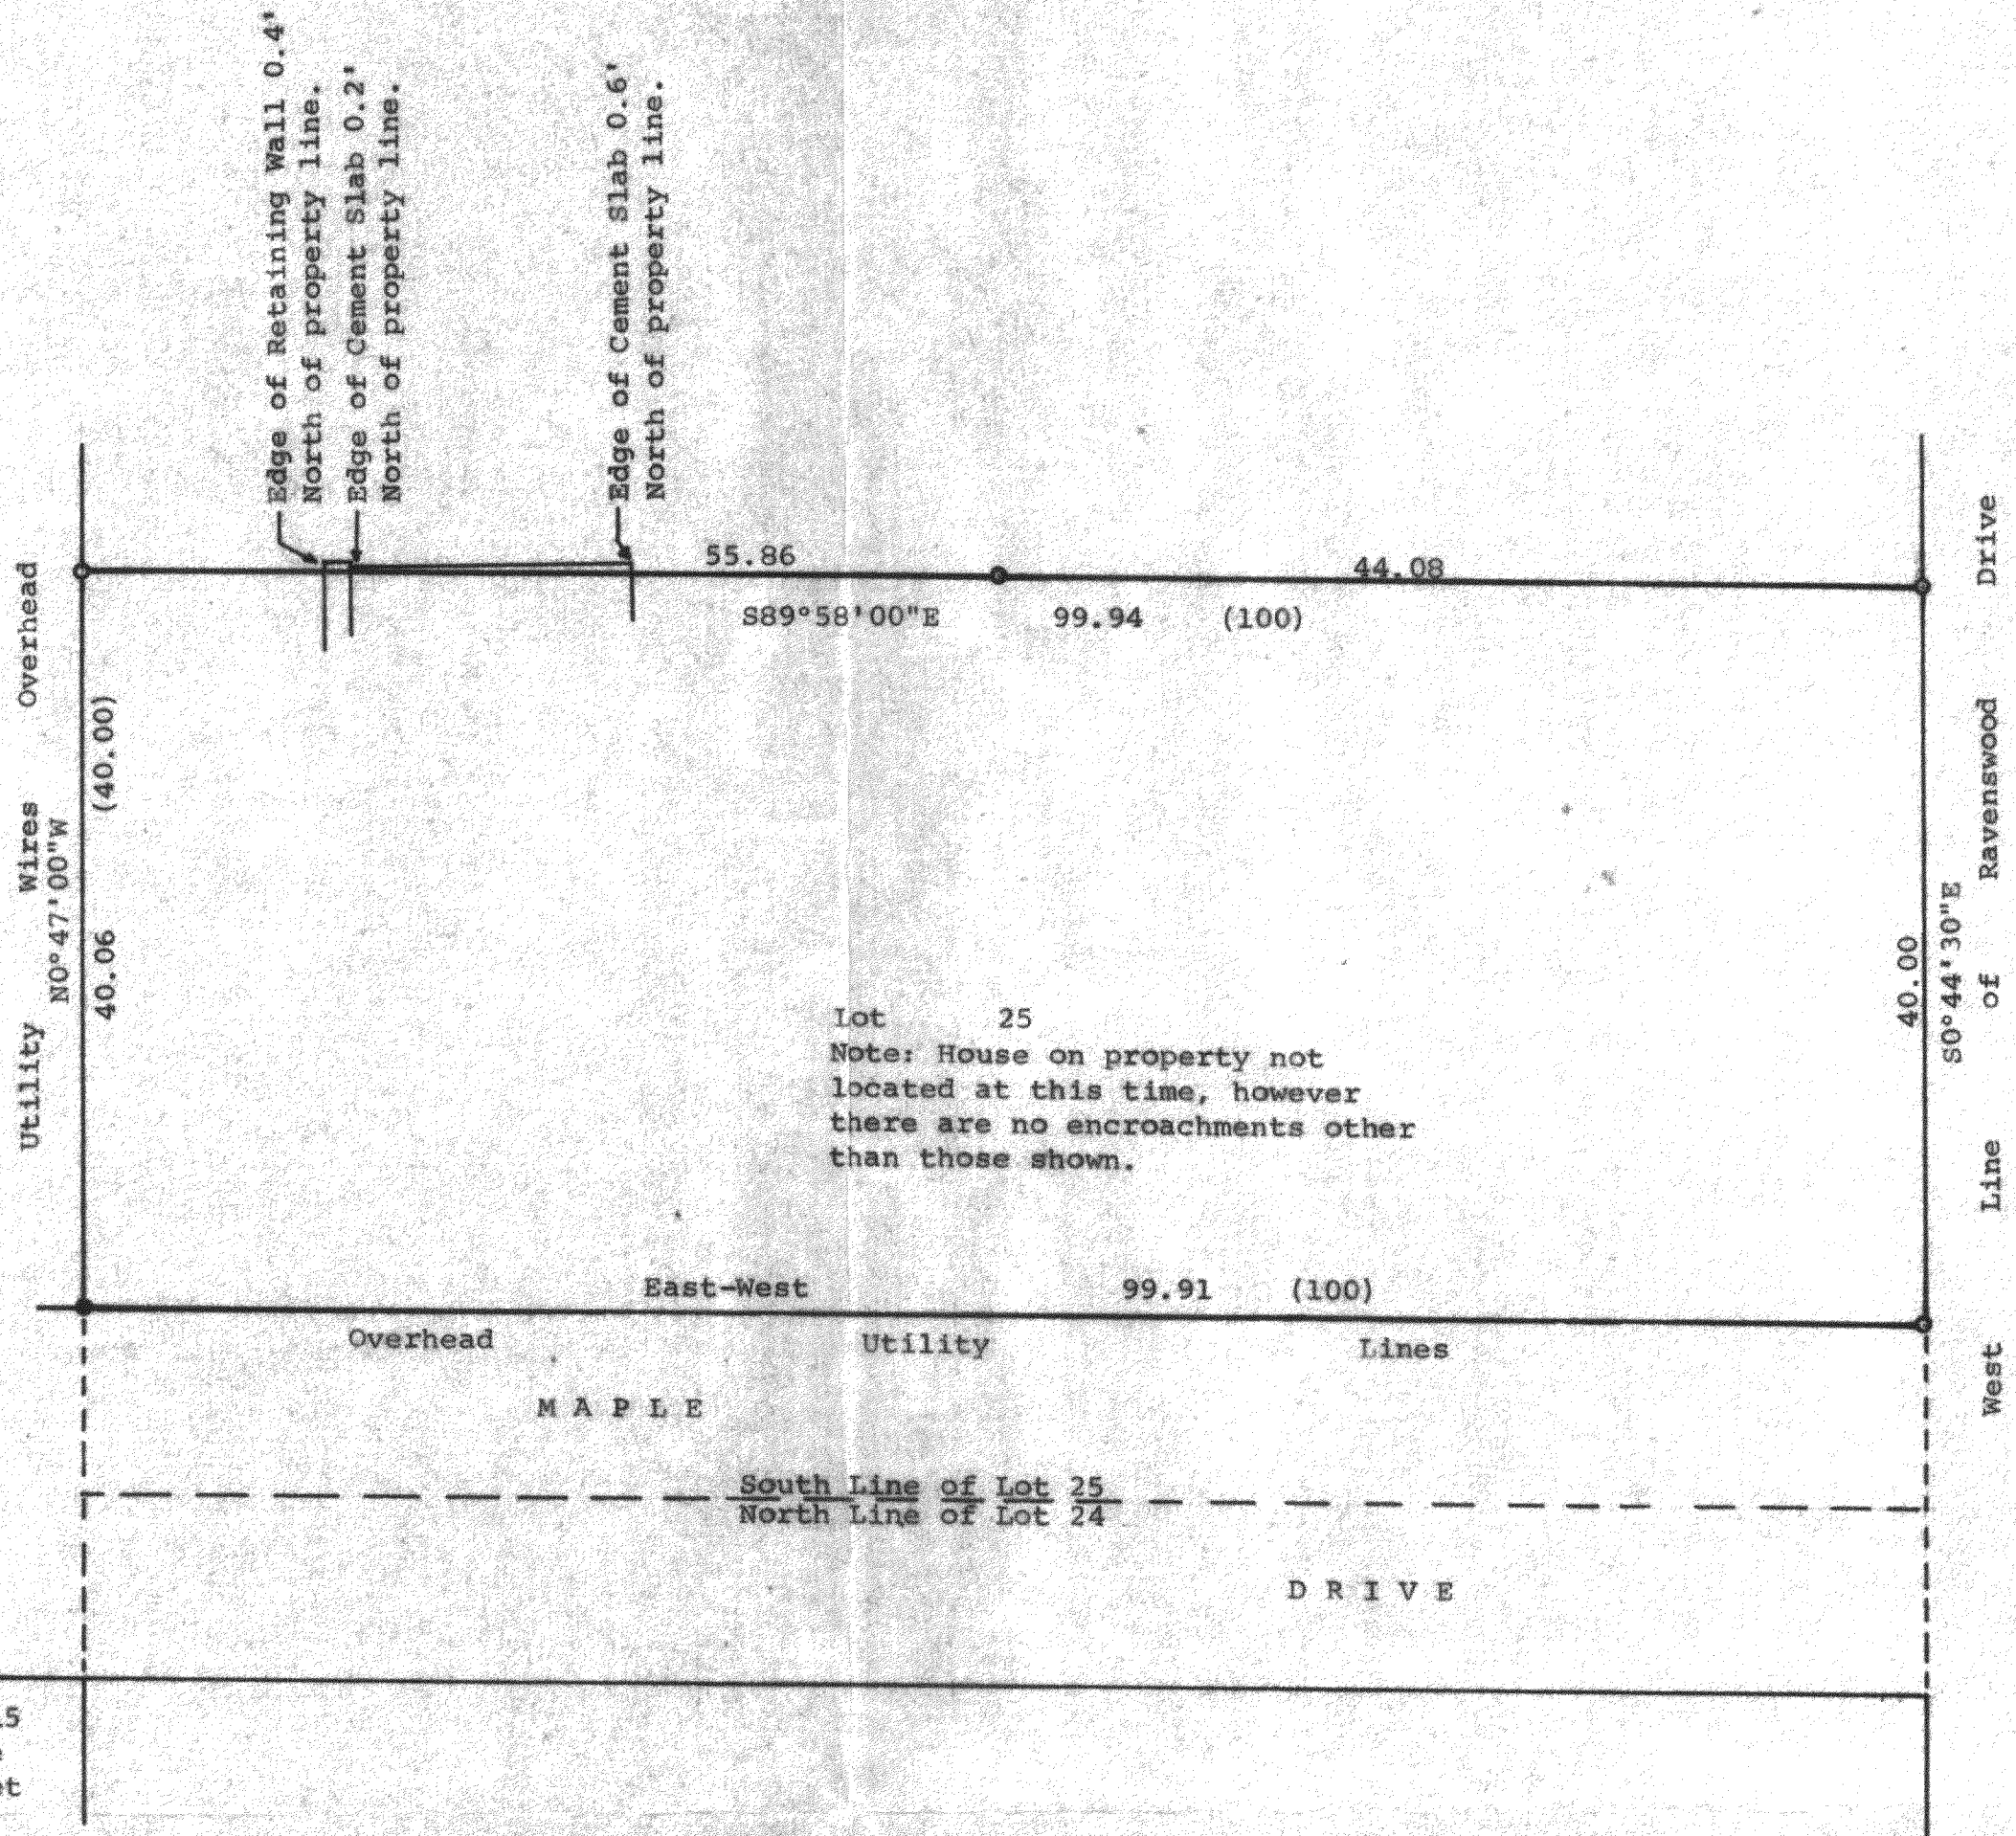

Scale - 1" = 10'
● = Iron Rod Found
1" Diameter
○ = Iron Pipe Set
3/4" Diameter
(0.00) = Recorded Distance

Owner: Helen Schwartz
3913 Ravenswood Dr.
Delavan, Wisconsin 53115
Note: Bearings are based on the
North line of Maple Street
assumed East-West.

STATE OF WISCONSIN)
COUNTY OF WALWORTH)

I, James M. Dunham, Surveyor, certify that I have surveyed
the property described as follows,
Lot 25 of Ravenswood, a subdivision located in Section 31,
T2N, R16E, Walworth County, Wisconsin,
and that the above map is a true representation thereof and shows the
size and location of the property, its exterior boundaries, boundary
fences, apparent easements, roadways and visible encroachments, if any.
This survey is made for the use of the present owners of the property,
and also those who purchase, mortgage, or guarantee the title thereto
within one (1) year from date hereof.
April 29, 1982.

James M. Dunham
James M. Dunham, Surveyor

