


DUNHAM SURVEYING, S. C.
SURVEYING & SUBDIVIDING
DELAVAN, WISCONSIN 53115

N

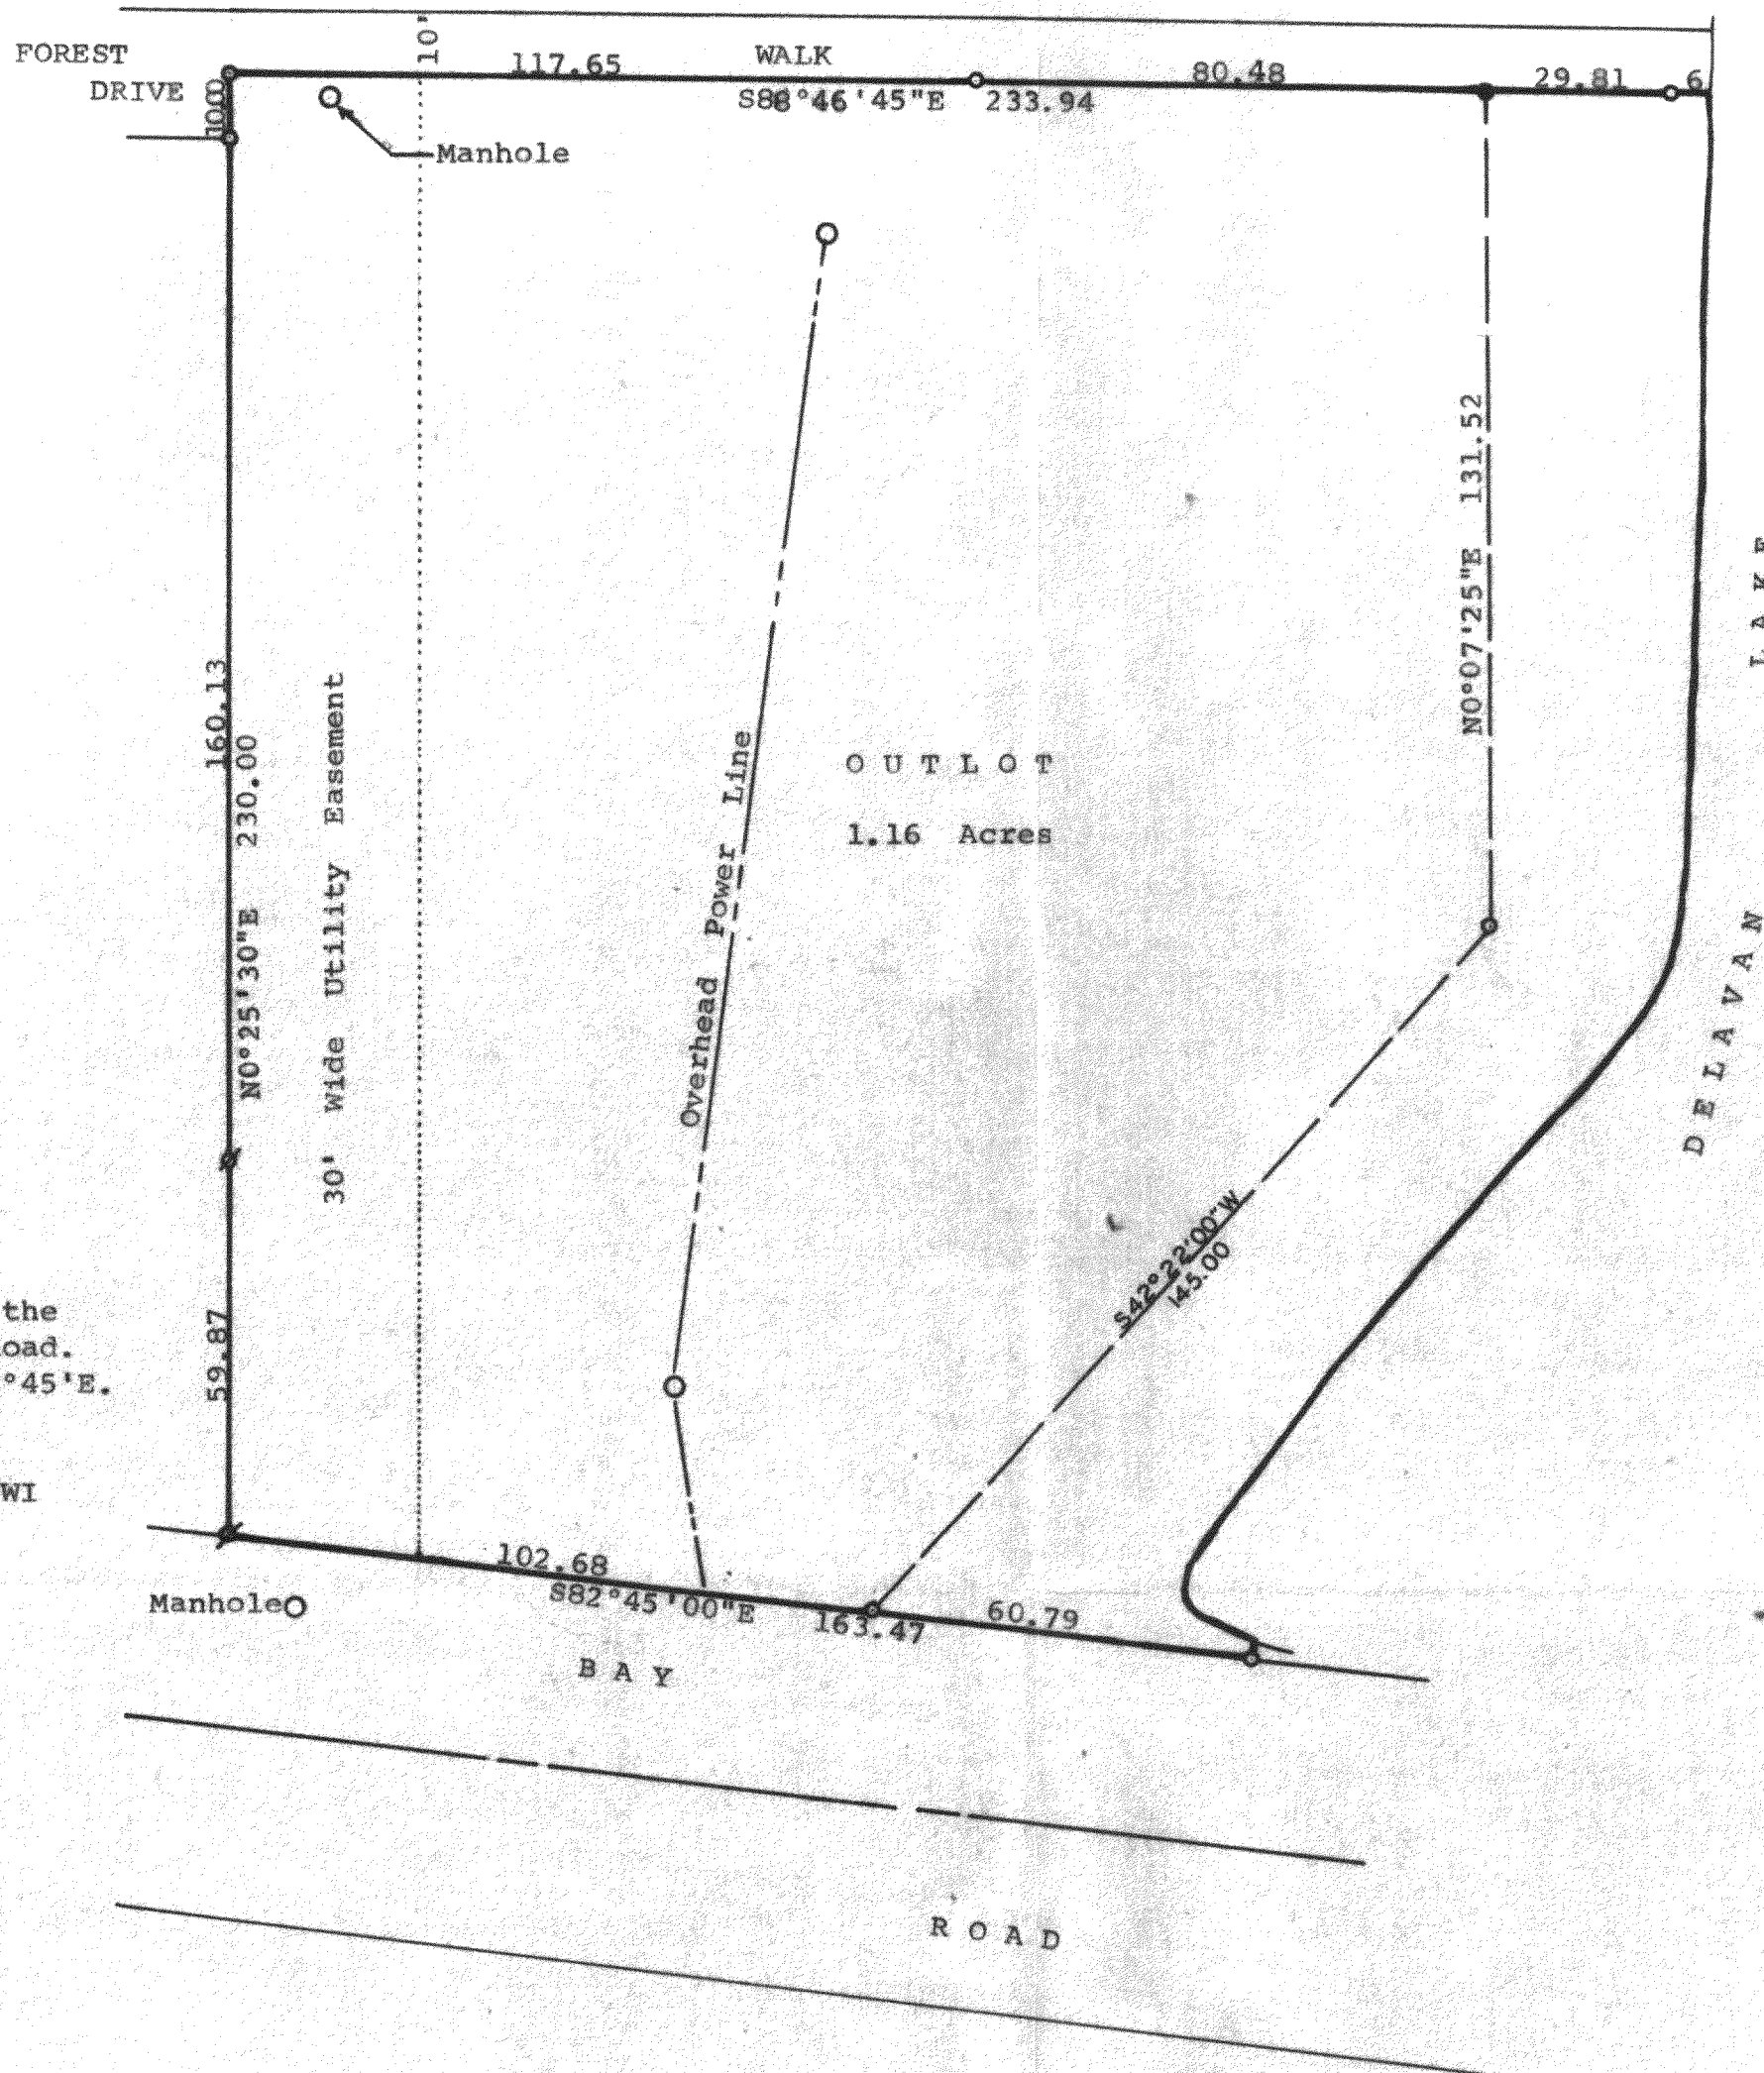

Scale - 1" = 30'

* = Iron Pipe Found
o = Iron Pipe Set
• = Iron Rod Set

Bearings referenced to the
northerly line of Bay Road.
Bearing recorded as S82°45'E.

Ordered by: Jeff Dean
Walworth, WI

STATE OF WISCONSIN)
COUNTY OF WALWORTH) SS

I, James M. Dunham, Surveyor, certify that I have surveyed
the property described as follows:

Parcel designated as Outlot in Krumhaar's Second Addition
to Ravenswood located in the Southeast Fractional 1/4 of
Section 31, T 2 N, R 16 E, Walworth County, Wisconsin,
subject to easements of record

and that the above map is a true representation thereof and shows
the size and location of the property, its exterior boundaries, the
location of all visible structures and dimensions of all principal
buildings thereon, boundary fences, apparent easements, roadways and
visible encroachments, if any.

This survey is made for the use of the present owners of the property,
and also those who purchase, mortgage, or guarantee the title thereto
within one (1) year from date hereof.

September 17, 1982

James M. Dunham
James M. Dunham, Surveyor

