


PLAT OF SURVEY OF LOTS 6,7,17, & 18 OF BLOCK 2 OF
DELAVER LAKE VIEW CREST, A SUBDIVISION LOCATED IN THE
NORTH 1/2 OF SECTION 31, TOWN 2 NORTH, RANGE 16 EAST,
WILMOUTH COUNTY, WISCONSIN

FOR
John & Geraldyn Stack


(xxx) = Record dimension
LEGEND FOR METAL MONUMENTS
⊕ = IRON PIPE SURVEY STAKE FOUND
● = IRON ROD SURVEY STAKE FOUND
○ = IRON PIPE SURVEY STAKE SET

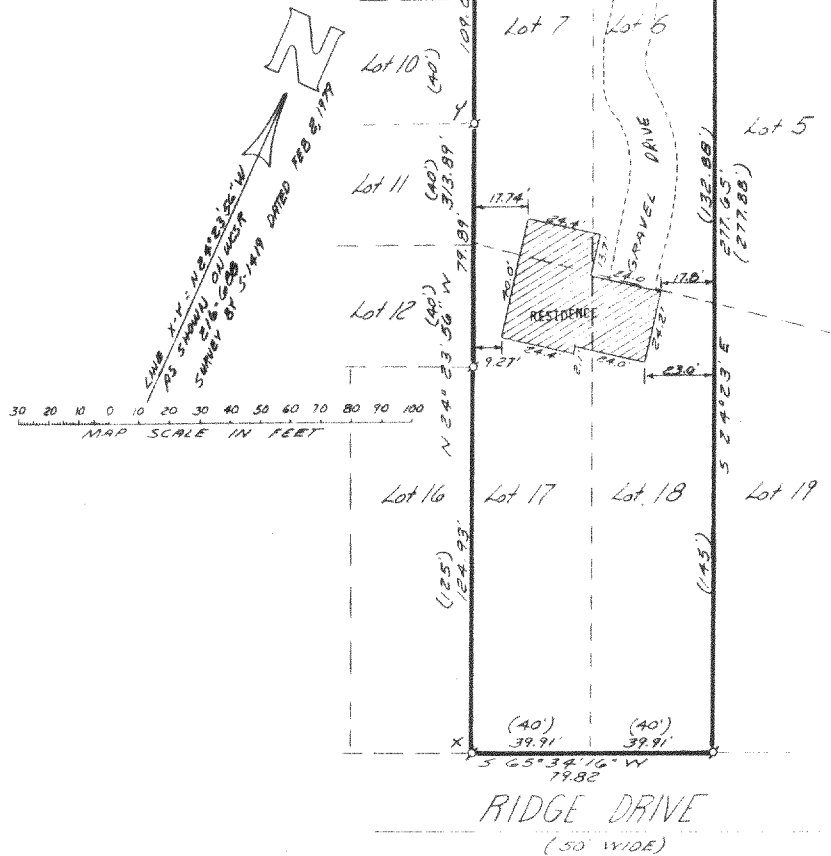

I hereby certify that I have surveyed the above
described property and that the above map is a true
representation thereof and shows the size and location of
the property, its exterior boundaries, the location of all
visible structures and dimensions of all principal
buildings thereon, boundary fences, apparent easements,
roadways and visible encroachments, if any.
This survey is made for the use of the present owners
of the property, and also those who purchase, mortgage,
or guarantee the title thereto within one (1) year from
date hereof.

Robert A. Farris
Robert A. Farris RLS

DATED THIS 28th DAY OF OCTOBER, 1983
REVISED DEC. 28TH, 1983 TO SHOW RELOCATED DRIVE

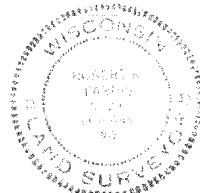

Farris, Hanson & Associates, Inc.
Engineering, Surveying & Land Planning
P.O. BOX 487
715 W. WALWORTH STREET
ELKHORN, WISCONSIN 53121
PROJ. # 2178

FOLU-7A1, 2A8

216-774-F