


KOLB LAND CONSULTING, INC.
LAND SURVEYING • SUBDIVIDING • LAND PLANNING

LAKE GENEVA, WISCONSIN 53147

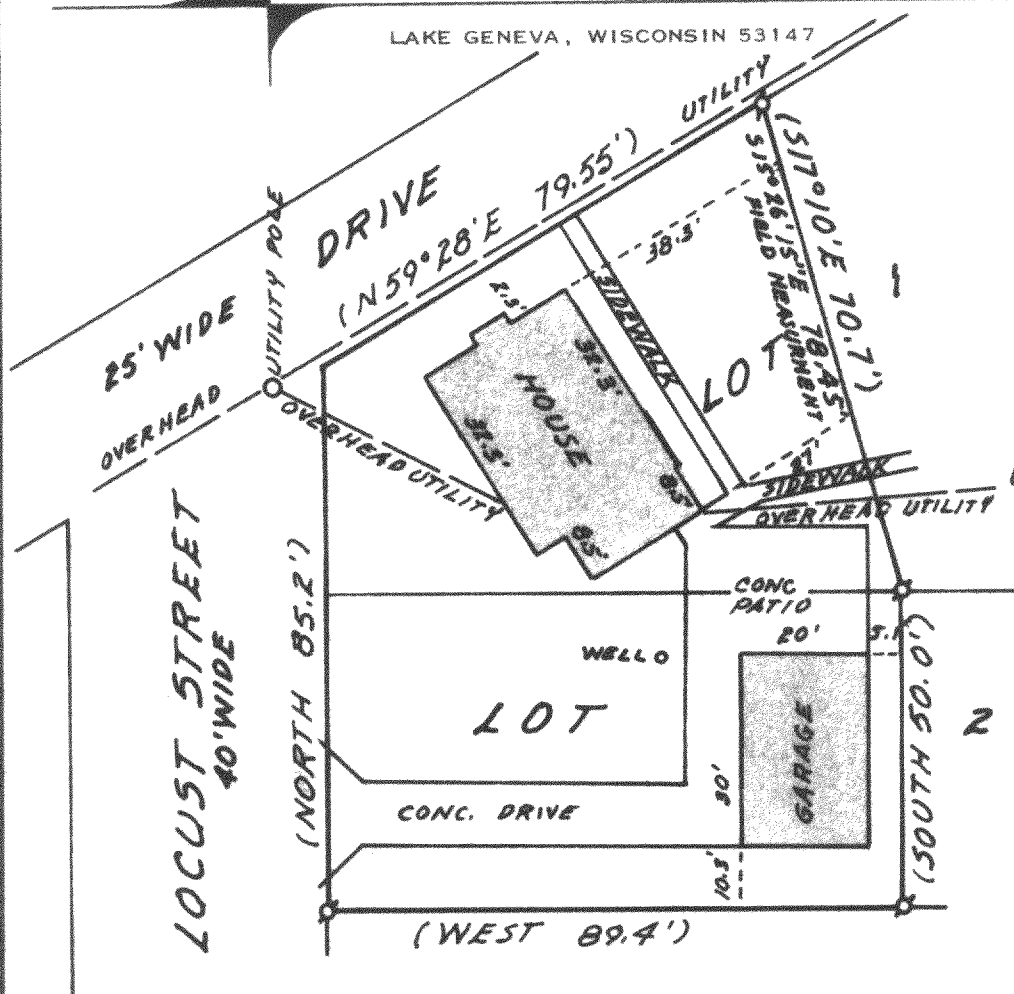

SCALE: 1"=30'

LEGEND
Ø IRON PIPE FOUND
() AS RECORDED

PLAT OF SURVEY OF


PART OF LOTS 1 & 2, LAKE VIEW SUBDIVISION, LOCATED IN
SECTION 32, T 2 N, R 16 E, TOWN OF DELAVAN, WALWORTH
COUNTY, WISCONSIN. TAX KEY NO. FLAS-2

ORDERED BY: I.D.L. MORTGAGE CORP
P.O. BOX 1256
KENOSHA, WI. 53141
FOR: JAMES V. & EVELYN M. LARSEN
4230 LOCUST STREET
DELAVAN, WI. 53115

NOTE: THE PLACEMENT OF MONUMENTS HAS BEEN WAIVED BY THE
CLIENT AS PERMITTED IN A-E 5.01(B)

I HEREBY CERTIFY THAT I HAVE SURVEYED THE
ABOVE DESCRIBED PROPERTY AND THAT THE ABOVE
MAP IS A TRUE REPRESENTATION THEREOF AND
SHOWS THE SIZE AND LOCATION OF THE PROPERTY,
ITS EXTERIOR BOUNDARIES, THE LOCATION OF ALL
VISIBLE STRUCTURES AND DIMENSIONS OF ALL
PRINCIPAL BUILDINGS THEREON, BOUNDARY FENCES,
APPARENT EASEMENTS, ROADWAYS AND VISIBLE
ENCROACHMENTS, IF ANY.

THIS SURVEY IS MADE FOR THE USE OF THE
PRESENT OWNERS OF THE PROPERTY, AND ALSO
THOSE WHO PURCHASE, MORTGAGE, OR GUARANTEE
THE TITLE THERETO WITHIN ONE (1) YEAR FROM
THE DATE HEREOF.

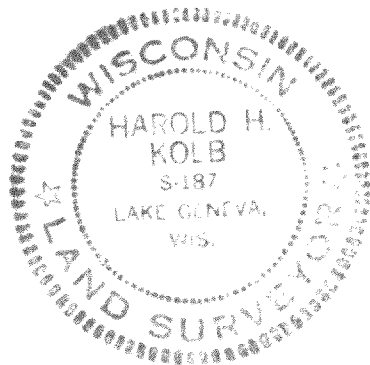

Harold H. Kolb

WISCONSIN REGISTERED LAND SURVEYOR, S- 187
DATE APRIL 4, 1938

216-774-K

FLAS-00002

2-16-FLAS-2