


DUNHAM SURVEYING, S.C.

SURVEYING & SUBDIVIDING
DELAVER, WISCONSIN 53115

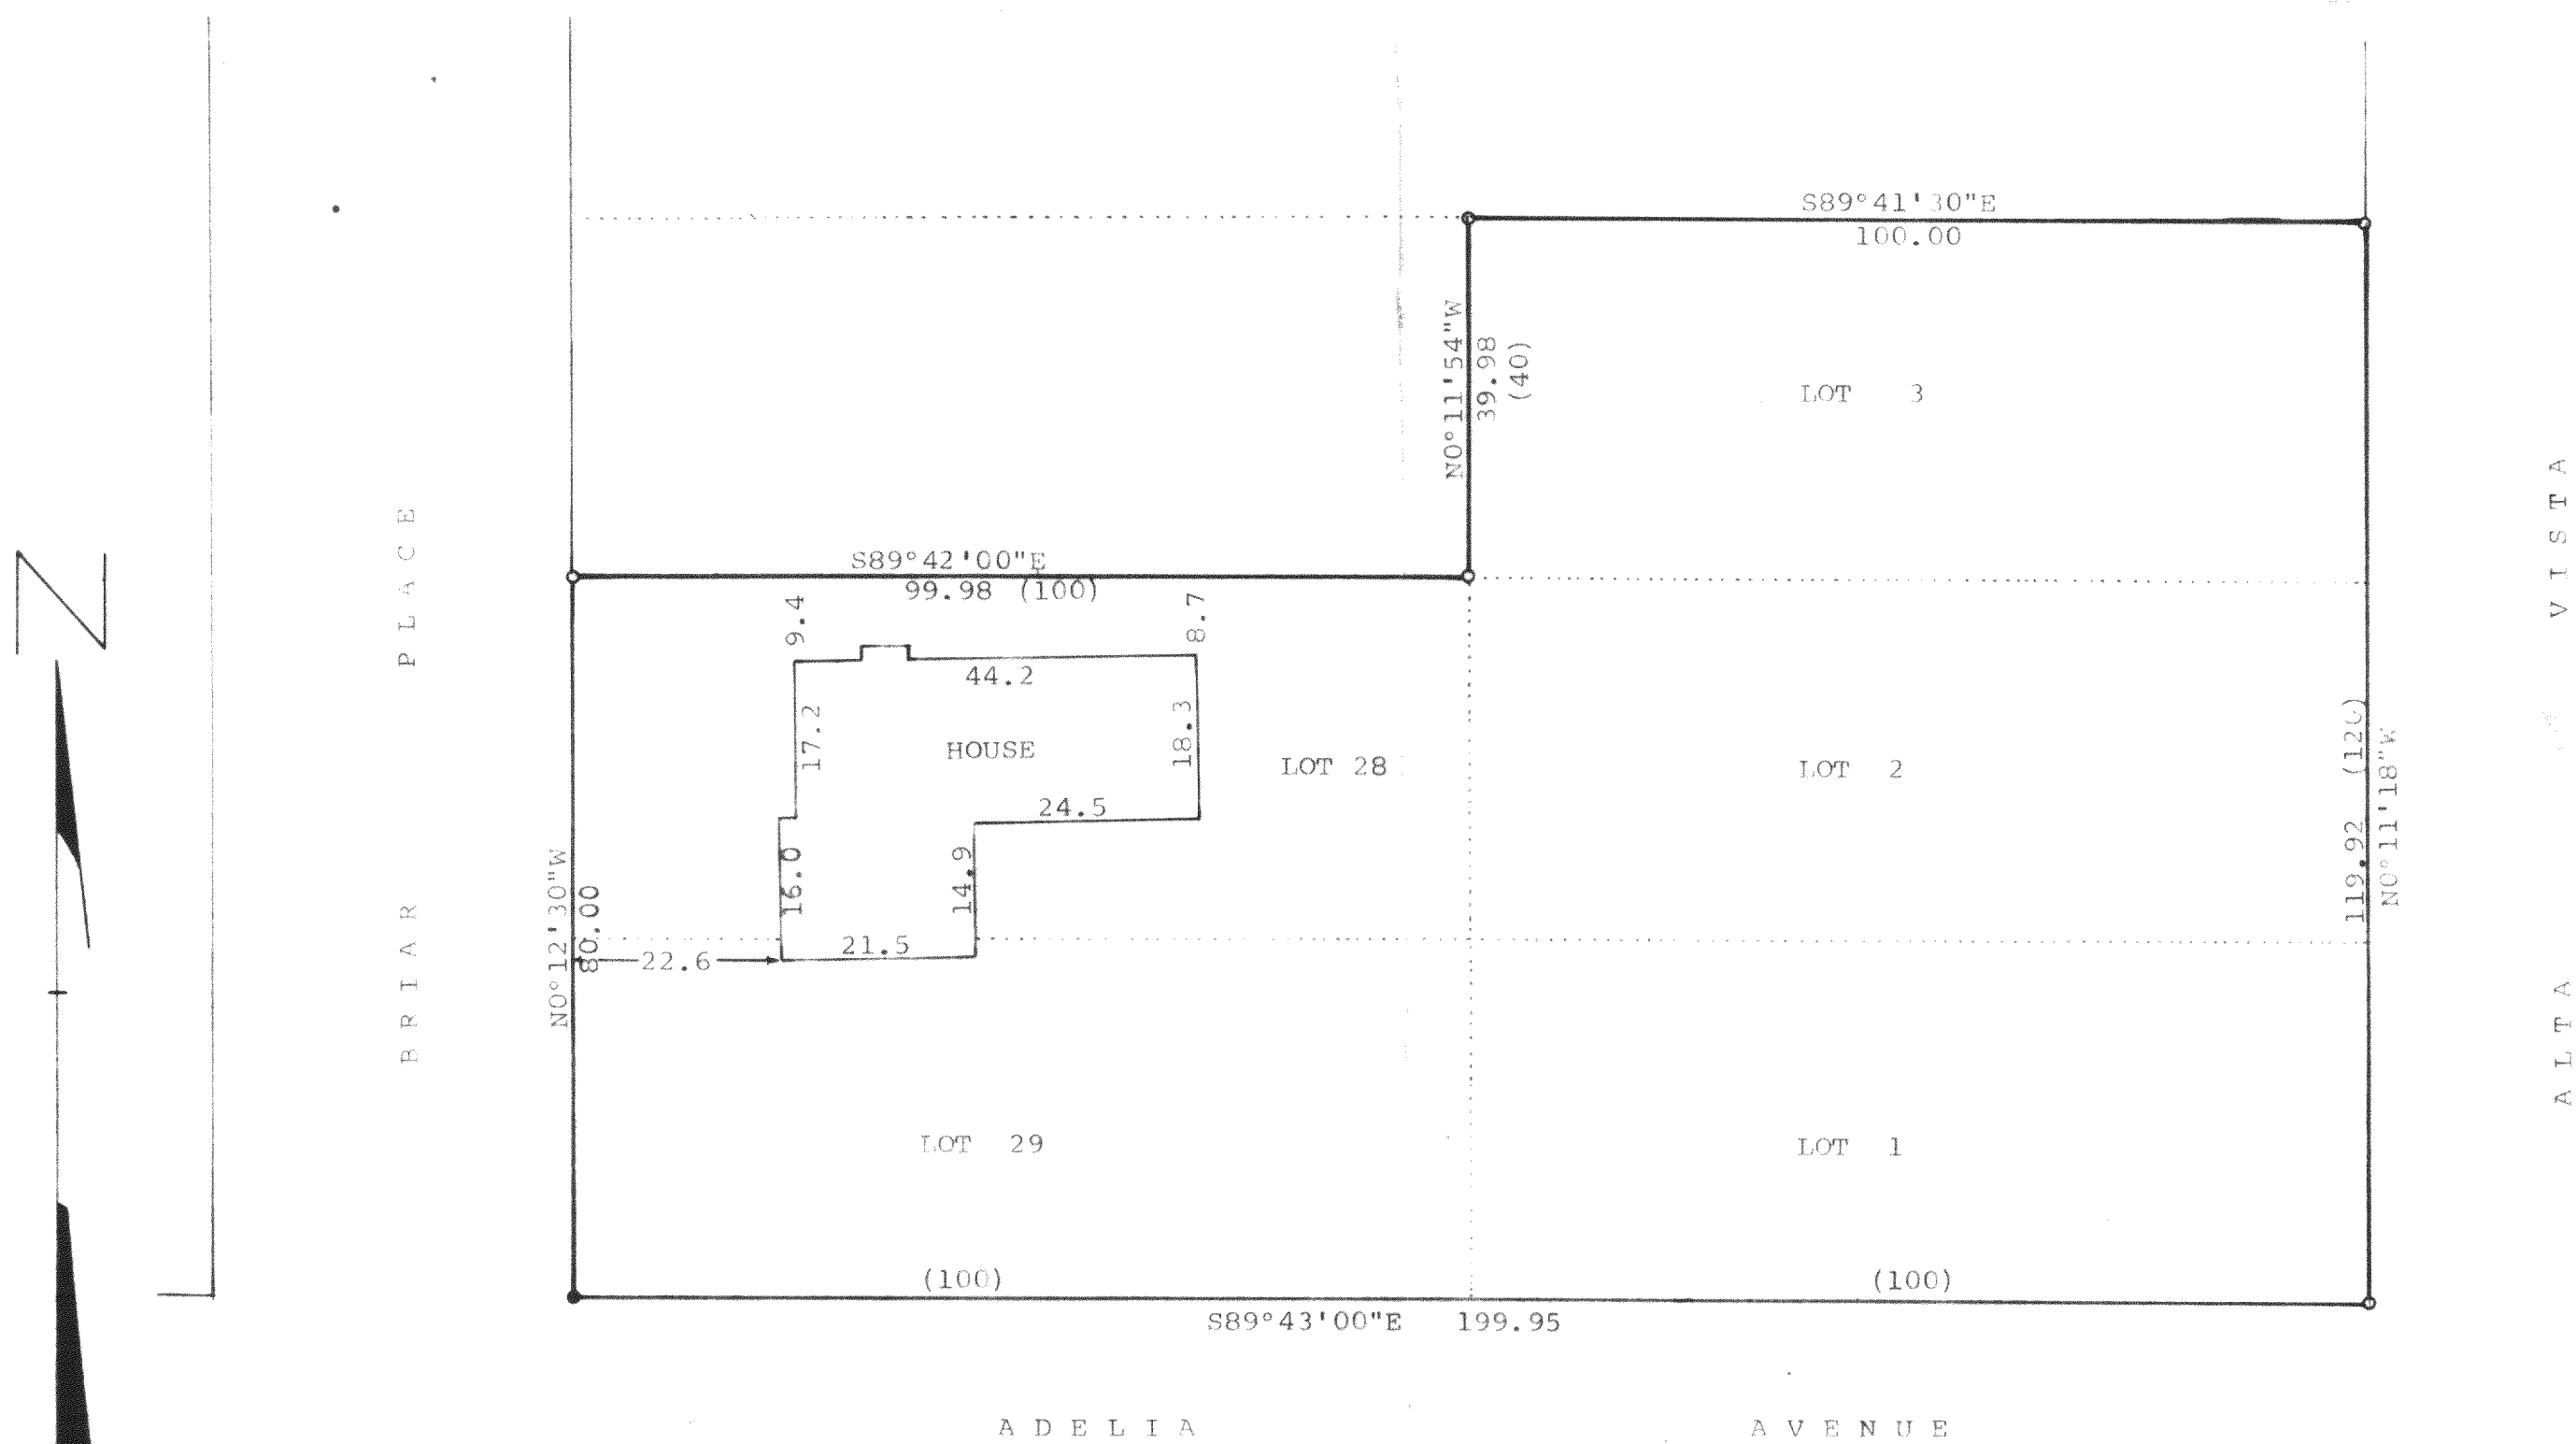

Scale - 1" = 20'

- = Concrete Monument Found
- = Iron Pipe Set
- (0) = Recorded Distance

Bearings referenced to the north line of Adelia Avenue, according to the recorded plat.

Survey ordered by:
Barry Ejelland
R. 2 Box 122A
Delavan, WI 53115

STATE OF WISCONSIN)
COUNTY OF WALWORTH)

I, James M. Dunham, Surveyor, certify that I have surveyed the property described as follows,

Lots 1, 2, 3, 28, and 29, Block 11 of South Shore Manor First Addition, a subdivision located in the Southeast 1/4 of Section 32, T 2 N, R 16 E, Walworth County, Wisconsin, and that the above map is a true representation thereof and shows the size and location of the property, its exterior boundaries, the location of all visible structures and dimensions of all principal buildings thereon, boundary fences, apparent easements, roadways and visible encroachments, if any.

This survey is made for the present owners of the property, and also those who purchase, mortgage, or guarantee the title thereto within one (1) year from date hereof.

March 31, 1982

James M. Dunham
James M. Dunham, Surveyor

