


KOLB LAND CONSULTING, INC.
LAND SURVEYING • SUBDIVIDING • LAND PLANNING

LAKE GENEVA, WISCONSIN 53147

NOTE: COMPLIANCE WITH A-E 2, 5(1), 6(A),
(B), (C), (D) AND 7 HAS BEEN WAIVED
BY THE CLIENT AS PERMITTED IN
A-E 5.01(E).

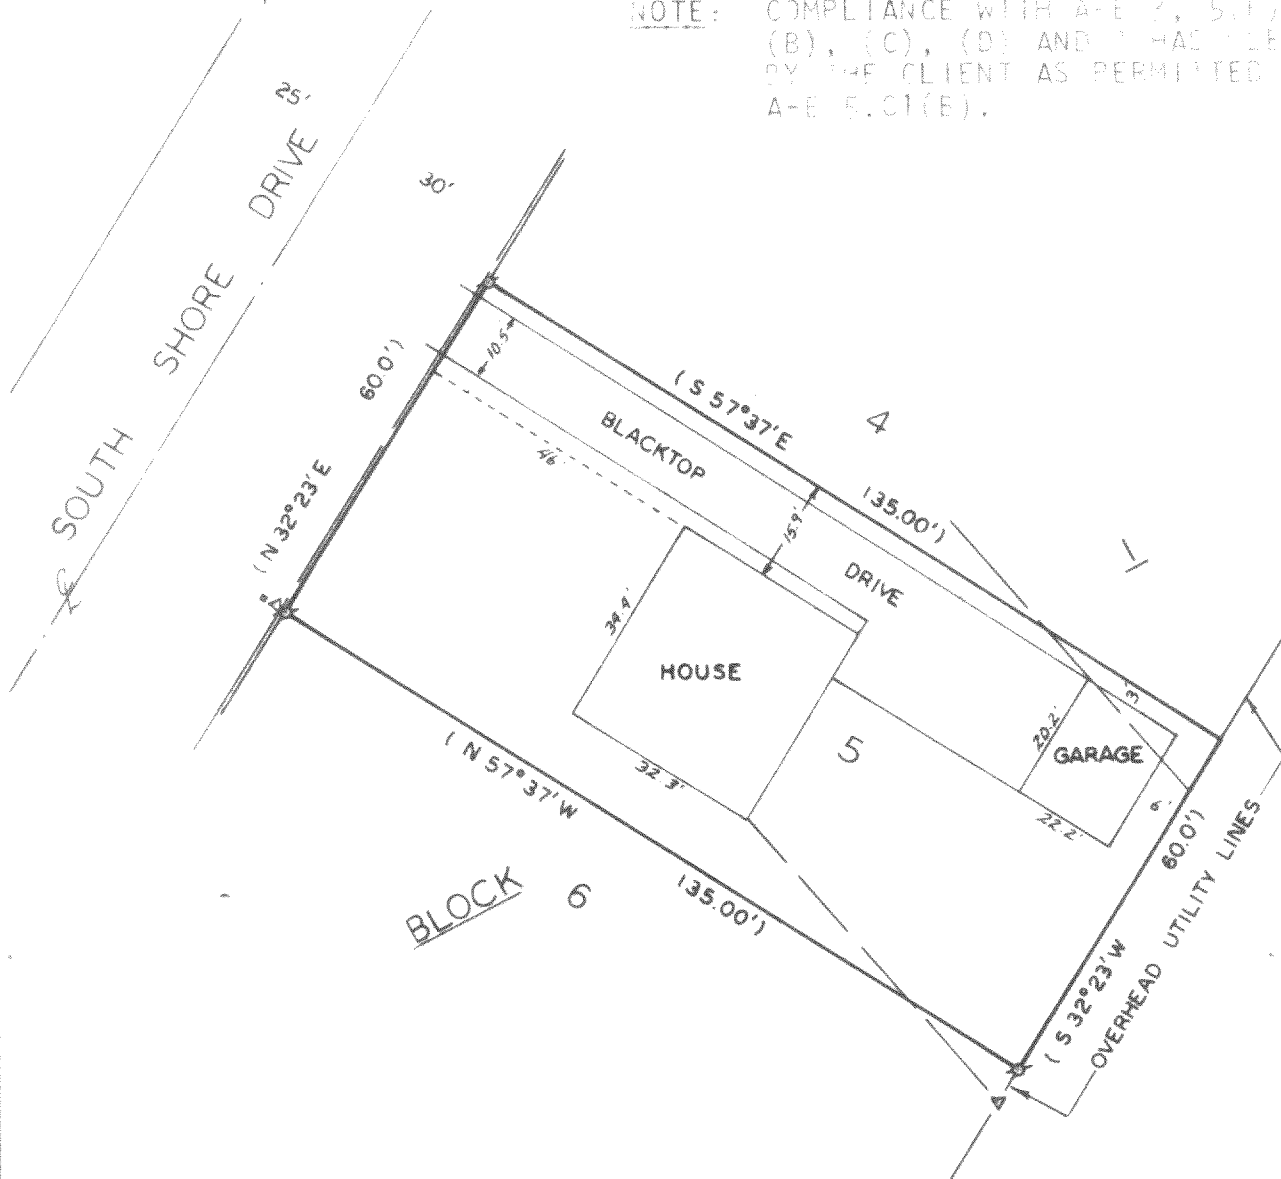


MOR GAGE INSPECTION OF

LOT 5, BLOCK 1, DELMAR SUBDIVISION, T2N, R16E,
WALWORTH COUNTY, WISCONSIN.

ORDERED BY: ANCHOR SAVINGS & LOAN
P.O. BOX 346
DELAVER, WI 53115

OWNER: EUGENE N. SHREVES, JR.
2516 SOUTH SHORE DR.
DELAVER, WI 53115

TAX NUMBER: FDM-2B

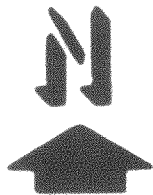

SCALE - 1"=30'

LEGEND

- Ø - IRON PIPE FOUND
- Δ - UTILITY POLE
- - TELEPHONE PED:
- () - RECORDED AS
- OVERHEAD UTILITY LINES

Harold H. Kolb
HAROLD H. KOLB
WISCONSIN REGISTERED LAND SURVEYOR, S- 187
DATE JAN. 10, 1989

216-777-K

FDM 00002B