


DUNHAM SURVEYING, S. C.
SURVEYING & SUBDIVIDING
DELAVER, WISCONSIN 53115

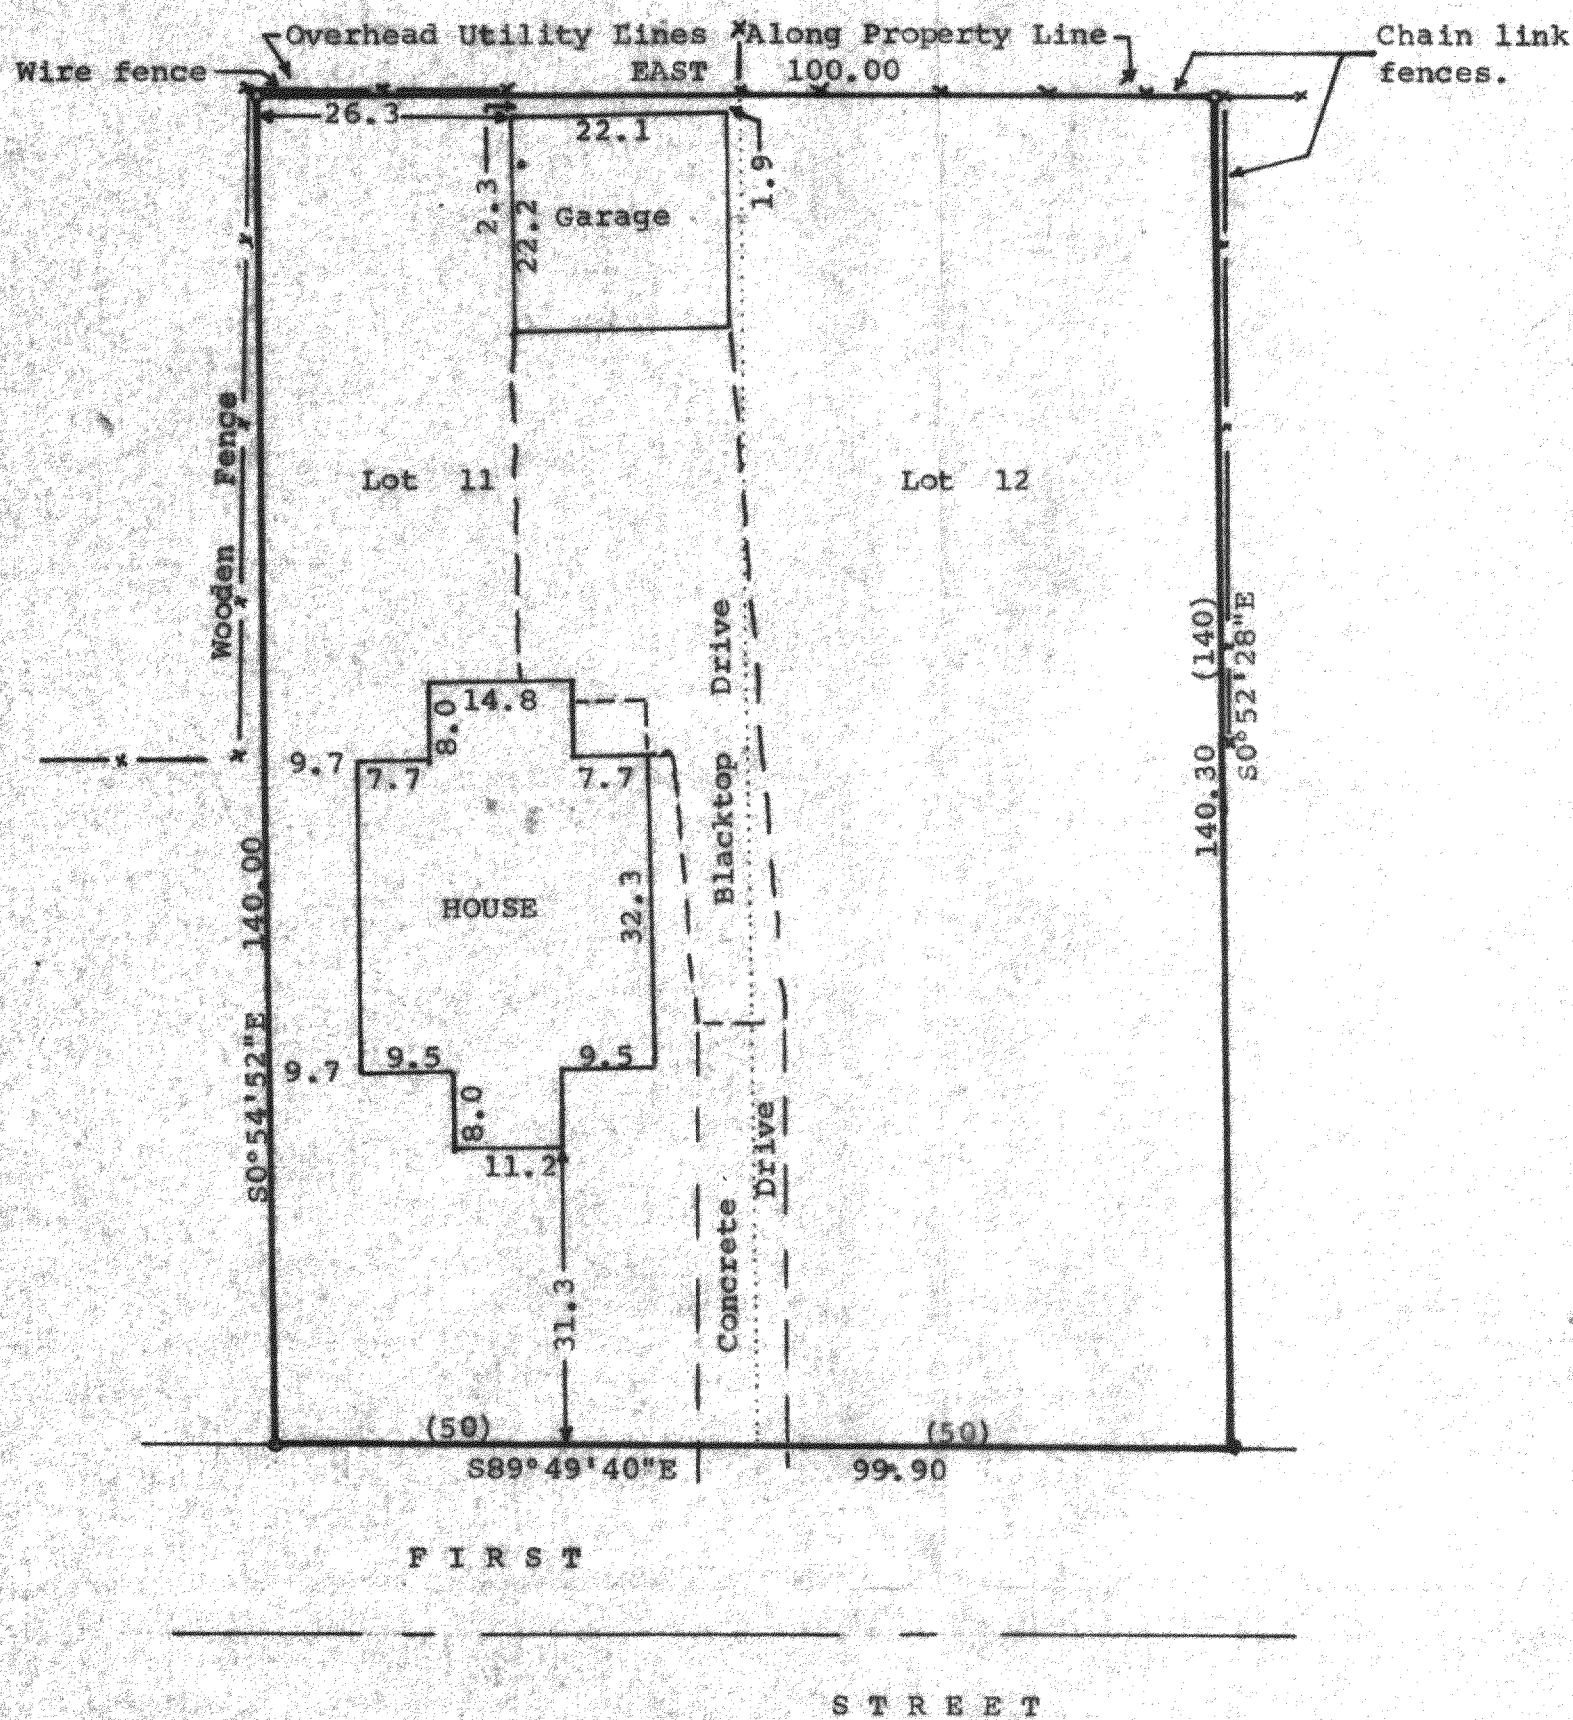

Scale - 1" = 20'
 • = 3/4" Dia. Iron Pipe Found
 • = 1 1/4" Dia. Iron Pipe Found
 (x.xx) = Recorded Distance


Bearings are referenced to the north line of lots 11 & 12. Assumed bearing is East.

Ordered by: The Rauland Agency, Inc.
 607 E. Walworth Ave.
 Delavan, Wisconsin 53115

STATE OF WISCONSIN)
 COUNTY OF WALWORTH)

I, George T. Dunham, Surveyor, certify that I have surveyed the property described as follows,
 Lots 11 and 12 in Block 2 of Inlet Oaks Subdivision
 No. 3 located in the Northeast 1/4 of Fractional Section
 22, T 2 N, R 16 E, Walworth County, Wisconsin,
 and that the above map is a true representation thereof and shows the size and location of the property, its exterior boundaries, the location of all visible structures and dimensions of all principal buildings thereon, boundary fences, apparent easements, roadways and visible encroachments, if any.
 This survey is made for the use of the present owners of the property, and also those who purchase, mortgage, or guarantee the title thereto within one (1) year from date hereof.
 February 17, 1983

George T. Dunham
 George T. Dunham, Surveyor

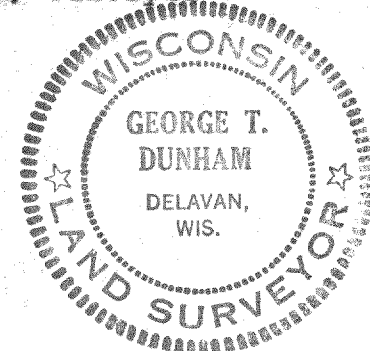

216-779-D