


DUNHAM SURVEYING, S.C.
SURVEYING & SUBDIVIDING
DELAVAN, WISCONSIN 53115

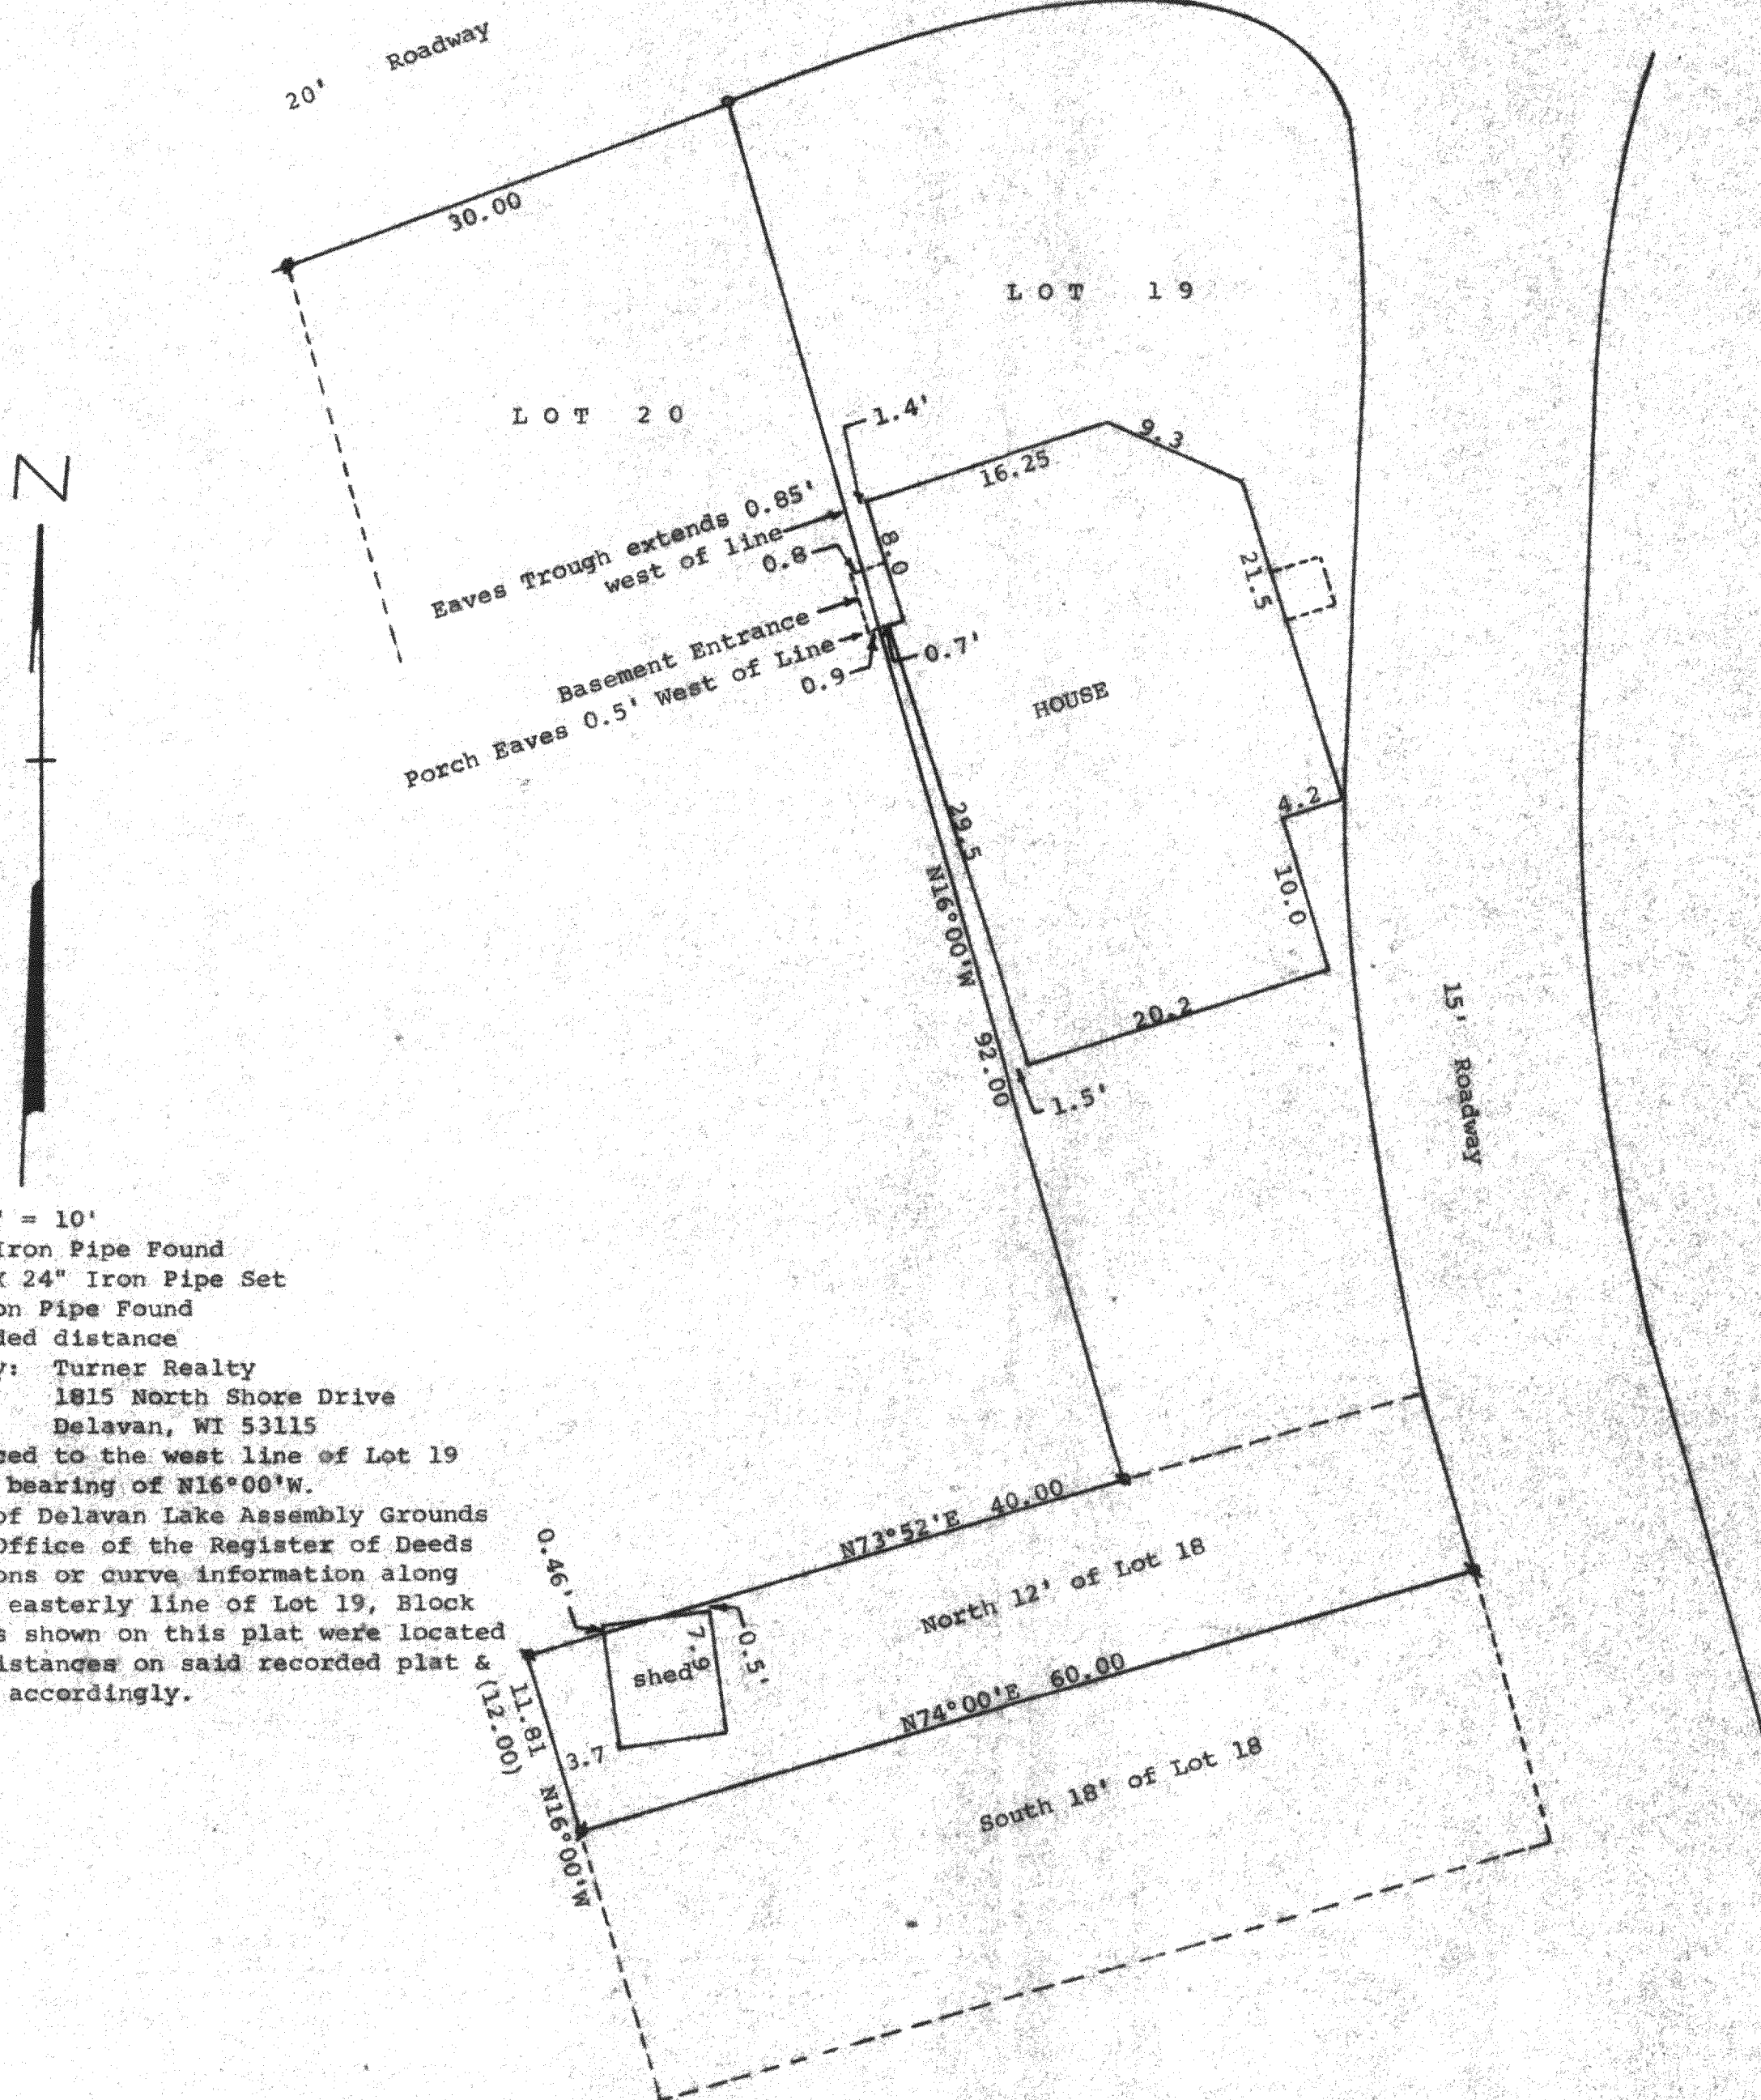

Scale - 1" = 10'
 * = 3/4" Iron Pipe Found
 o = 3/4" X 24" Iron Pipe Set
 v = 1" Iron Pipe Found

(0.00) = recorded distance
 Survey ordered by: Turner Realty
 1815 North Shore Drive
 Delavan, WI 53115

Bearings referenced to the west line of Lot 19 with the assumed bearing of N16°00'W.

Note: The plat of Delavan Lake Assembly Grounds recorded in the Office of the Register of Deeds shows no dimensions or curve information along the northerly or easterly line of Lot 19, Block "O". These lines shown on this plat were located by scaling the distances on said recorded plat & drawing the plat accordingly.

STATE OF WISCONSIN) SS
 COUNTY OF WALWORTH)

I, George T. Dunham, Surveyor, certify that I have surveyed the property described as follows:
 Lot 19 and the Northerly 12.00 feet of Lot 18, Block "O", Delavan Lake Assembly Grounds, located in the Southeast Fractional 1/4 of Section 21, T 2 N, R 16 E, Walworth County, Wisconsin,
 and that the above map is a true representation thereof and shows the size and location of the property, its exterior boundaries, the location of all visible structures and dimensions of all principal buildings thereon, boundary fences, apparent easements, roadways and visible encroachments, if any, and that I have surveyed the property hereon described according to the official records, to the best of my knowledge and belief.
 August 30, 1983

George T. Dunham
 George T. Dunham, Surveyor

