


DUNHAM SURVEYING, S.C.
SURVEYING & SUBDIVIDING
DELAVER, WISCONSIN 53115

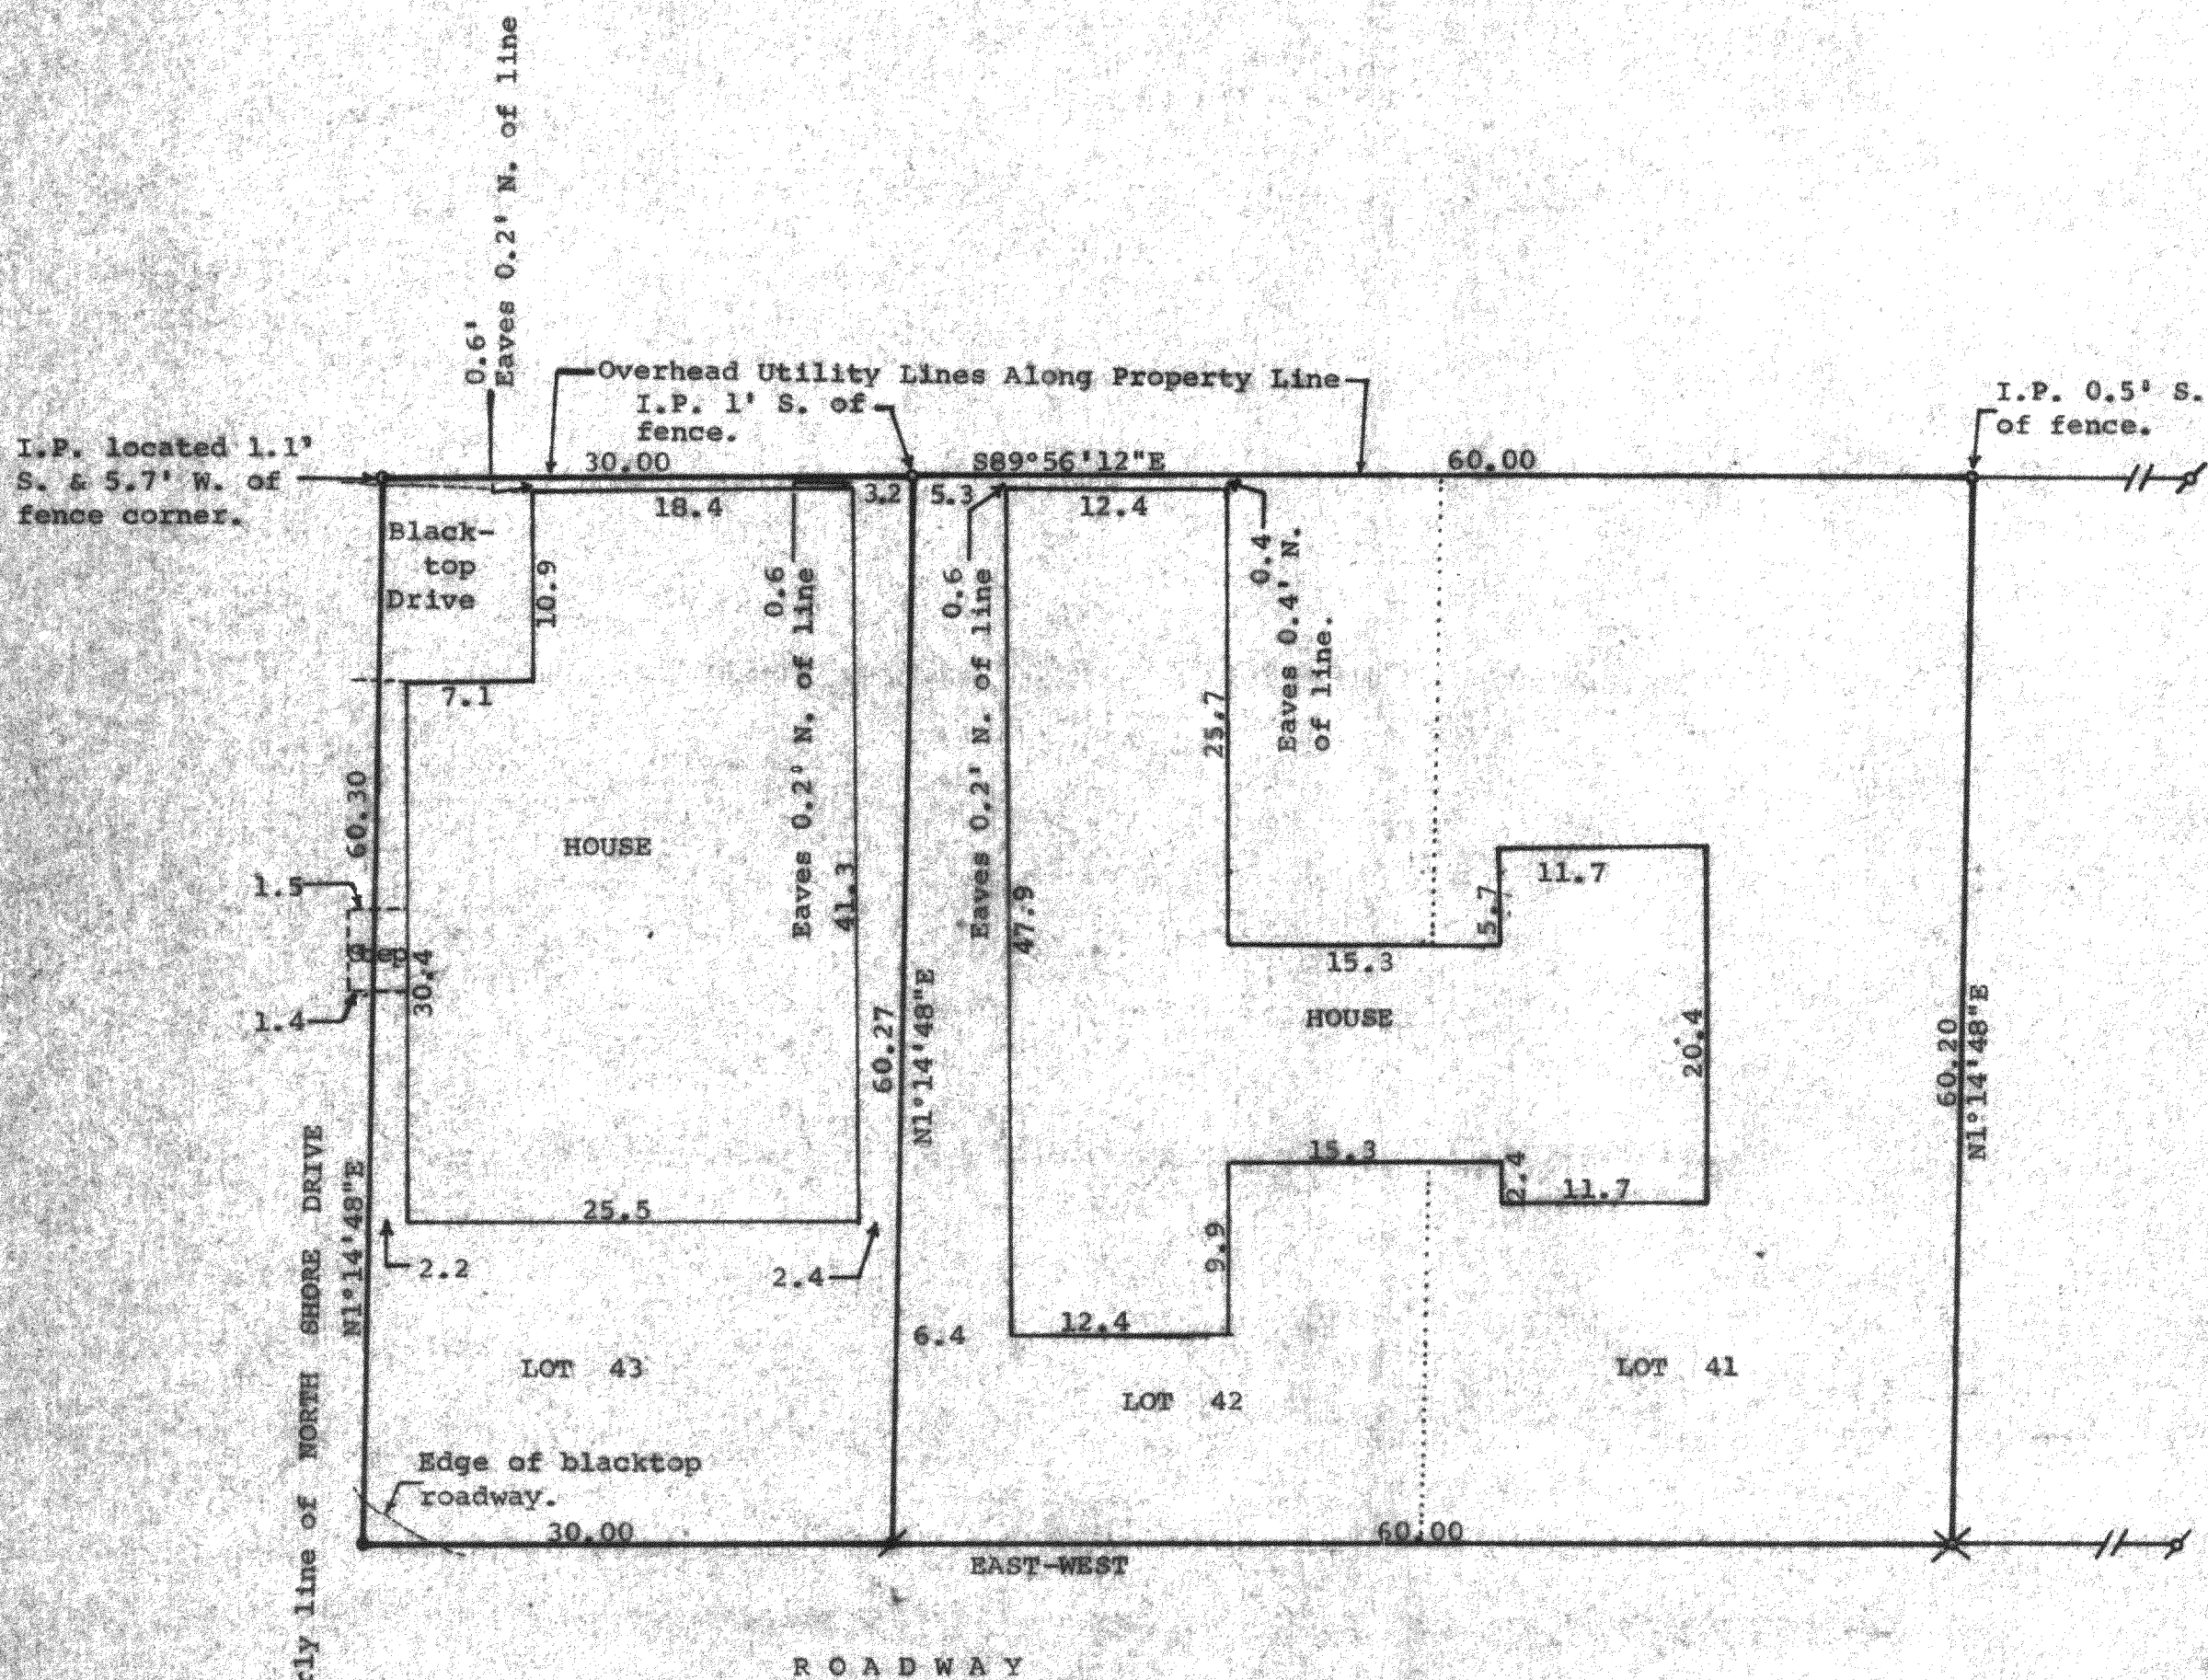

STATE OF WISCONSIN)
COUNTY OF WALWORTH)

I, George T. Dunham, Surveyor, certify that I have surveyed the property described as follows,
Lot 41 and 42, Block "A" of Jackson's Subdivision of Lots 5 & 6 of Mabie Wood and ALSO Lot 43, Block "A" of Jackson's Subdivision of Lots 5 & 6 of Mabie Wood, all located in the Southwest 1/4 and in the Southeast 1/4 of the fractional Southeast 1/4 of fractional Section 21, T 2 N, R 16 E, Walworth County, Wisconsin, and that the above map is a true representation thereof and shows the size and location of the property, its exterior boundaries, the location of all visible structures and dimensions of all principal buildings thereon, boundary fences, apparent easements, roadways and visible encroachments, if any.
This survey is made for the use of the present owners of the property, and also those who purchase, mortgage, or guarantee the title thereto within one (1) year from date hereof.
February 17, 1983

George T. Dunham
George T. Dunham, Surveyor

