


LAKE GENEVA, WISCONSIN 53147

WHITEWATER, WISCONSIN 53190

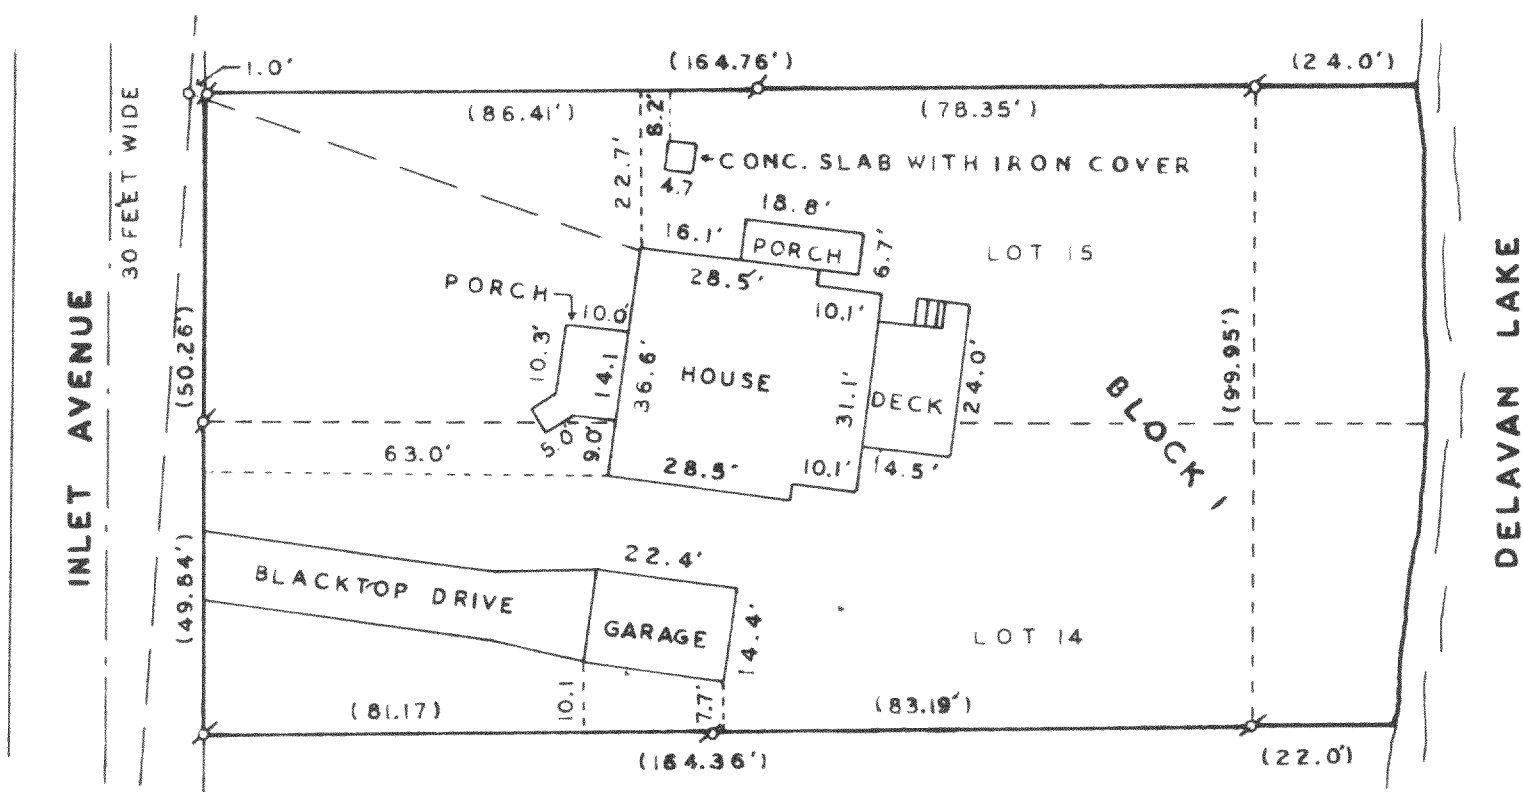


MORTGAGE INSPECTION OF

LOTS 14 AND 15, BLOCK 1, INLET OAKS, A SUBDIVISION
LOCATED IN TOWN 2 NORTH, RANGE 16 EAST, WALWORTH
COUNTY, WISCONSIN.

ORDERED BY: ANCHOR SAVINGS & LOAN ASSOCIATION
500 E. WALWORTH AVE.
DELAVAN, WISCONSIN 53115

BUYER: RICHARD SCHNIENDER

COMPLIANCE WITH A-E 3, 5(F), 6(A), (B), (C), (D) AND 7 HAS BEEN WAIVED BY
THE CLIENT, IN AGREEMENT WITH THE SURVEYOR, AS PERMITTED IN A-E5.01(B).

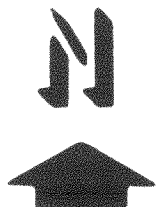

SCALE - 1" = 30'

LEGEND

- ⊗ - IRON PIPE FOUND
- (7') - RECORDED AS AND AS SHOWN
ON EXISTING SURVEYS
- — — OVERHEAD UTILITY LINES
- o - UTILITY POLE

Harold H. Kolb
HAROLD H. KOLB

WISCONSIN REGISTERED LAND SURVEYOR, S- 187

DATE JUNE 18, 1984