


DUNHAM SURVEYING, S.C.
SURVEYING & SUBDIVIDING
DELAVER, WISCONSIN 53115

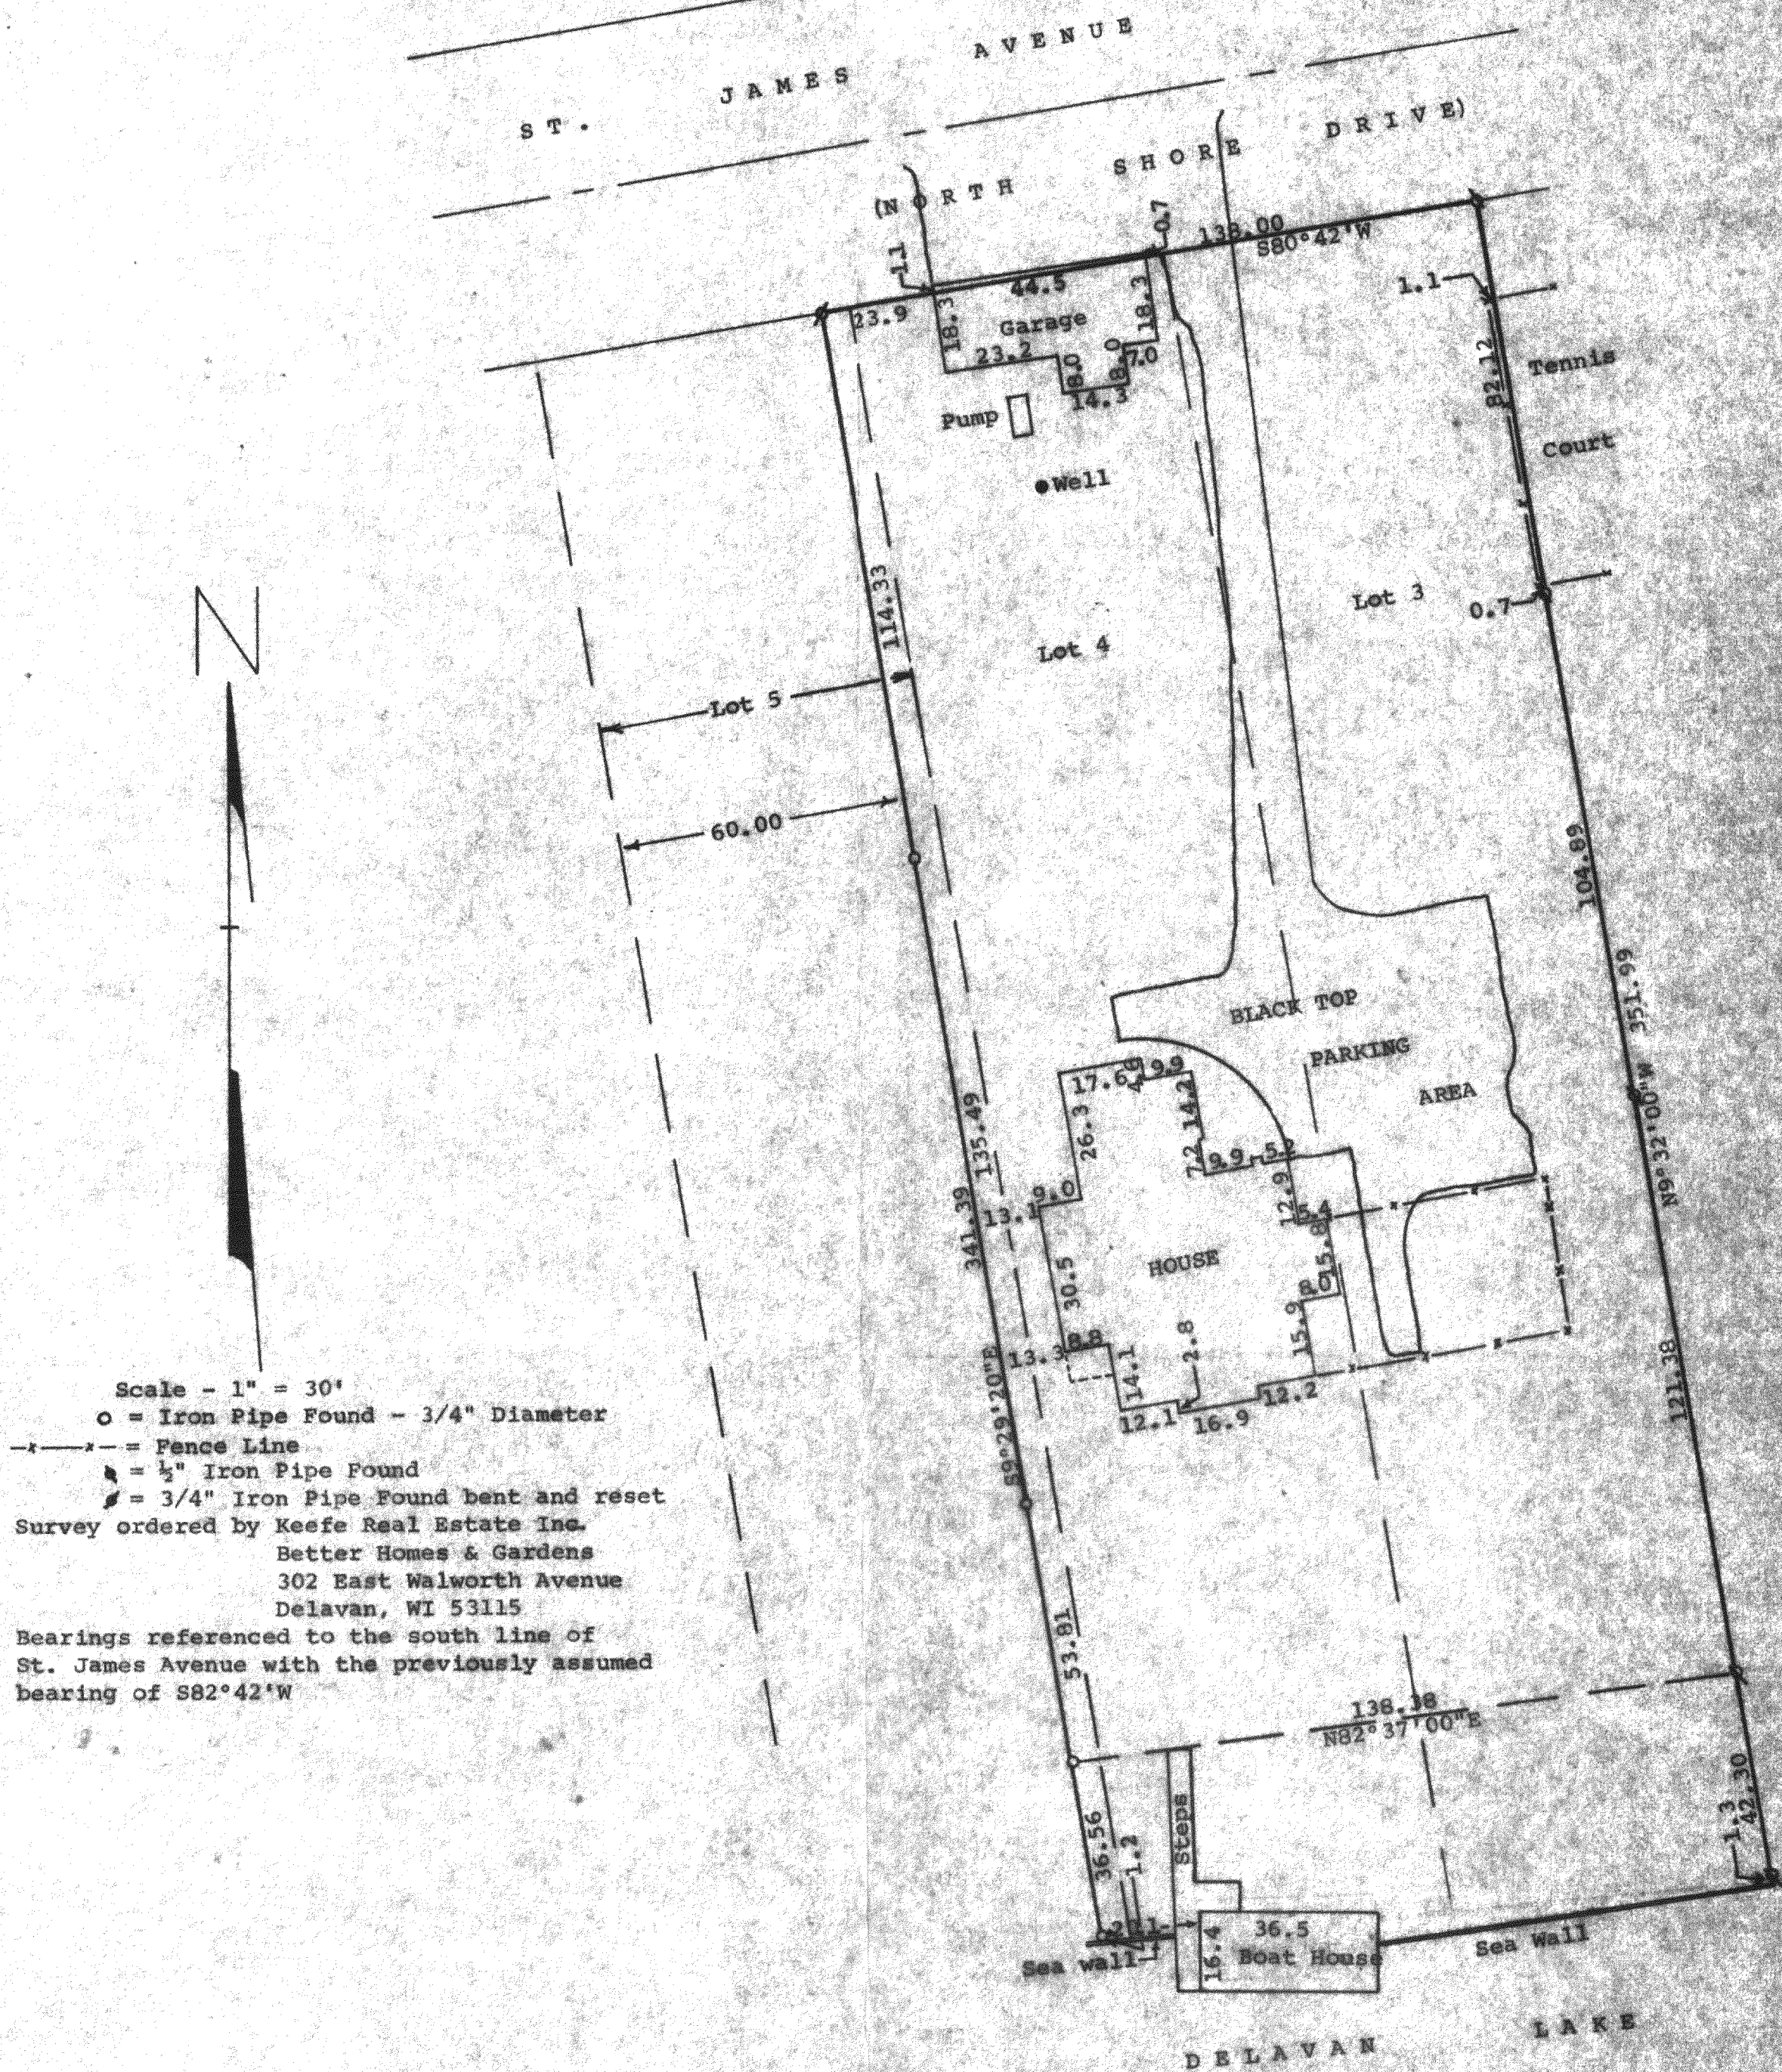

STATE OF WISCONSIN)
COUNTY OF WALWORTH) SS

I, George T. Dunham, Surveyor, certify that I have
surveyed the property described as follows:


Lots 3, 4, and 5, EXCEPT the westerly 60.00 feet of
said Lot 5, all in St. Mary's of Delavan Lake, a
subdivision located in Section 28, T2N, R16E, Walworth
County, Wisconsin,

and that the above map is a true representation thereof and shows
the size and location of the property, its exterior boundaries, the
location of all visible structures and dimensions of all principal
buildings thereon, boundary fences, apparent easements, roadways and
visible encroachments, if any, and that I have surveyed the property
hereon described according to the official records, to the best of my
knowledge and belief.

September 28, 1977.

Revised June 23, 1983.

George T. Dunham
George T. Dunham, Surveyor

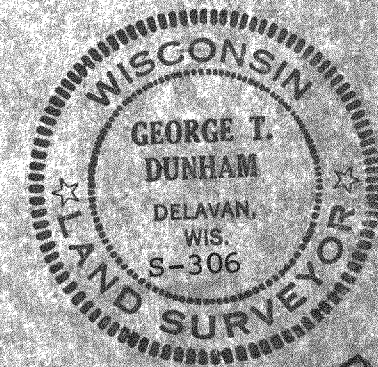

216-785