


DUNHAM SURVEYING, S.C.
SURVEYING & SUBDIVIDING
DELAVER, WISCONSIN 53115

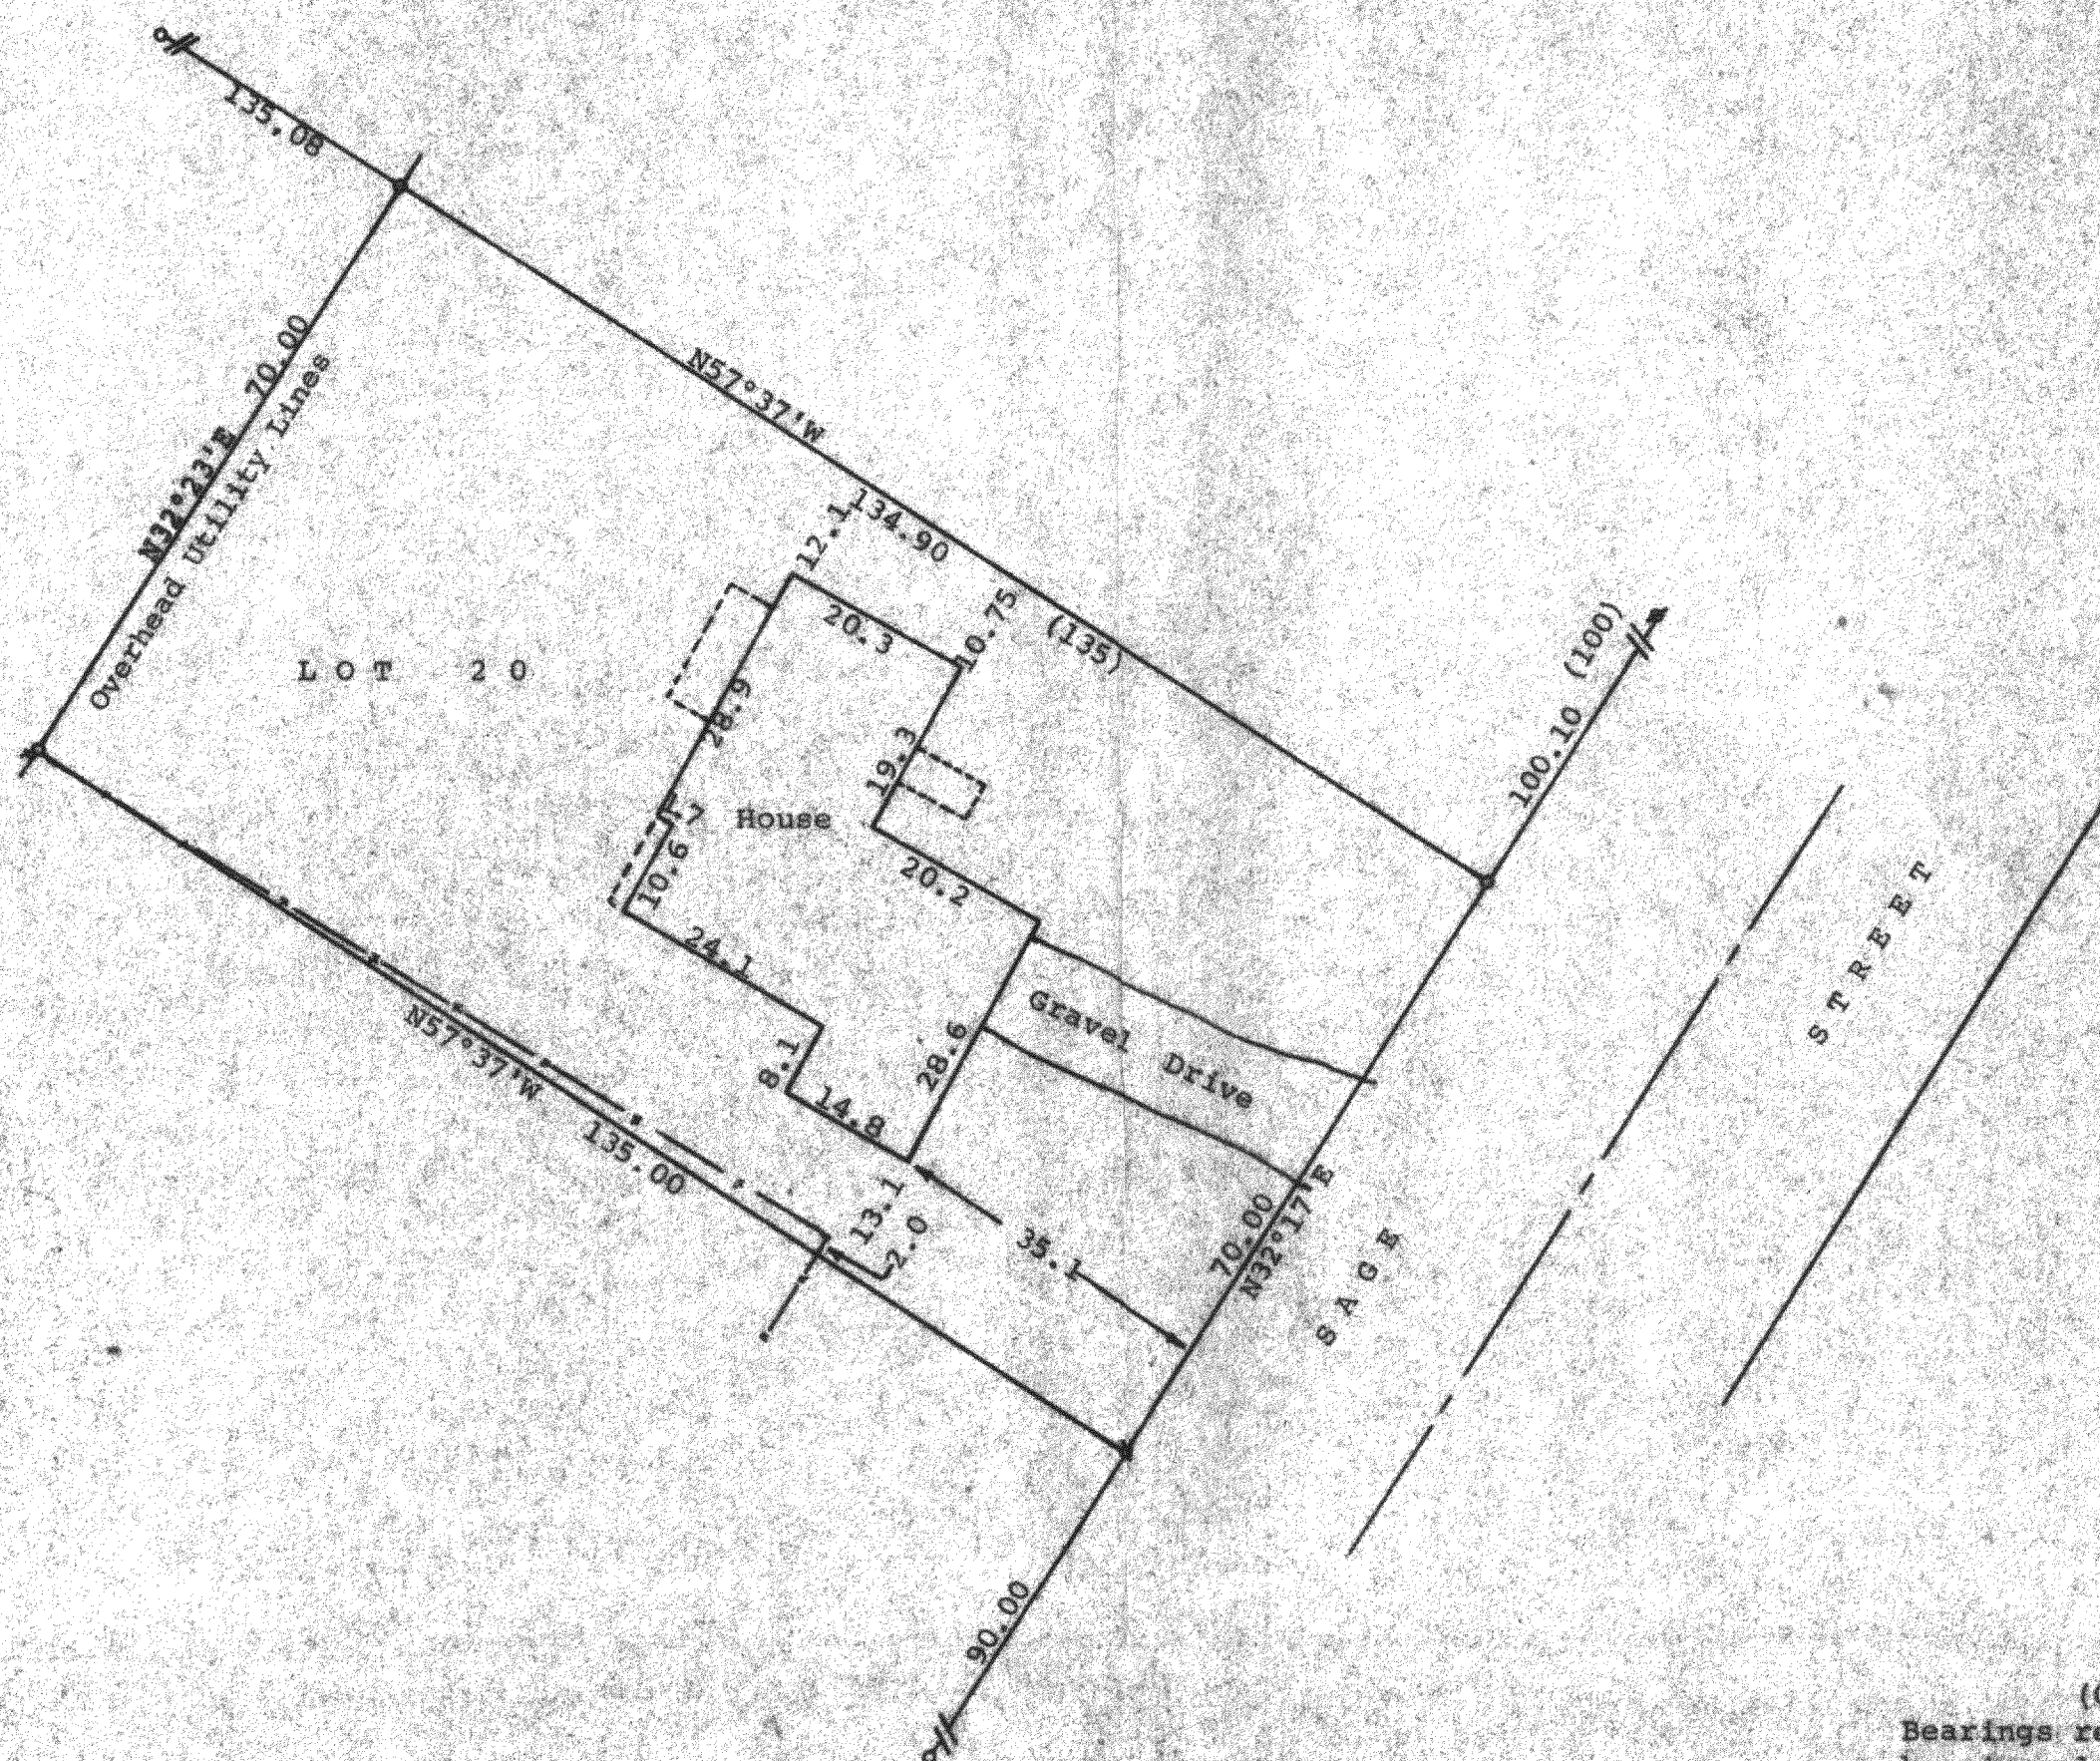

Scale - 1" = 20'
 o = 1" Iron Pipe Found
 a = good rust mark found
 3/4" Iron pipe set
 1 1/2" Iron Pipe Found
 (0.00) = recorded distance
 Bearings referenced to the recorded
 bearing along the northeasterly line of
 Lot 20 of N57°37'W
 Owner: Jeffrey Kaplan
 Sage Street
 RFD
 Delavan, WI 53115
 ——— = picket fence line

STATE OF WISCONSIN) SS
 COUNTY OF WALWORTH)

I, George T. Dunham, Surveyor, certify that I have surveyed the
 property described as follows:

Lot 20 in Block 3 of Delmar, a subdivision located in the
 Town of Delavan, Walworth County, Wisconsin,
 and that the map shown above is a true representation thereof and shows the
 size and location of the property, its exterior boundaries, the location
 of all visible structures and dimensions of all principal buildings thereon,
 boundary fences, apparent easements, roadways and visible encroachments,
 if any, and that I have surveyed the property hereon described according
 to the official records, to the best of my knowledge and belief.
 August 30, 1983

George T. Dunham
 George T. Dunham, Surveyor

