


DUNHAM SURVEYING, S.C.
SURVEYING & SUBDIVIDING
DELAVAN, WISCONSIN 53115

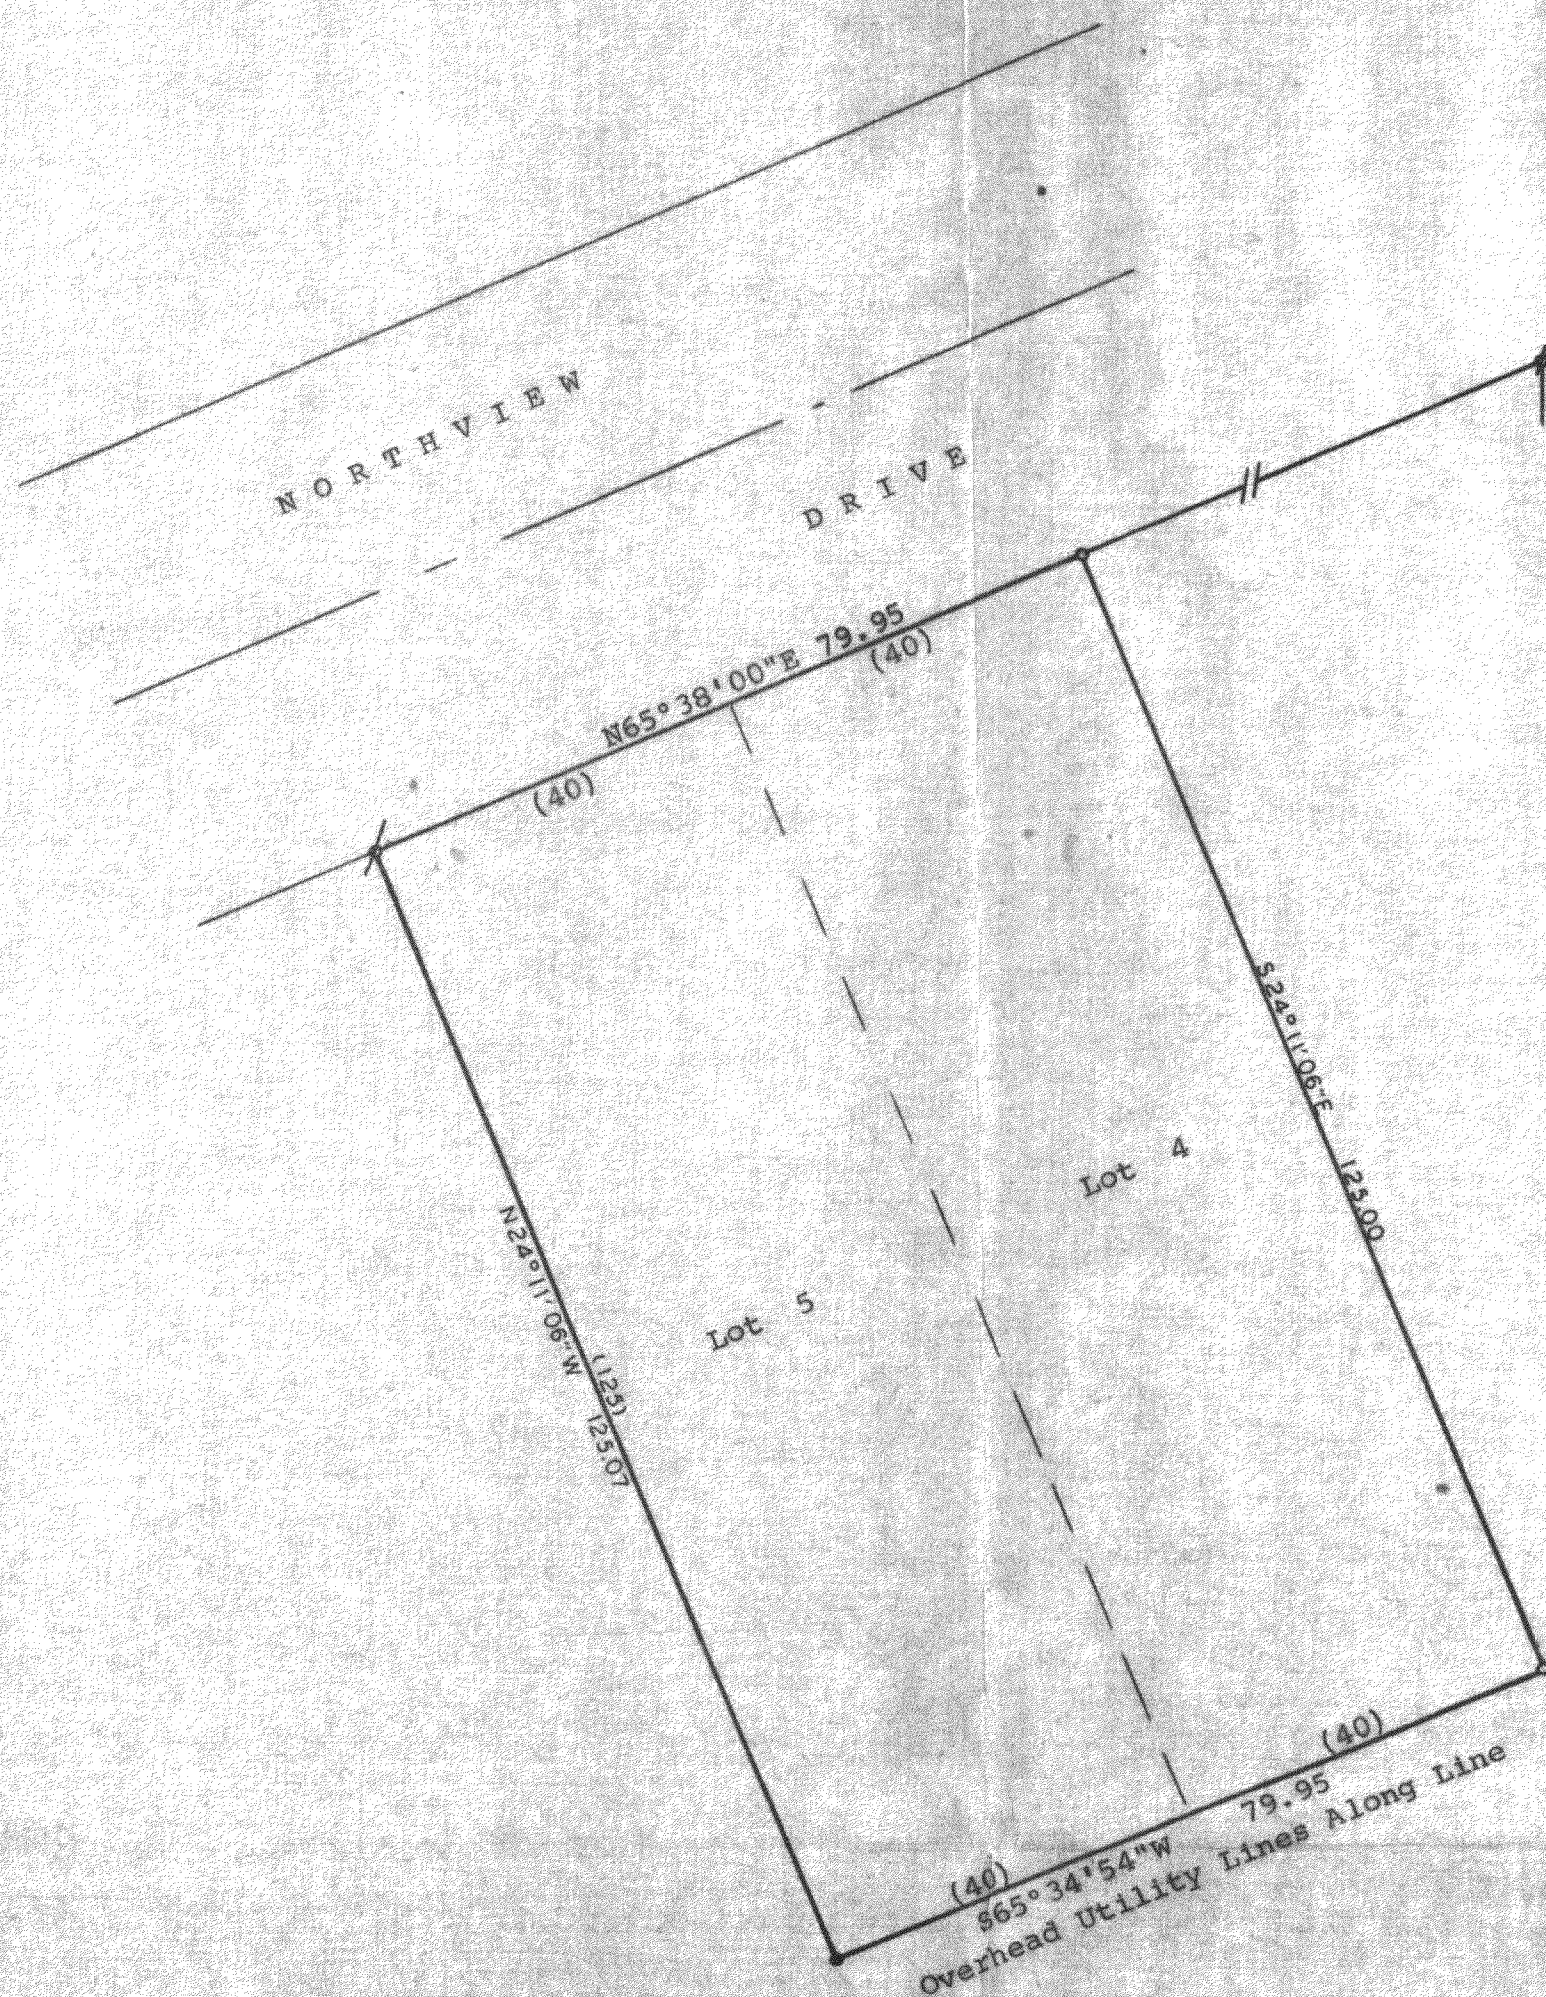

Scale - 1" = 20'
 / = 3/4" Iron Pipe Found
 o = 1" Iron Pipe Set
 • = Concrete Monument Found
 (00) = Recorded Distance

Bearings referenced to the southeasterly line of Northview Drive. Assumed bearing of N65°38'00"E used.

Owners: Nicholas Romashko
 7216 Emerson Street
 Morton Grove, Illinois 60053

STATE OF WISCONSIN)
 COUNTY OF WALWORTH) SS

I, George T. Dunham, Surveyor, certify that I have surveyed the property described as follows,
 Lots 4 and 5, Block 12 of Delavan Lake View Crest, a subdivision located in the North 1/2 of Section 31, T 2 N, R 16 E, Walworth County, Wisconsin, and that the above map is a true representation thereof and shows the size and location of the property, its exterior boundaries, the location of boundary fences, apparent easements, roadways and visible encroachments, if any, and that I have surveyed the property hereon described according to the official records to the best of my knowledge and belief.
 December 2, 1983

George T. Dunham
 George T. Dunham, Surveyor

