


DUNHAM SURVEYING, S.C.
SURVEYING & SUBDIVIDING
DELAVAN, WISCONSIN 53115

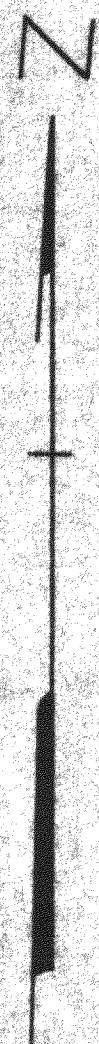


Scale - 1" = 20'

- = 1 1/4" Iron Pipe Found
- o = 3/4" Iron Pipe Found
- = 3/4" X 2' Iron Pipe Set
- = 1" X 24" Iron Pipe Set

(0.00) = recorded distance

Bearings referenced to the SE'ly Line of Highland Drive with the assumed bearing of N 65°38'E

Owner: John Dykstra
Delavan, WI 53115

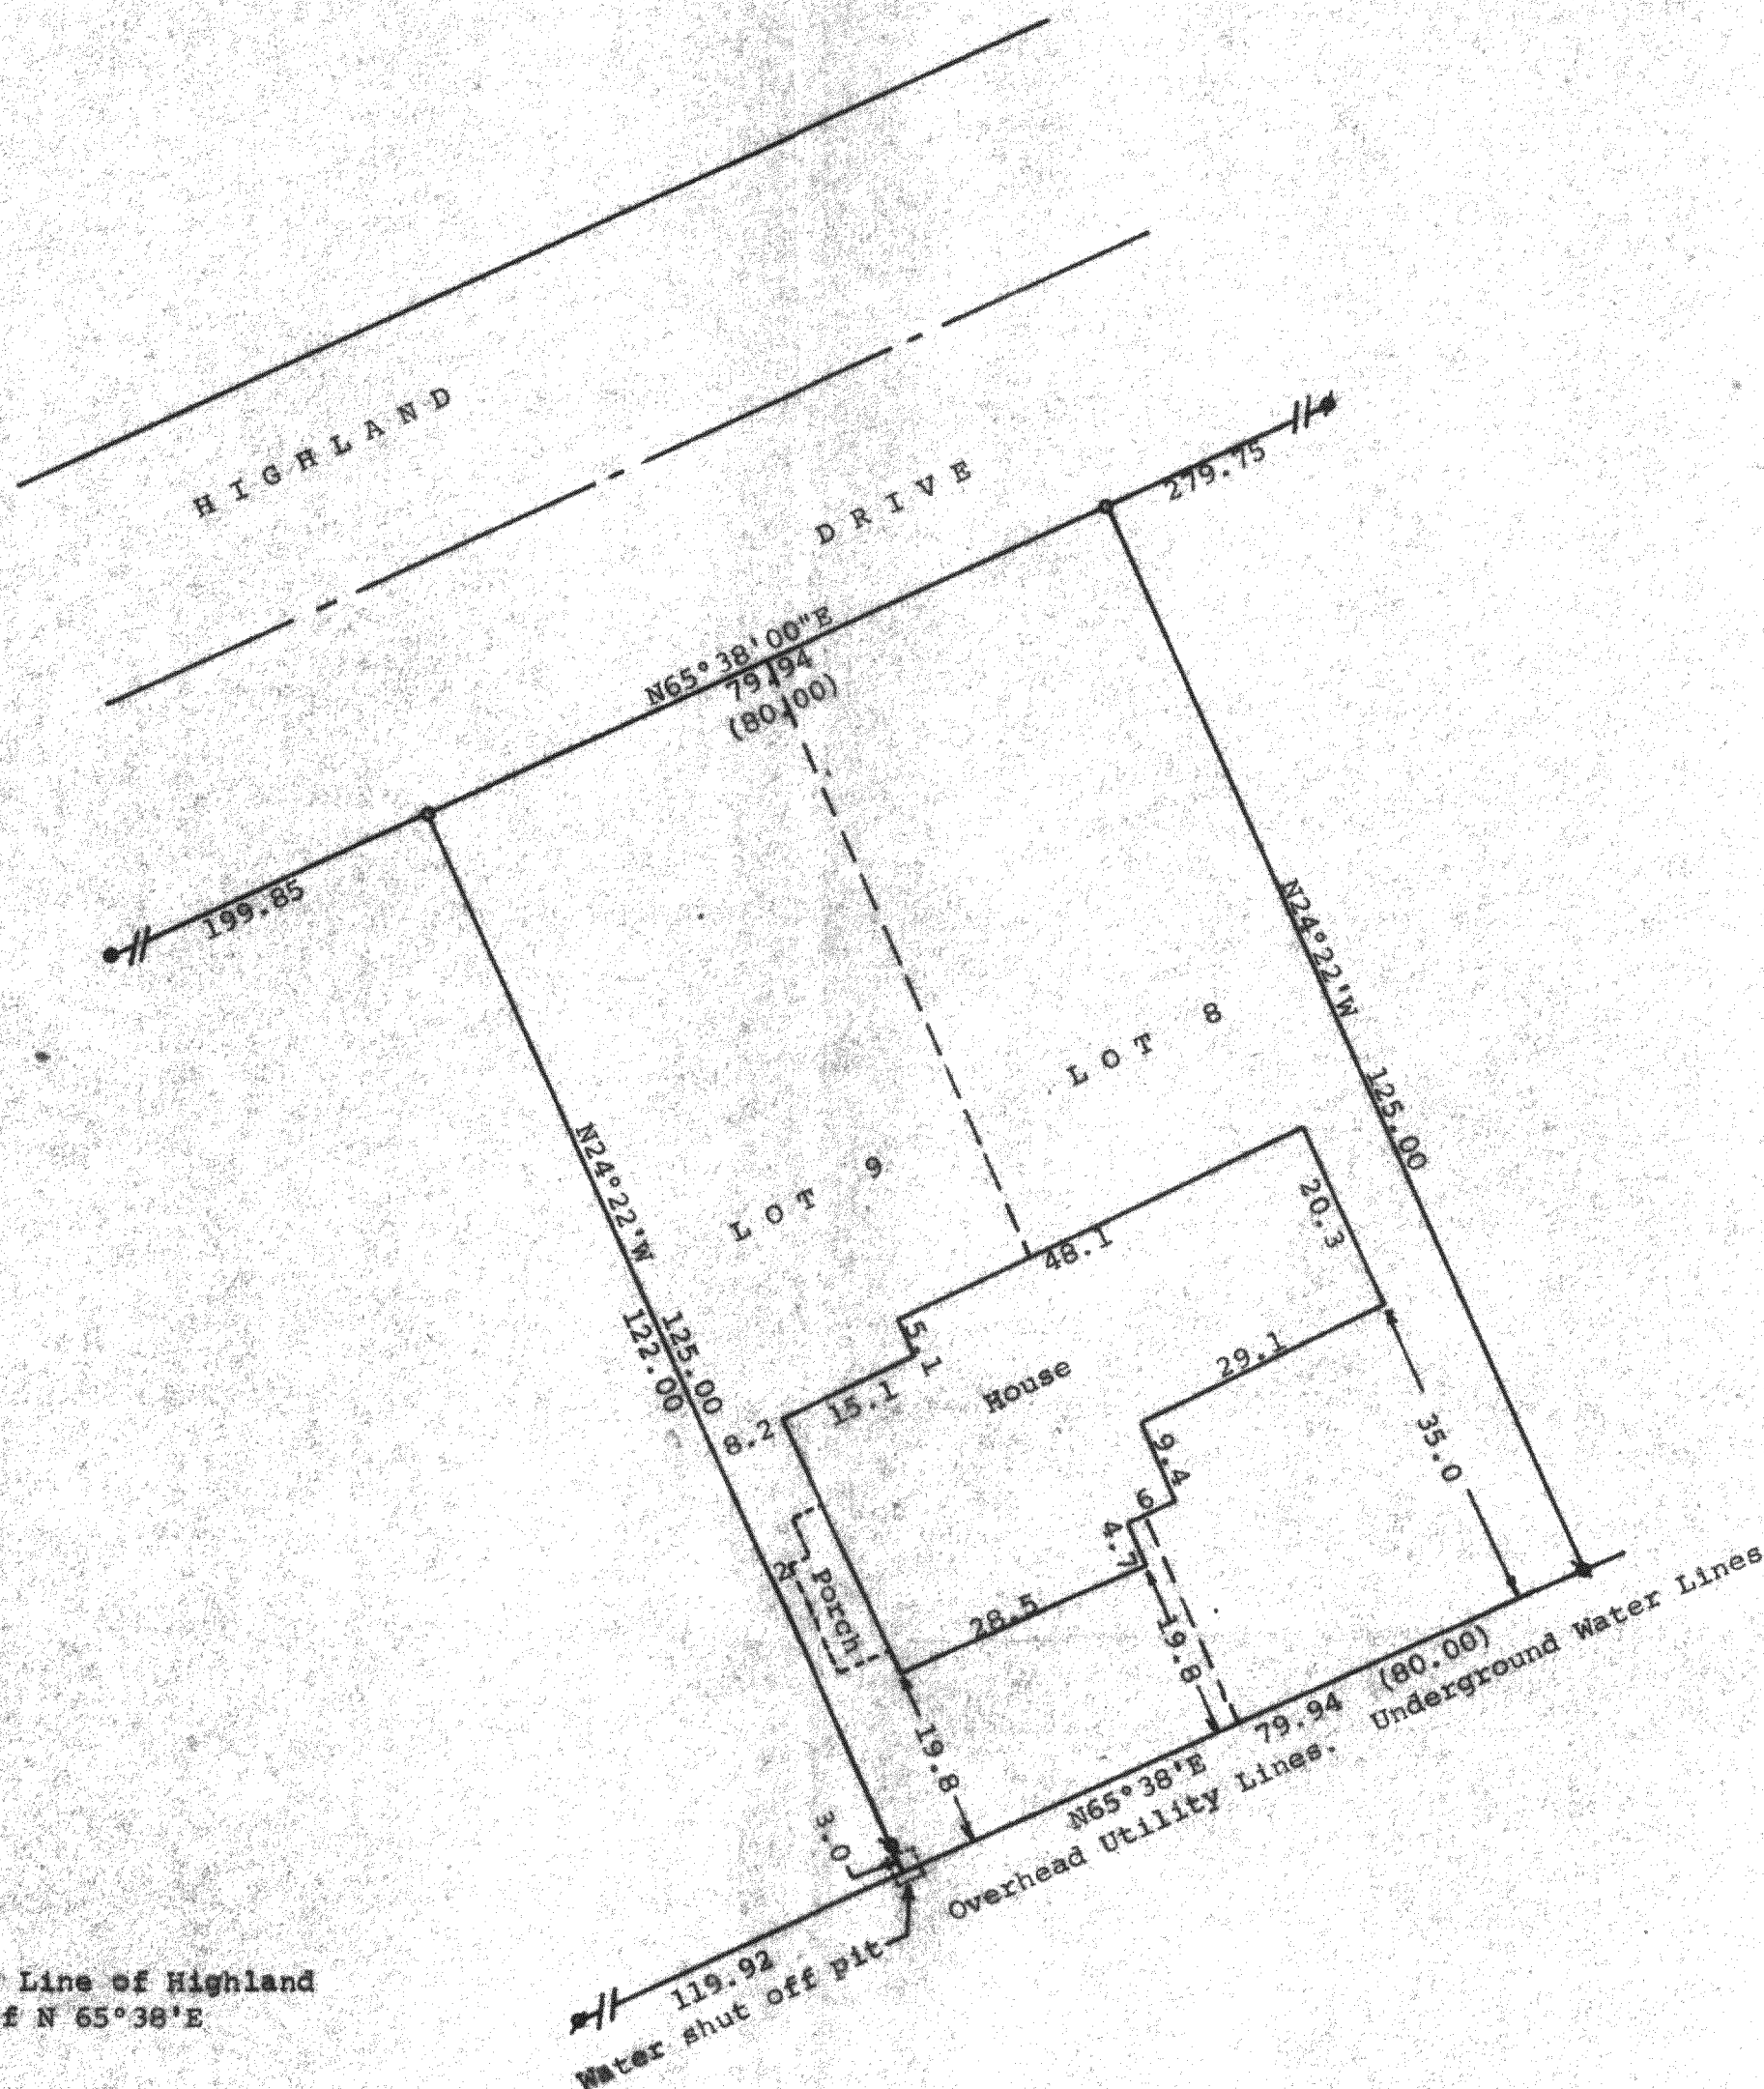

STATE OF WISCONSIN)
COUNTY OF WALWORTH)

I, George T. Dunham, Surveyor, certify that I have surveyed the property described as follows:

Lots 8 and 9 in Block 19, Delavan Lake View Crest, a subdivision located in the North 1/2 of Section 31, T 2 N, R 16 E, Walworth County, Wisconsin,

and that the above map is a true representation thereof and shows the size and location of the property, its exterior boundaries, the location of all visible structures and dimensions of all principal buildings thereon, boundary fences, apparent easements, roadways and visible encroachments, if any, and that I have surveyed the property hereon described according to the official records, to the best of my knowledge and belief.
August 31, 1983

George T. Dunham
George T. Dunham, Surveyor

