


DUNHAM SURVEYING, S.C.

SURVEYING & SUBDIVIDING
DELAVER, WISCONSIN 53115

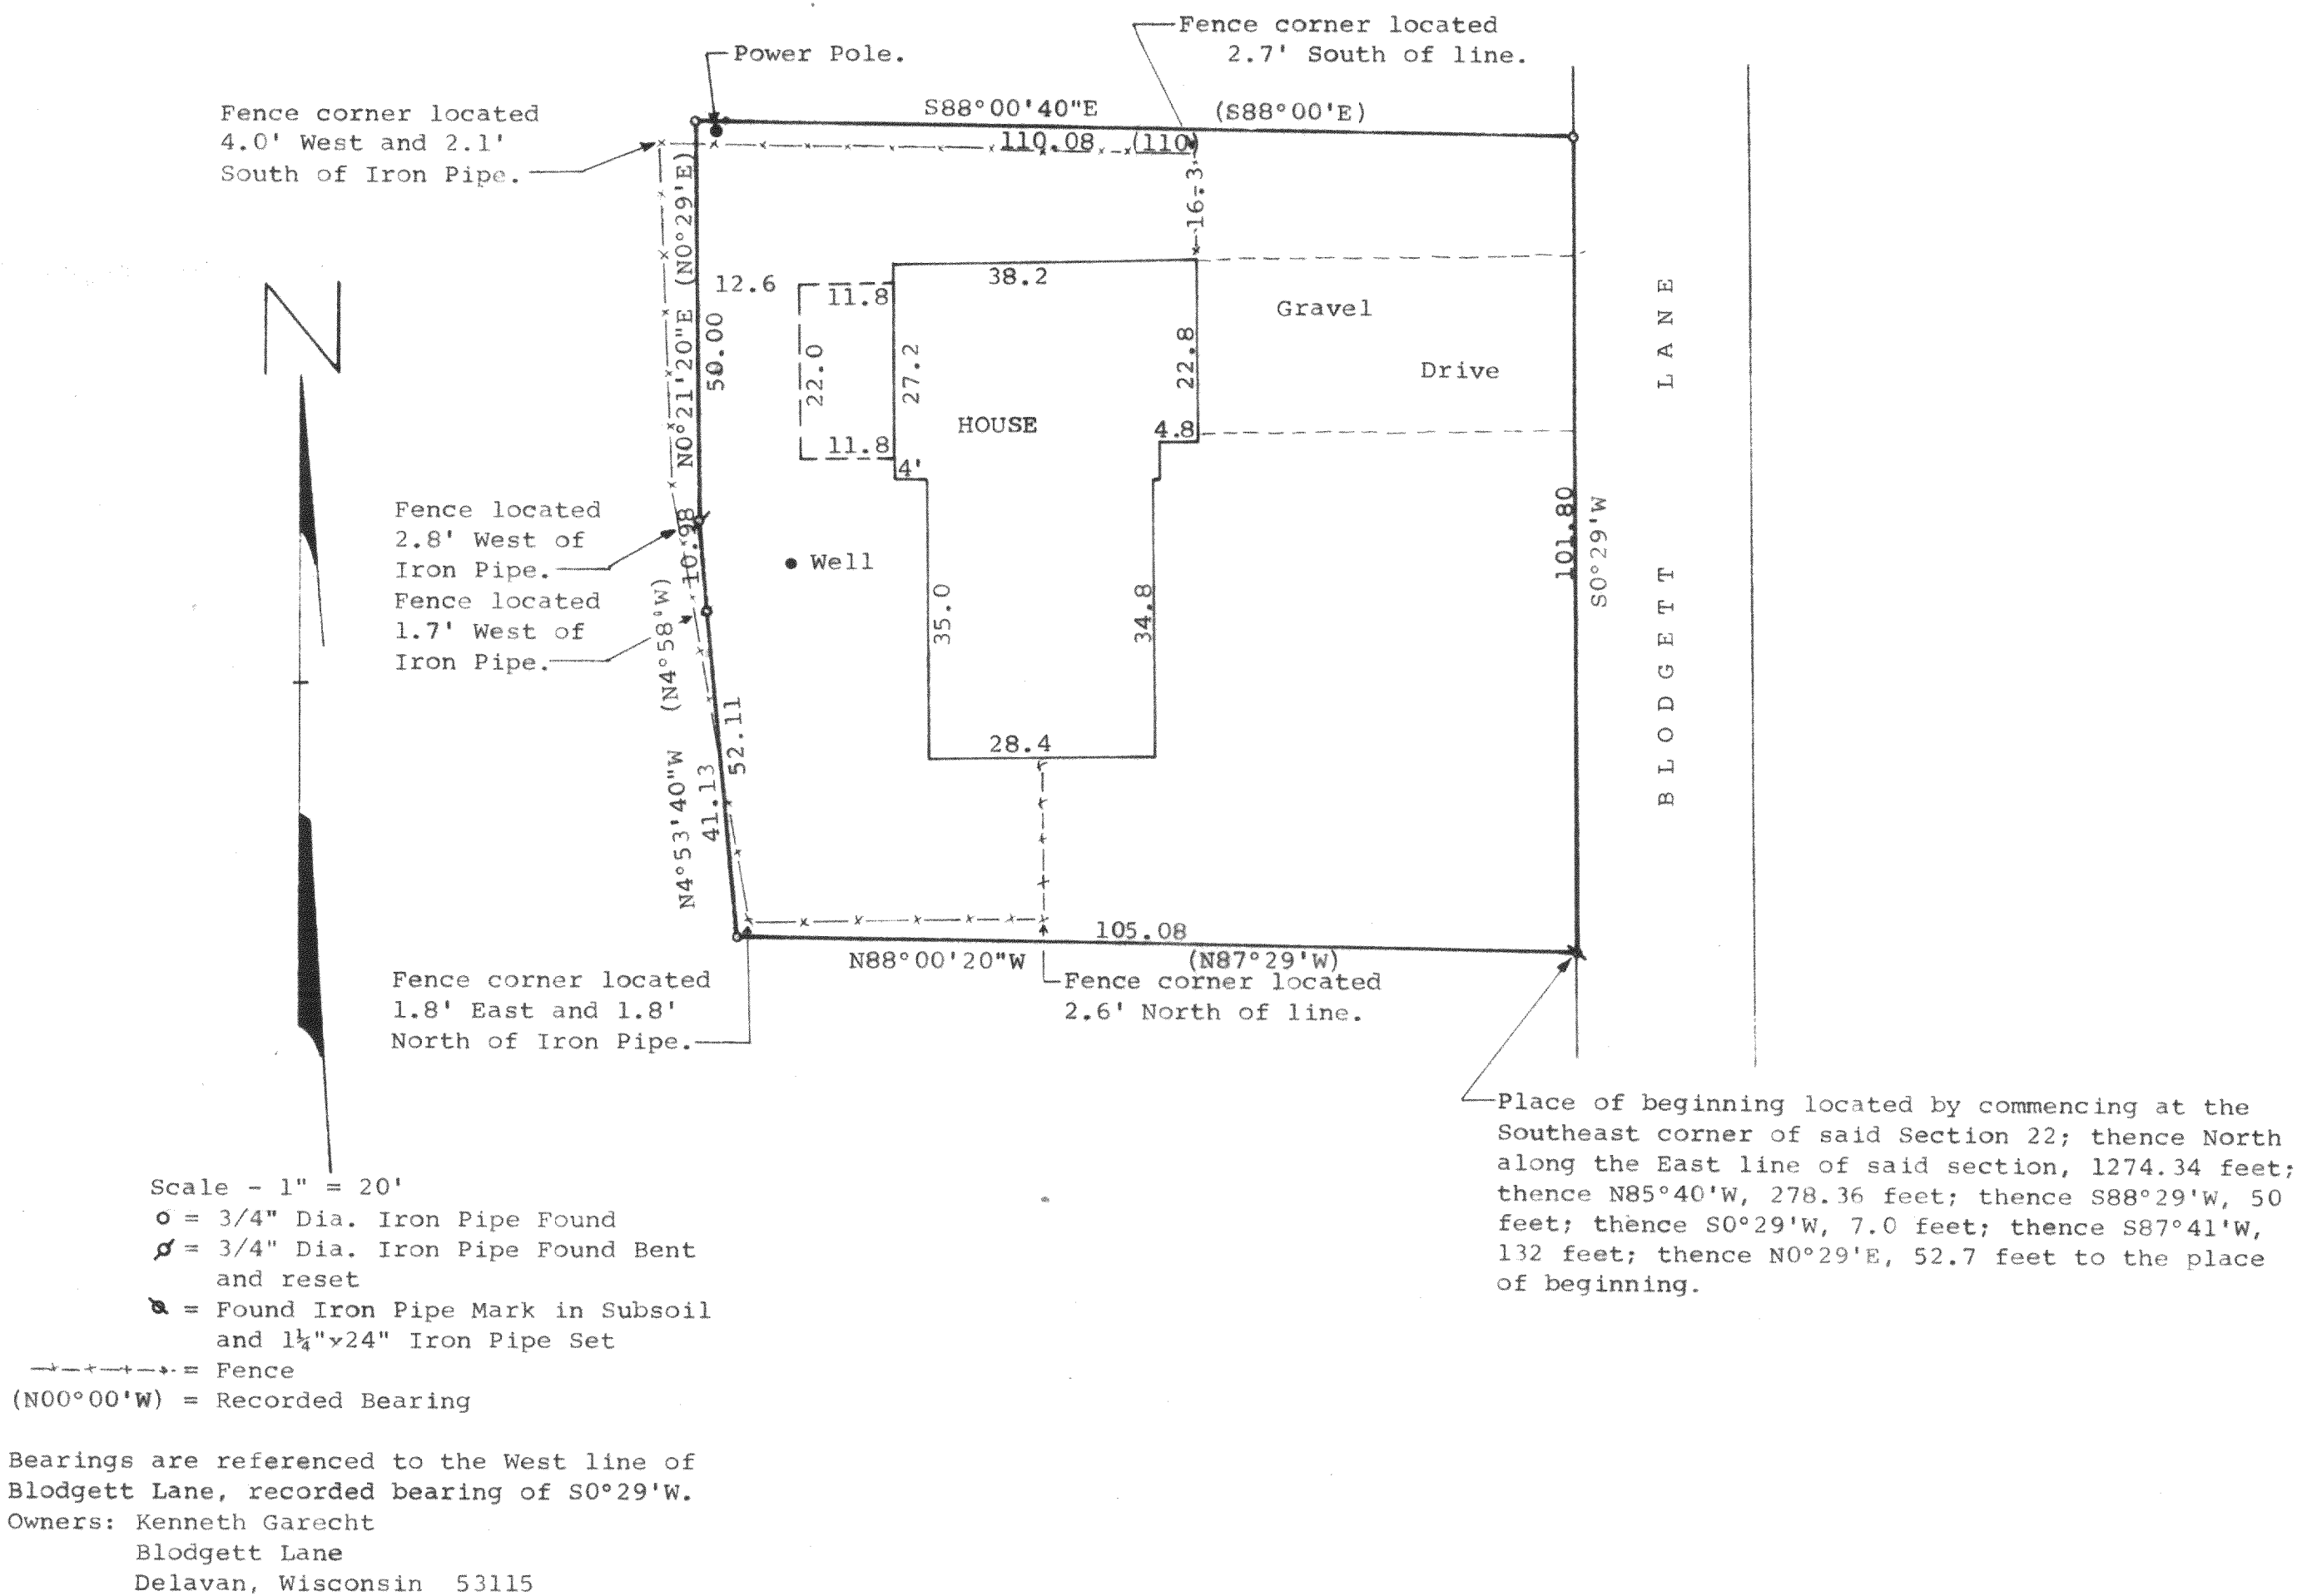

STATE OF WISCONSIN) SS
 COUNTY OF WALWORTH)

I, George T. Dunham, Surveyor, certify that I have surveyed the property described as follows,

A parcel of land located in the Southeast Fractional 1/4 of Fractional Section 22, T2N, R16E, Walworth County, Wisconsin described as follows: Commencing at the Southeast corner of said Section 22; thence North along the East line of said Section, 1274.34 feet to a point; thence N85°40'W, 278.36 feet to a point; thence S88°29'W, 50 feet; thence S0°29'W, 7.0 feet; thence S87°41'W, 132 feet; thence N0°29'E, 52.7 feet to the place of beginning; thence N88°00'20"W (recorded as N87°29'W), 105.08 feet; thence N4°53'40"W (recorded as N4°58'W), 52.11 feet; thence N0°21'20"E (recorded as N0°29'E), 50.00 feet; thence S88°00'40"E, 110.08 feet (recorded as S88°00'E, 110.00 feet); thence S0°29'W, 101.80 feet to the place of beginning.

and that the plat shown above is a true representation thereof and shows the size and location of the property, its exterior boundaries, the location of boundary fences, apparent easements, roadways and visible encroachments, if any, and that I have surveyed the property hereon described according to the official records to the best of my knowledge and belief.

March 27, 1984.

George T. Dunham
 George T. Dunham, Surveyor

