


FARRIS, HANSEN & ASSOCIATES
ELKHORN, WI
PLAT OF SURVEY

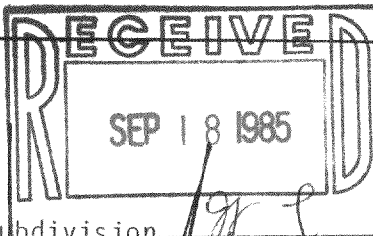

Lots 6 & 7, Block 16, Delavan Lake - View Crest, a Subdivision
located in Section 31, T2N, R16E, Town of Delavan
Walworth County, Wisconsin

ORDERED BY:
NANETTE NICOLAY

EXISTING BK. TP. ROAD
(NOTE: CONNECTS TO PUBLIC ROADWAY SYSTEM)
STATUS OF TITLE TO THIS
ROAD AS ACCESS TO LOTS 6 & 7
BLOCK 16 UNKNOWN

1" = 20'



LOT 29


BLOCK 13

LOT 30

LOT 31


SILVERWOOD DR.

I hereby certify that I have surveyed the above
described property and that the above map is a true
representation thereof and shows the size and
location of the property, its exterior boundaries,
the location of all visible structures and
dimensions of all principal buildings thereon,
boundary fences, apparent easements, roadways and
visible encroachments, if any.
This survey is made for the use of the present
owners of the property, and also those who purchase,
mortgage, or guarantee the title thereto within one
(1) year from the date hereof.

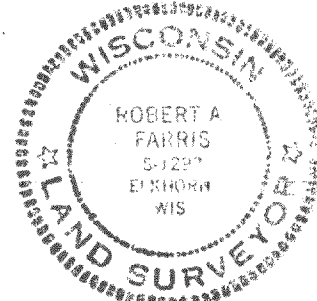

50' ROW
UNIMPROVED

Robert A. Farris 8/6/85

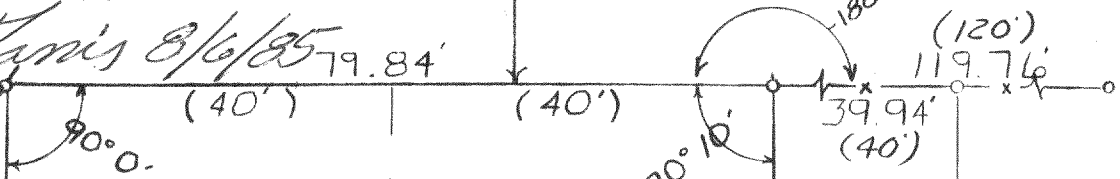

BLOCK 16

UNIMPROVED LOTS

LOT 8

LOT 7

LOT 6

LOT 5

LEGEND

- o = IRON PIPE FOUND
- = IRON PIPE SET
- x — = FENCE
- (xxx) = RECORD DIMENSION

UTILITY POLE

OVERHEAD WIRFS
ALONG LOT LINE

PROJECT #2450